


5515

P. 221-23

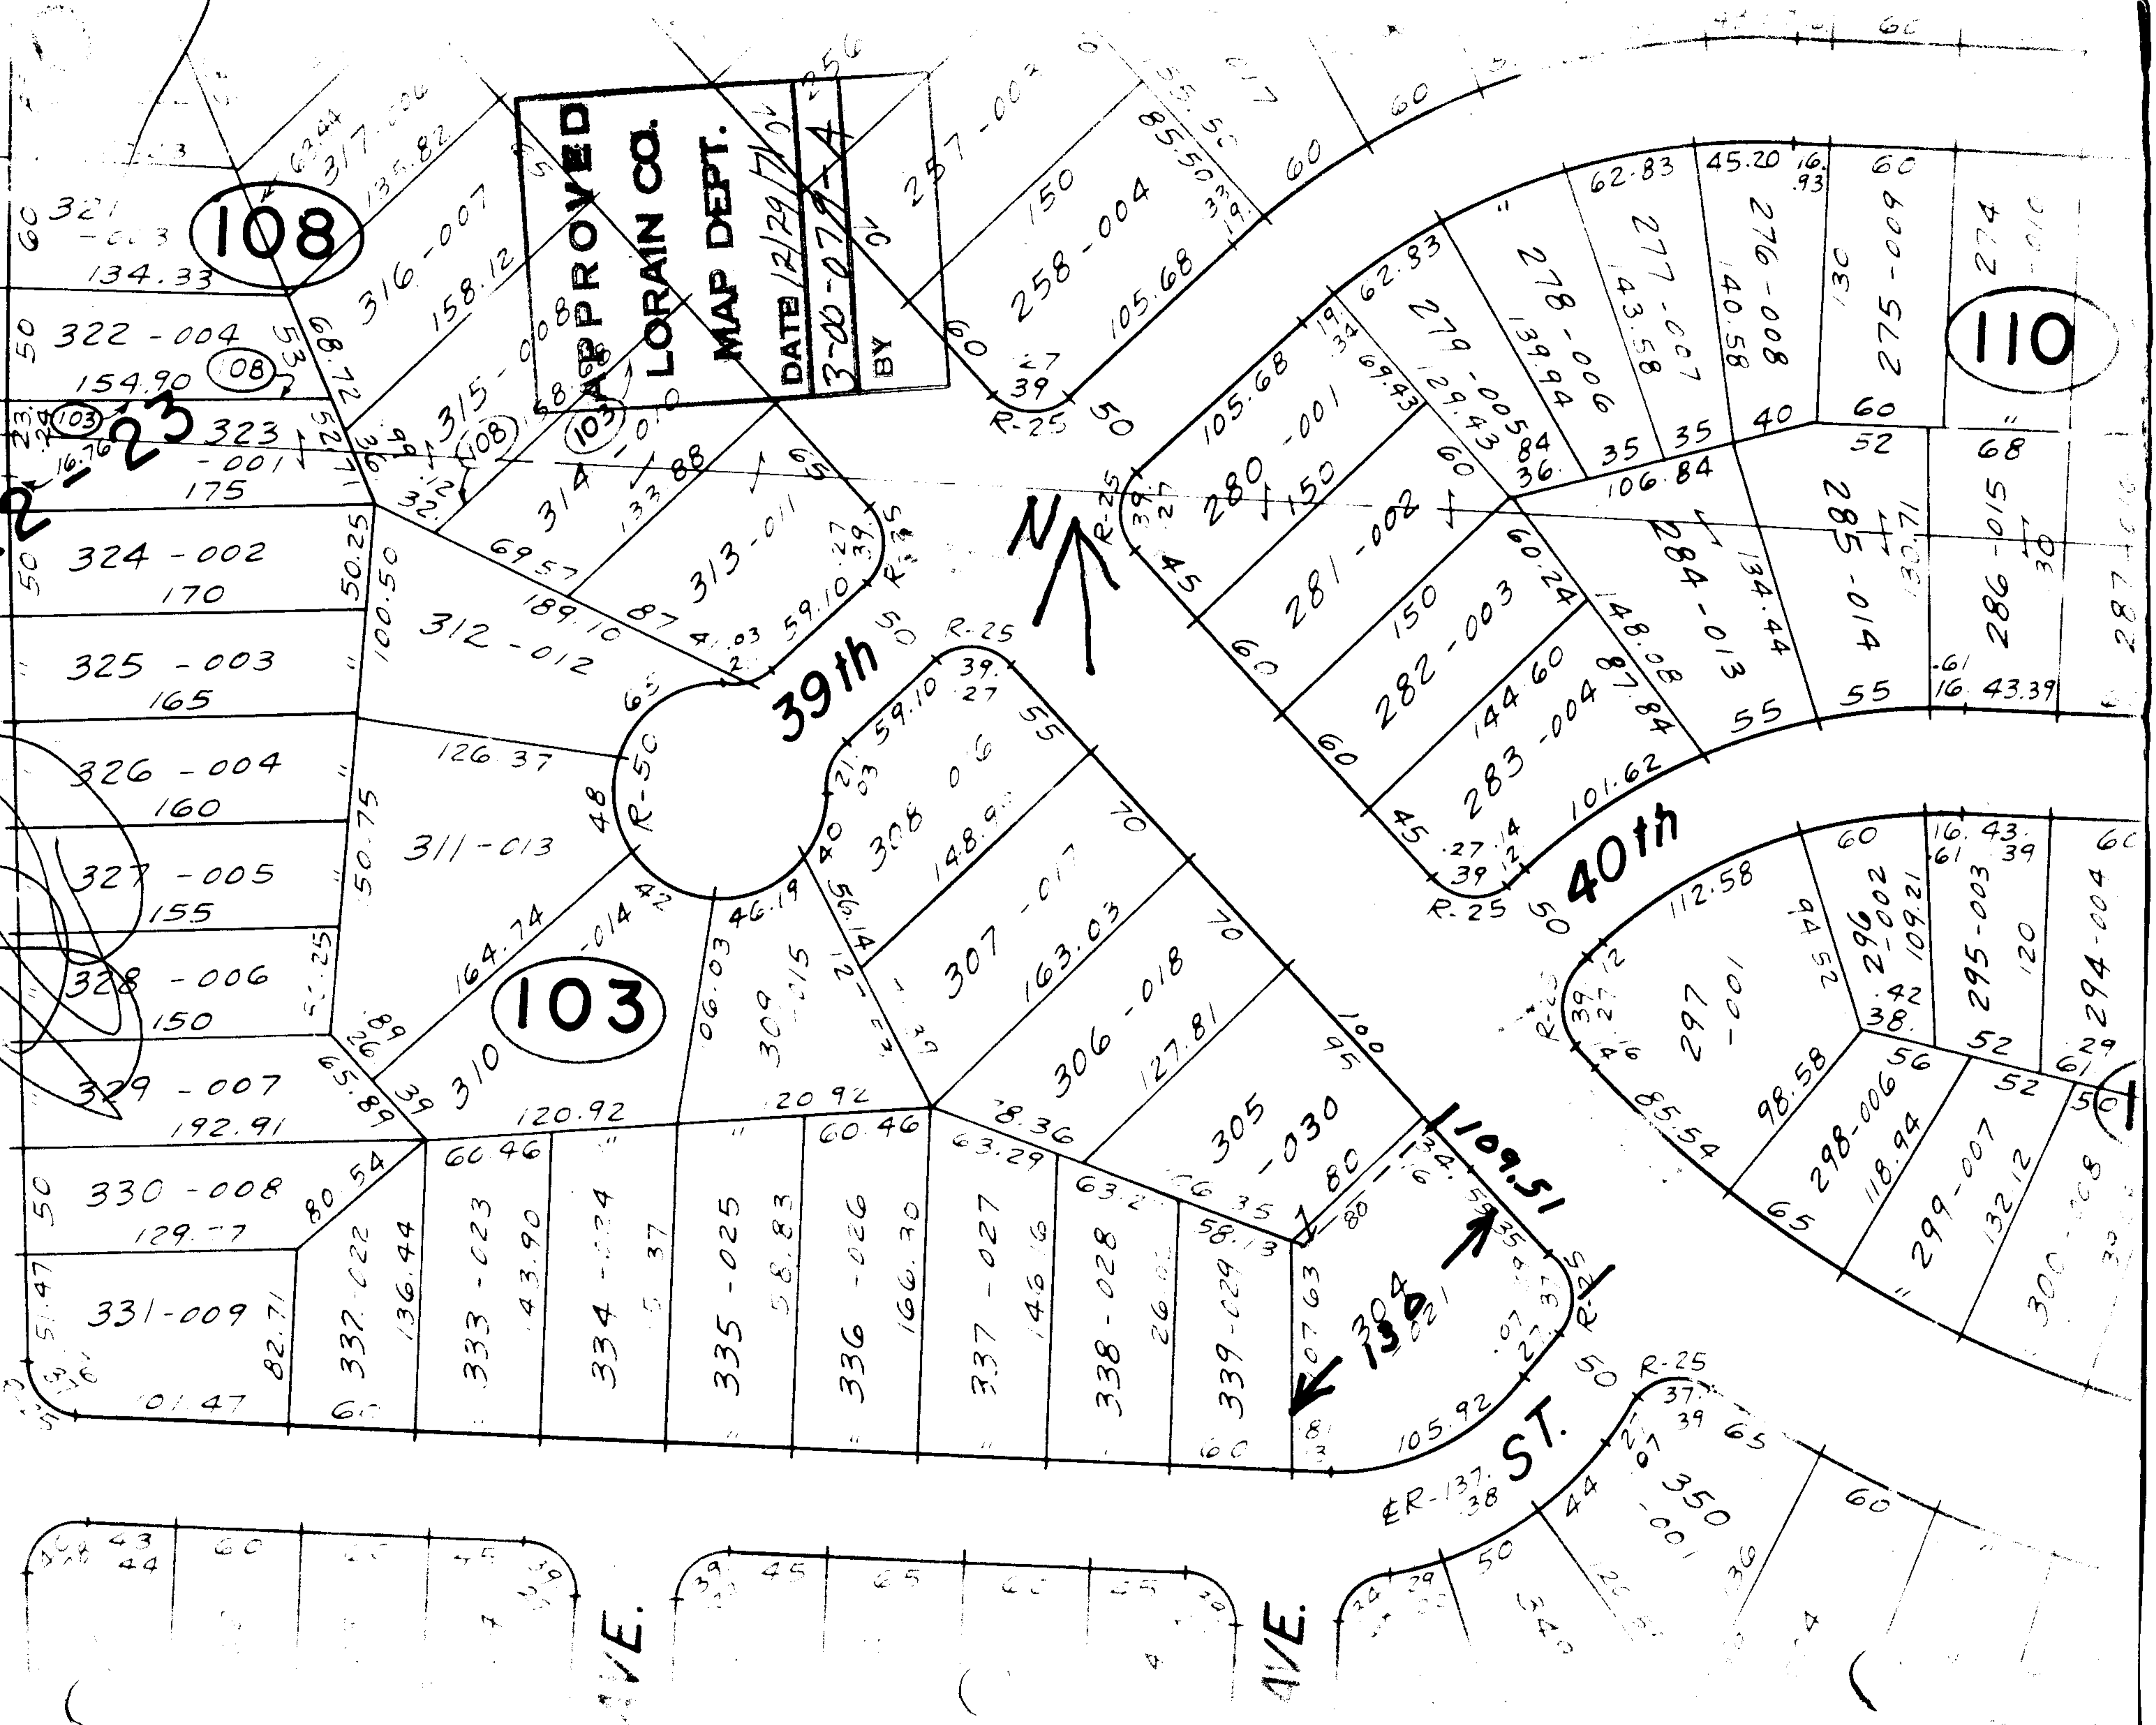

108

108

103

103

110

APPROVED
 LORAIN CO.
 MAP DEPT.
 DATE 12/29/70
 BY 3-00-079-A
 256

39th

40th



AVE.

AVE.