5530

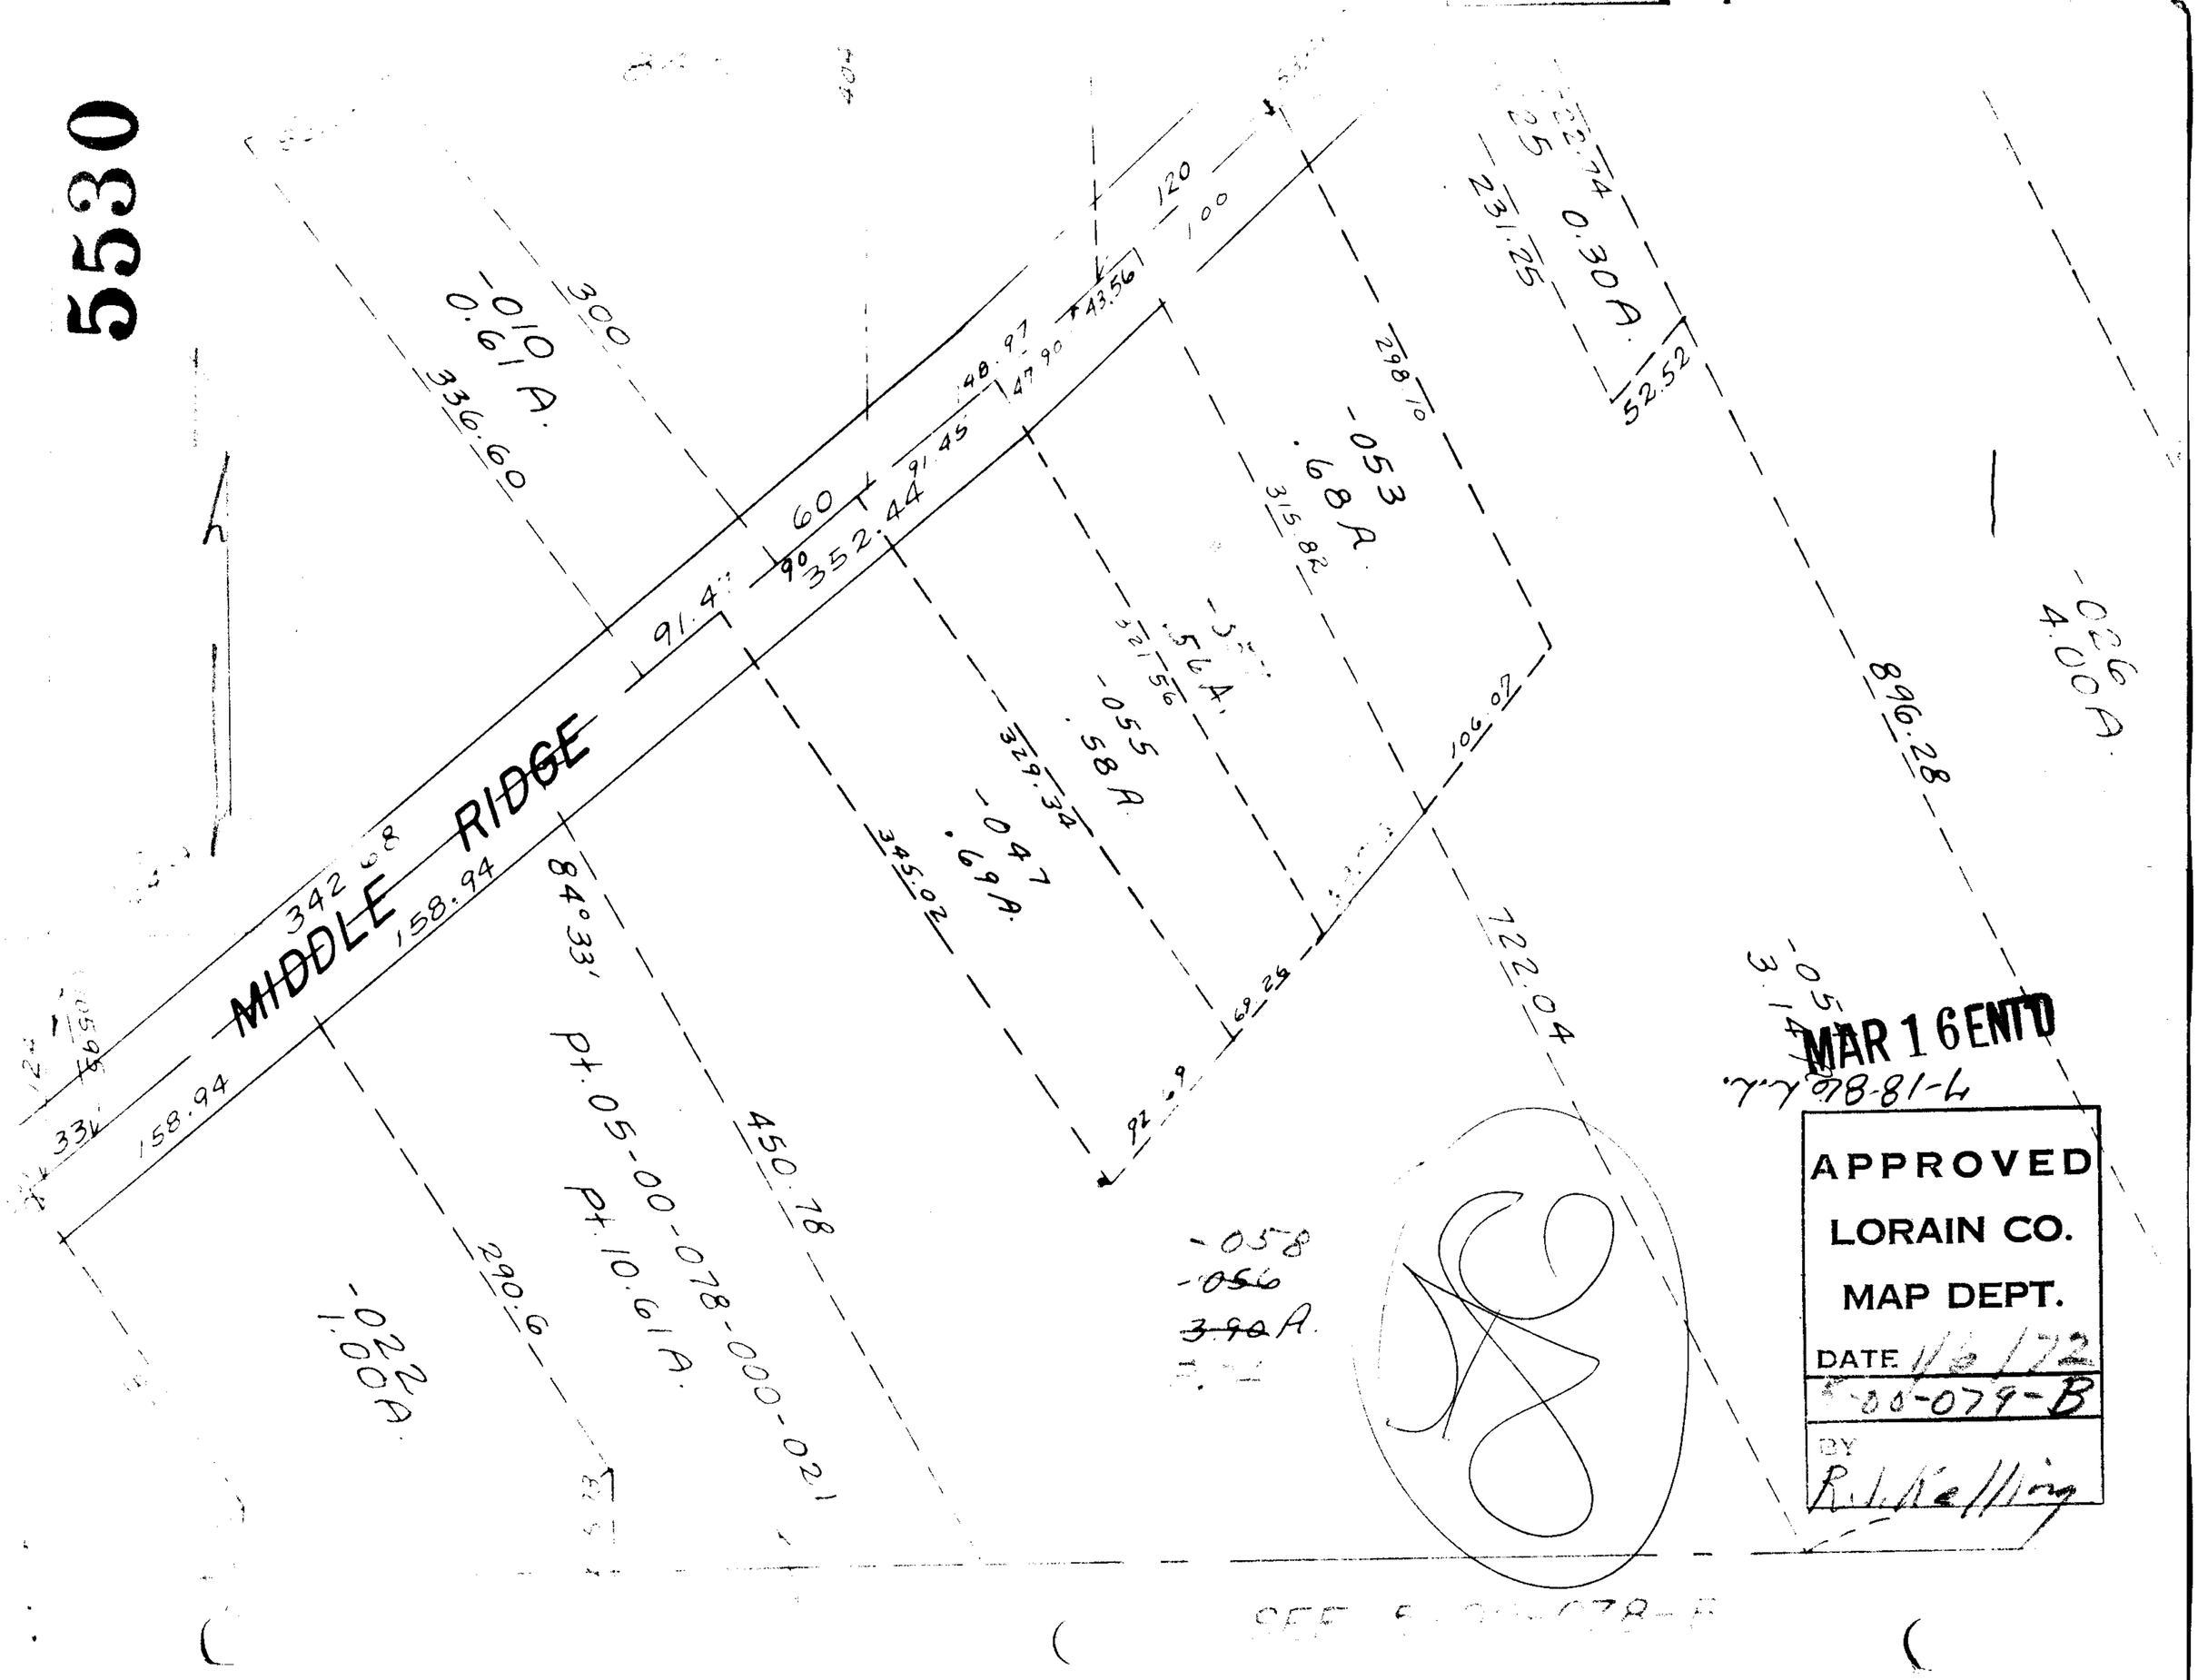

MAR 16 ENT'D

APPROVED
LORAIN CO.
MAP DEPT.
DATE 1/6/72
5-00-079-B
BY R. J. Kelling