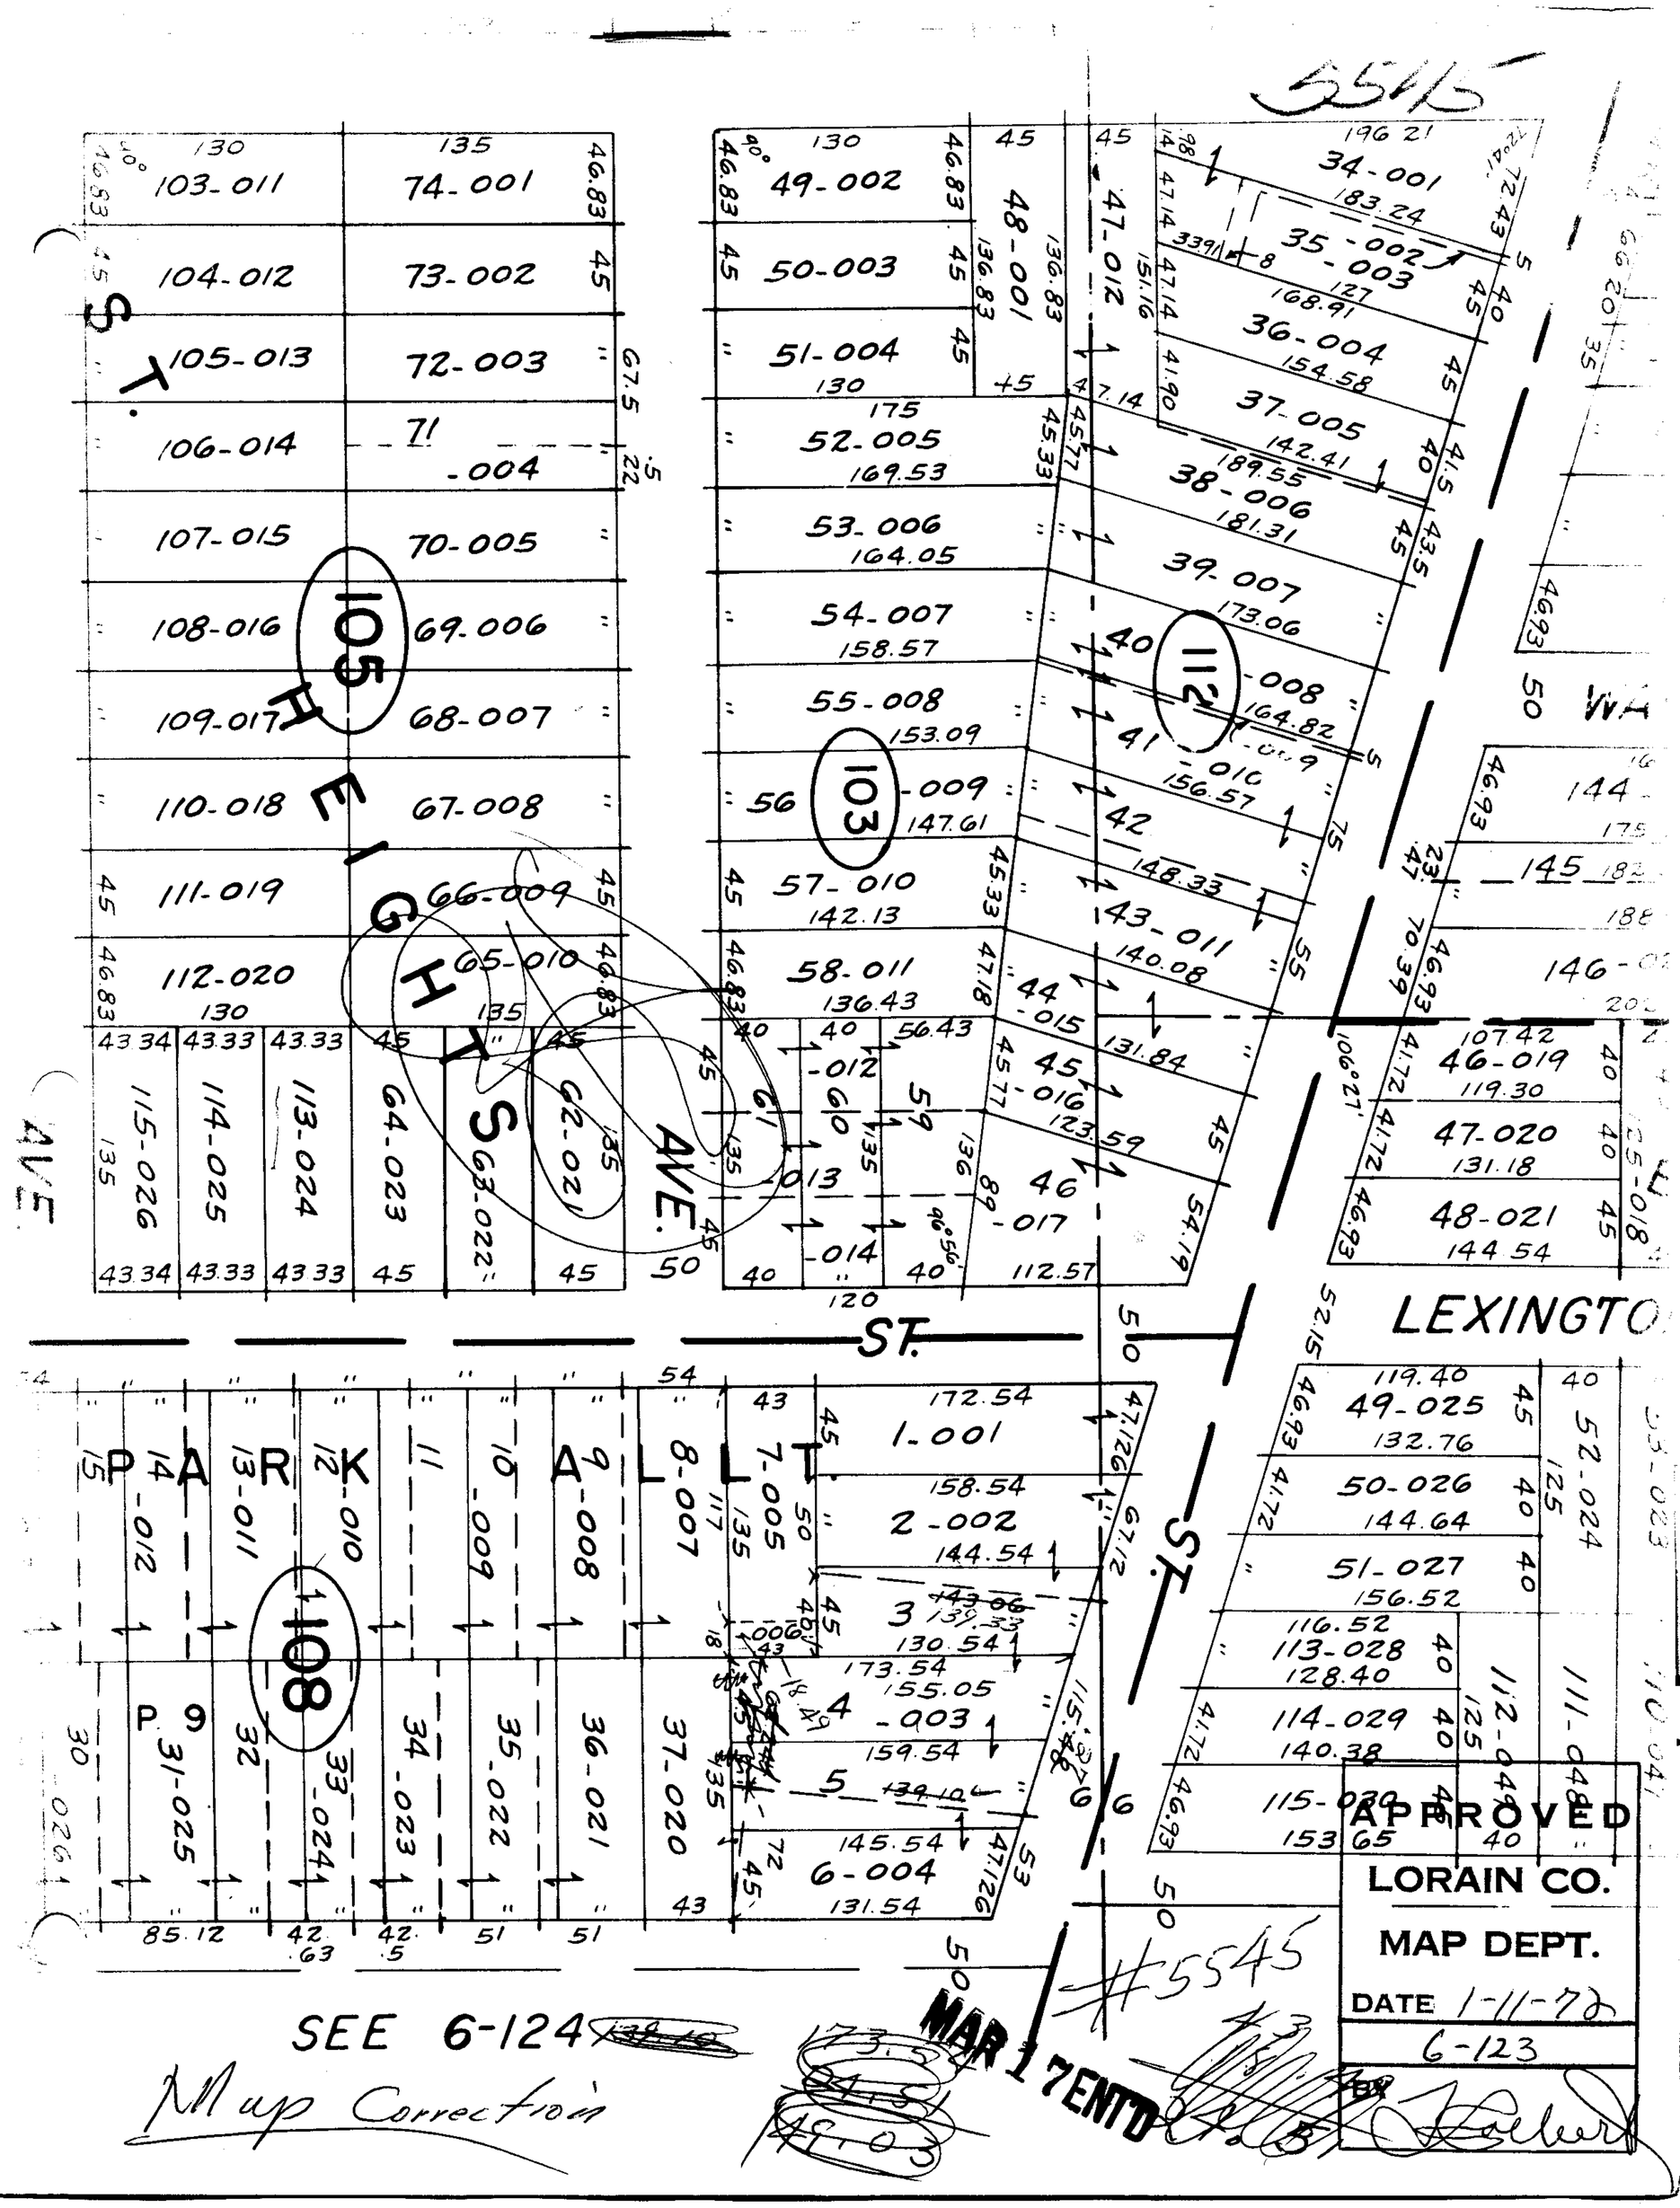

5545
ST.
HEIGHTS
AVE.
PARK ALLT
LEXINGTO
105
103
112
108
103-011
104-012
105-013
106-014
107-015
108-016
109-017
110-018
111-019
112-020
74-001
73-002
72-003
71-004
70-005
69-006
68-007
67-008
66-009
65-010
49-002
50-003
51-004
52-005
53-006
54-007
55-008
56-009
57-010
58-011
34-001
35-002
36-004
37-005
38-006
39-007
40-008
41-010
42
43-011
44-015
45-016
46-017
46-019
47-020
48-021
49-025
50-026
51-027
113-028
114-029
115-030
1-001
2-002
3
4-003
5
6-004
7-005
8-007
9-008
10-009
11
12-010
13-011
14-012
31-025
32
33-024
34-023
35-022
36-021
37-020
SEE 6-124
Map Correction
MAR 17 ENT'D
#5545
APPROVED
LORAIN CO.
MAP DEPT.
DATE 1-11-72
6-123
BY