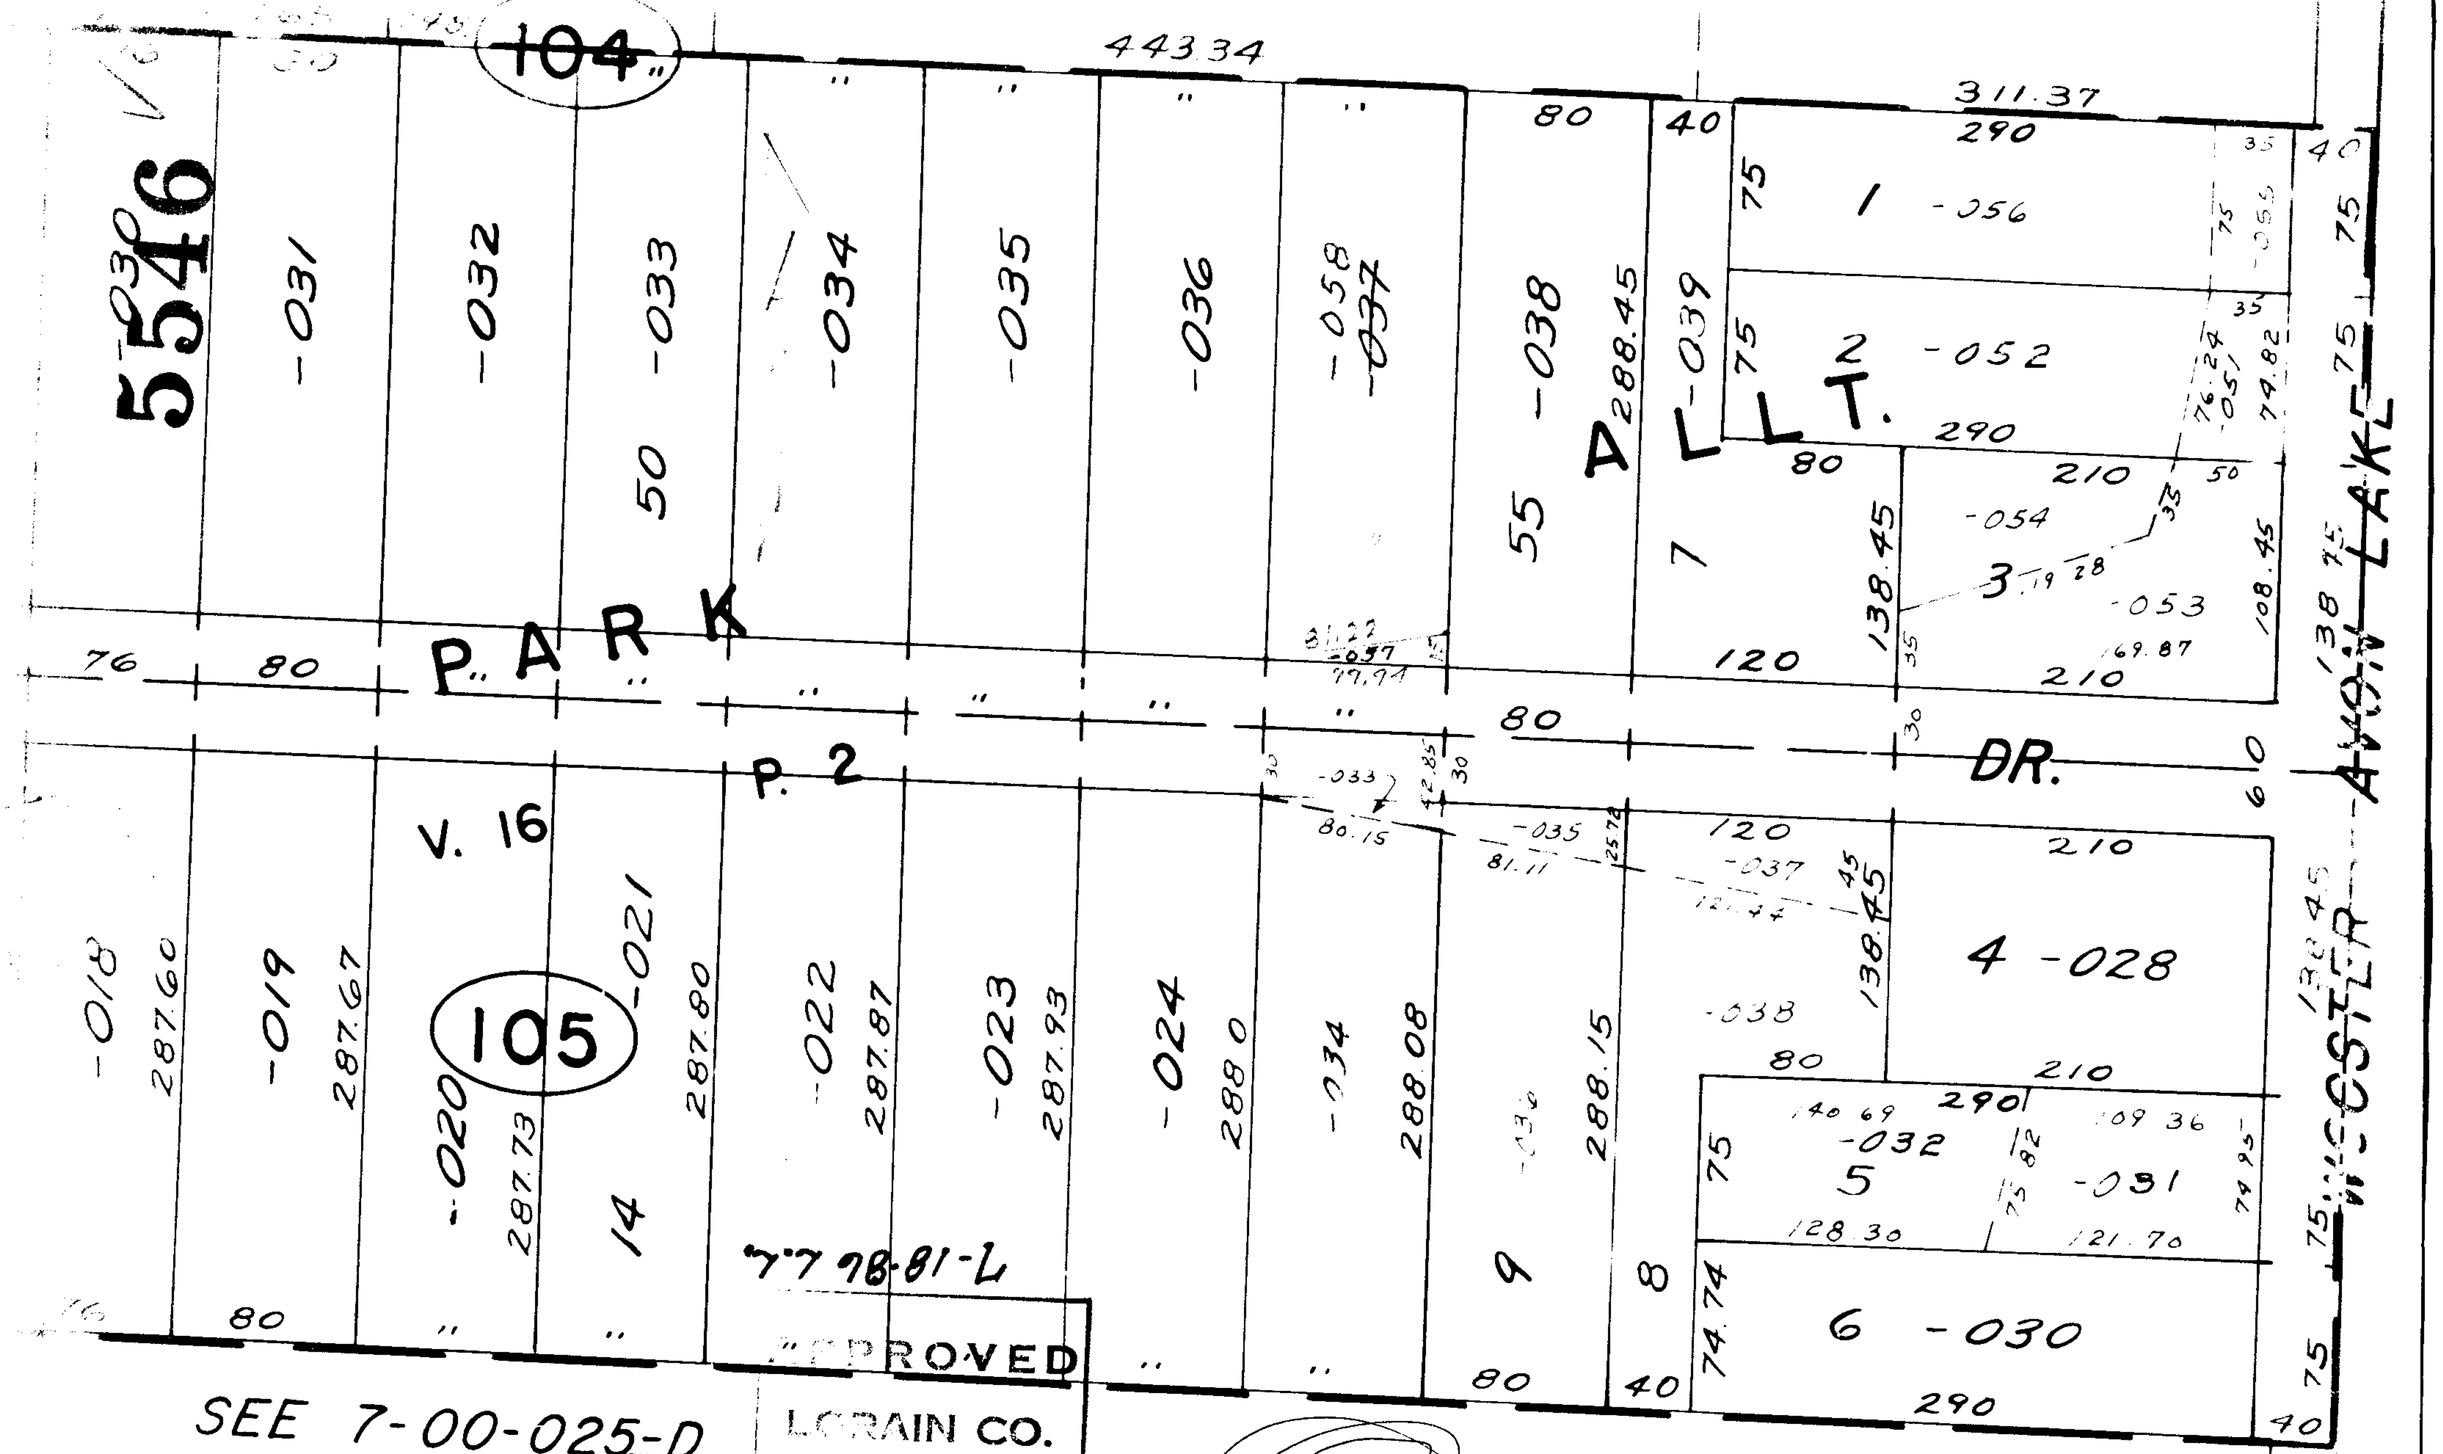


SEE 7-00-025-D

APPROVED
LORAIN CO.
DEPT.
7-00-025-B

MAR 17 ENT'D