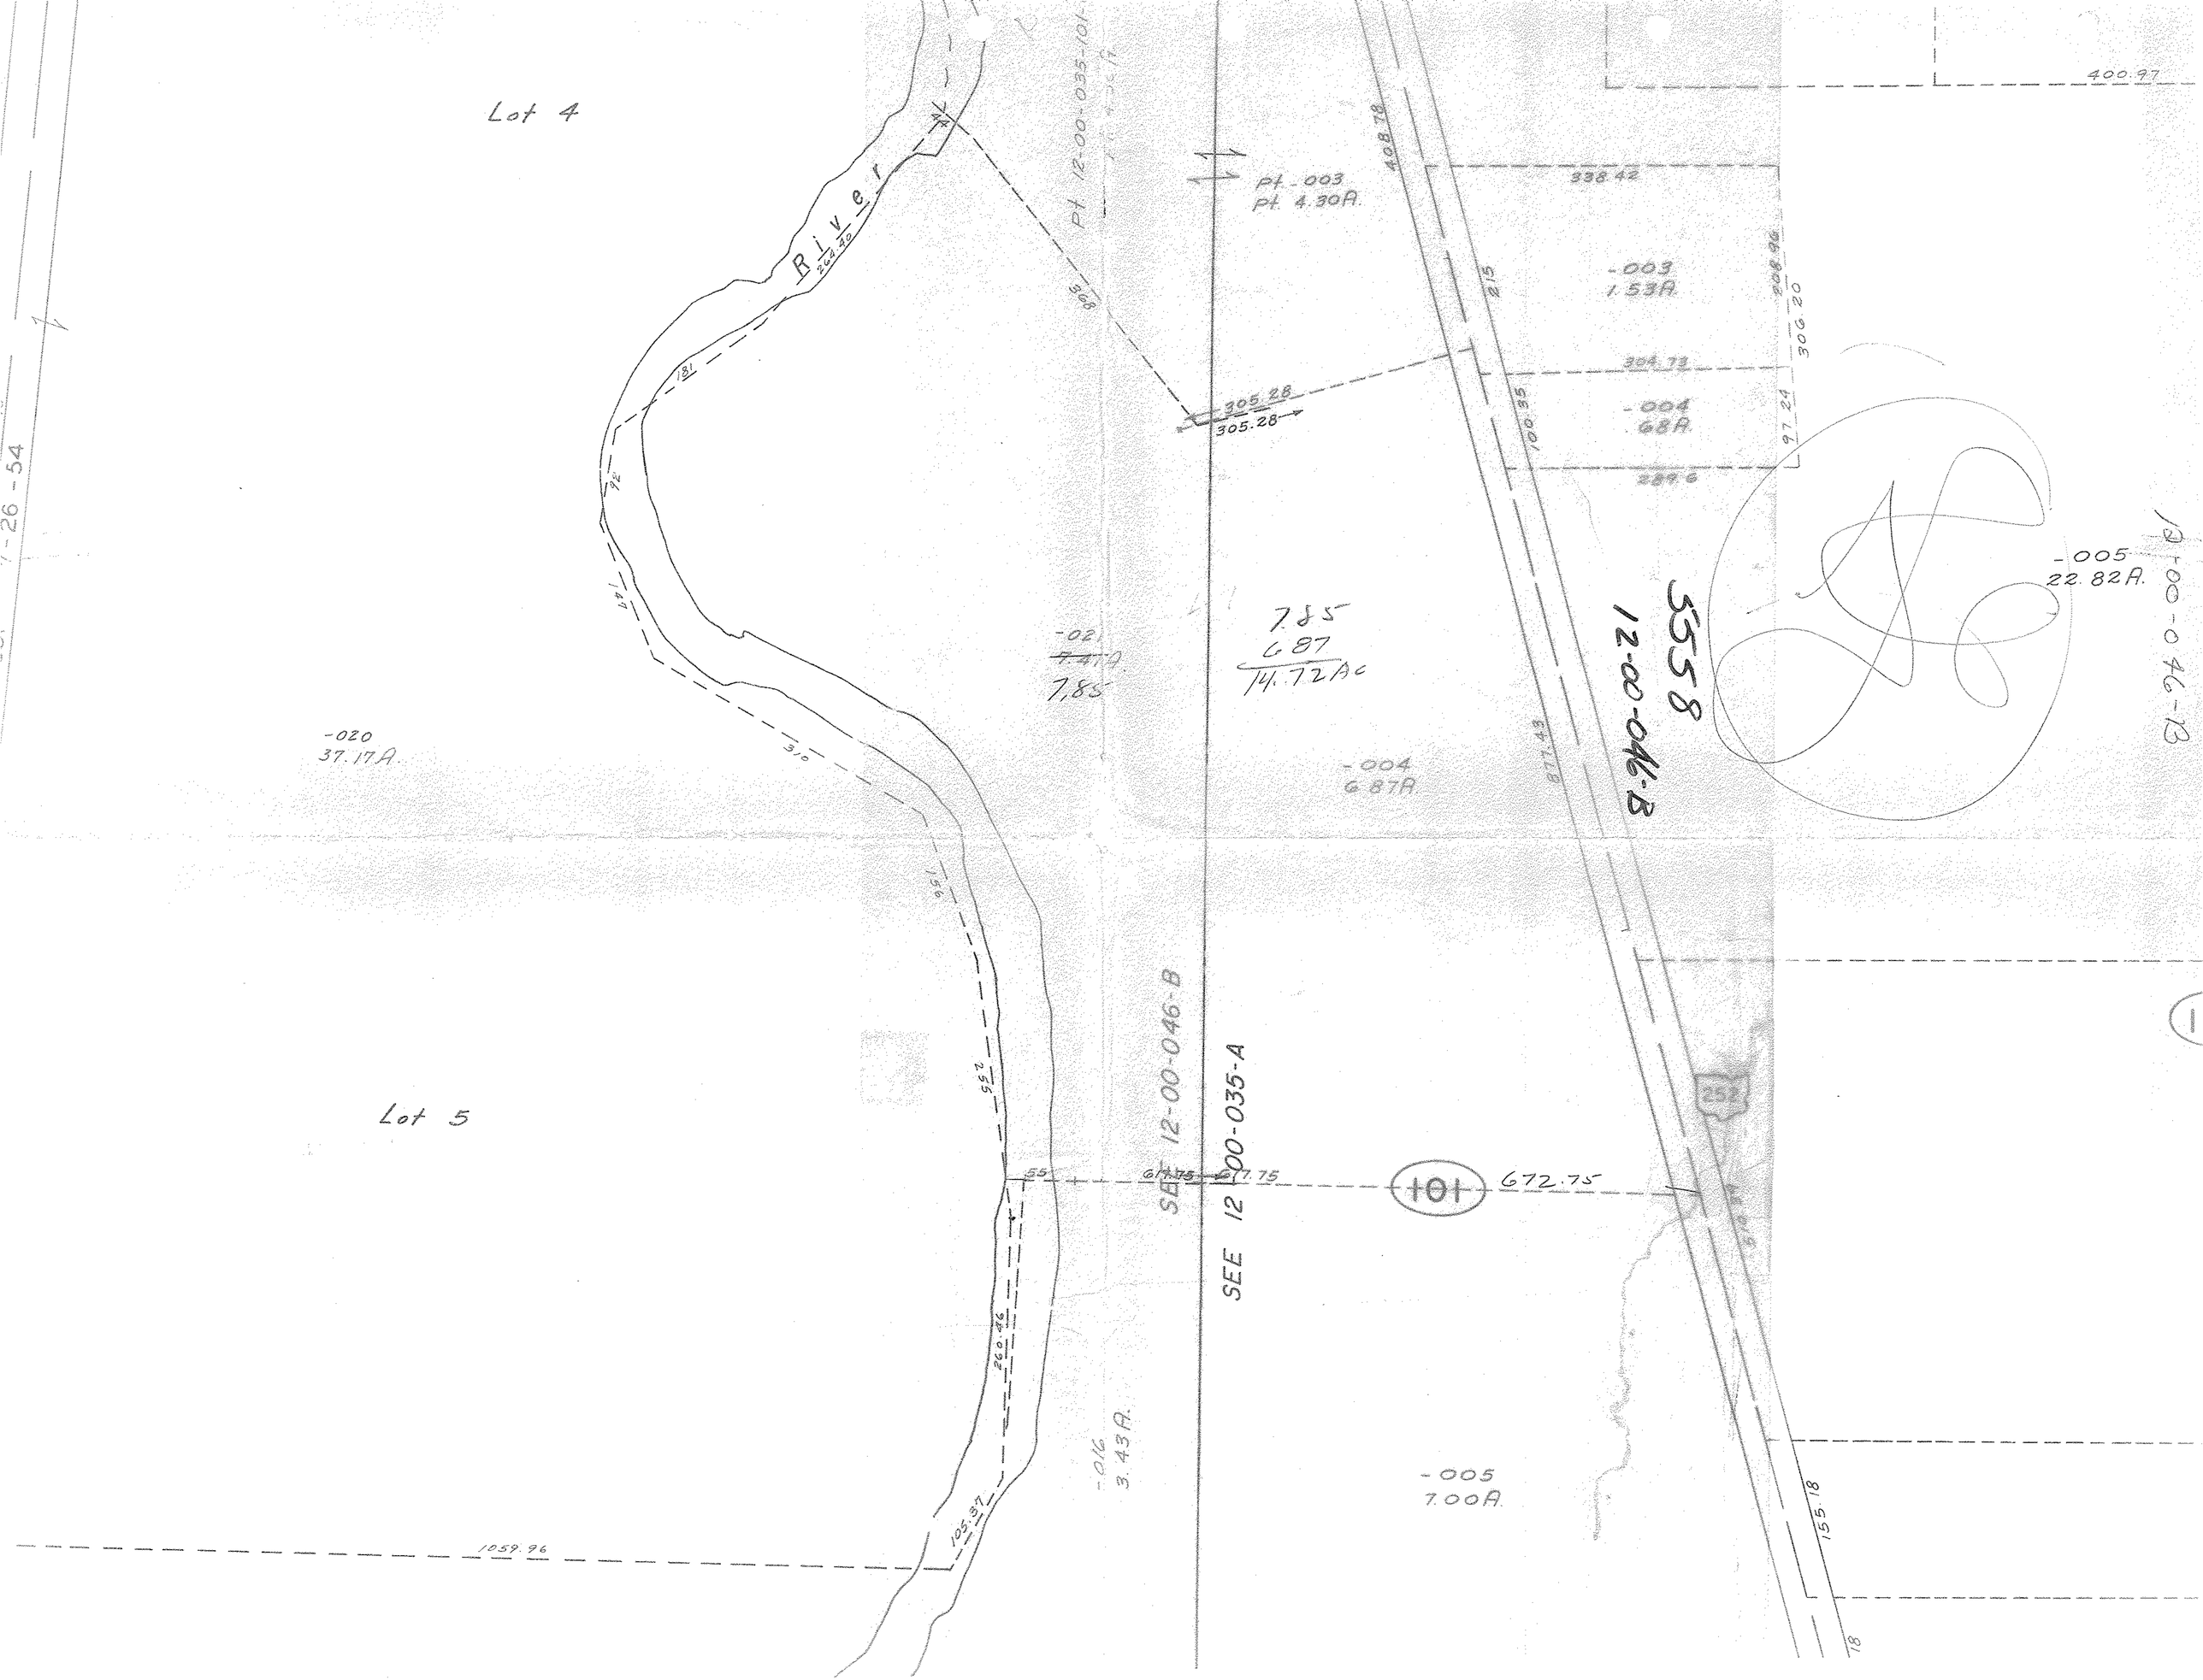

Lot 4
River
Pt. 12-00-035-101
Pt. -003
Pt. 4.30A.
400.97
338.42
-003
1.53A.
304.73
-004
.68A.
305.28
305.28
-005
22.82A.
5558
12-00-046-B
7.85
6.87
14.72Ac
-021
7.85
-020
37.17A.
-004
6.87A.
Lot 5
SEE 12-00-046-B
SEE 12-00-035-A
672.75
101
-016
3.43A.
-005
7.00A.
1059.96
155.18