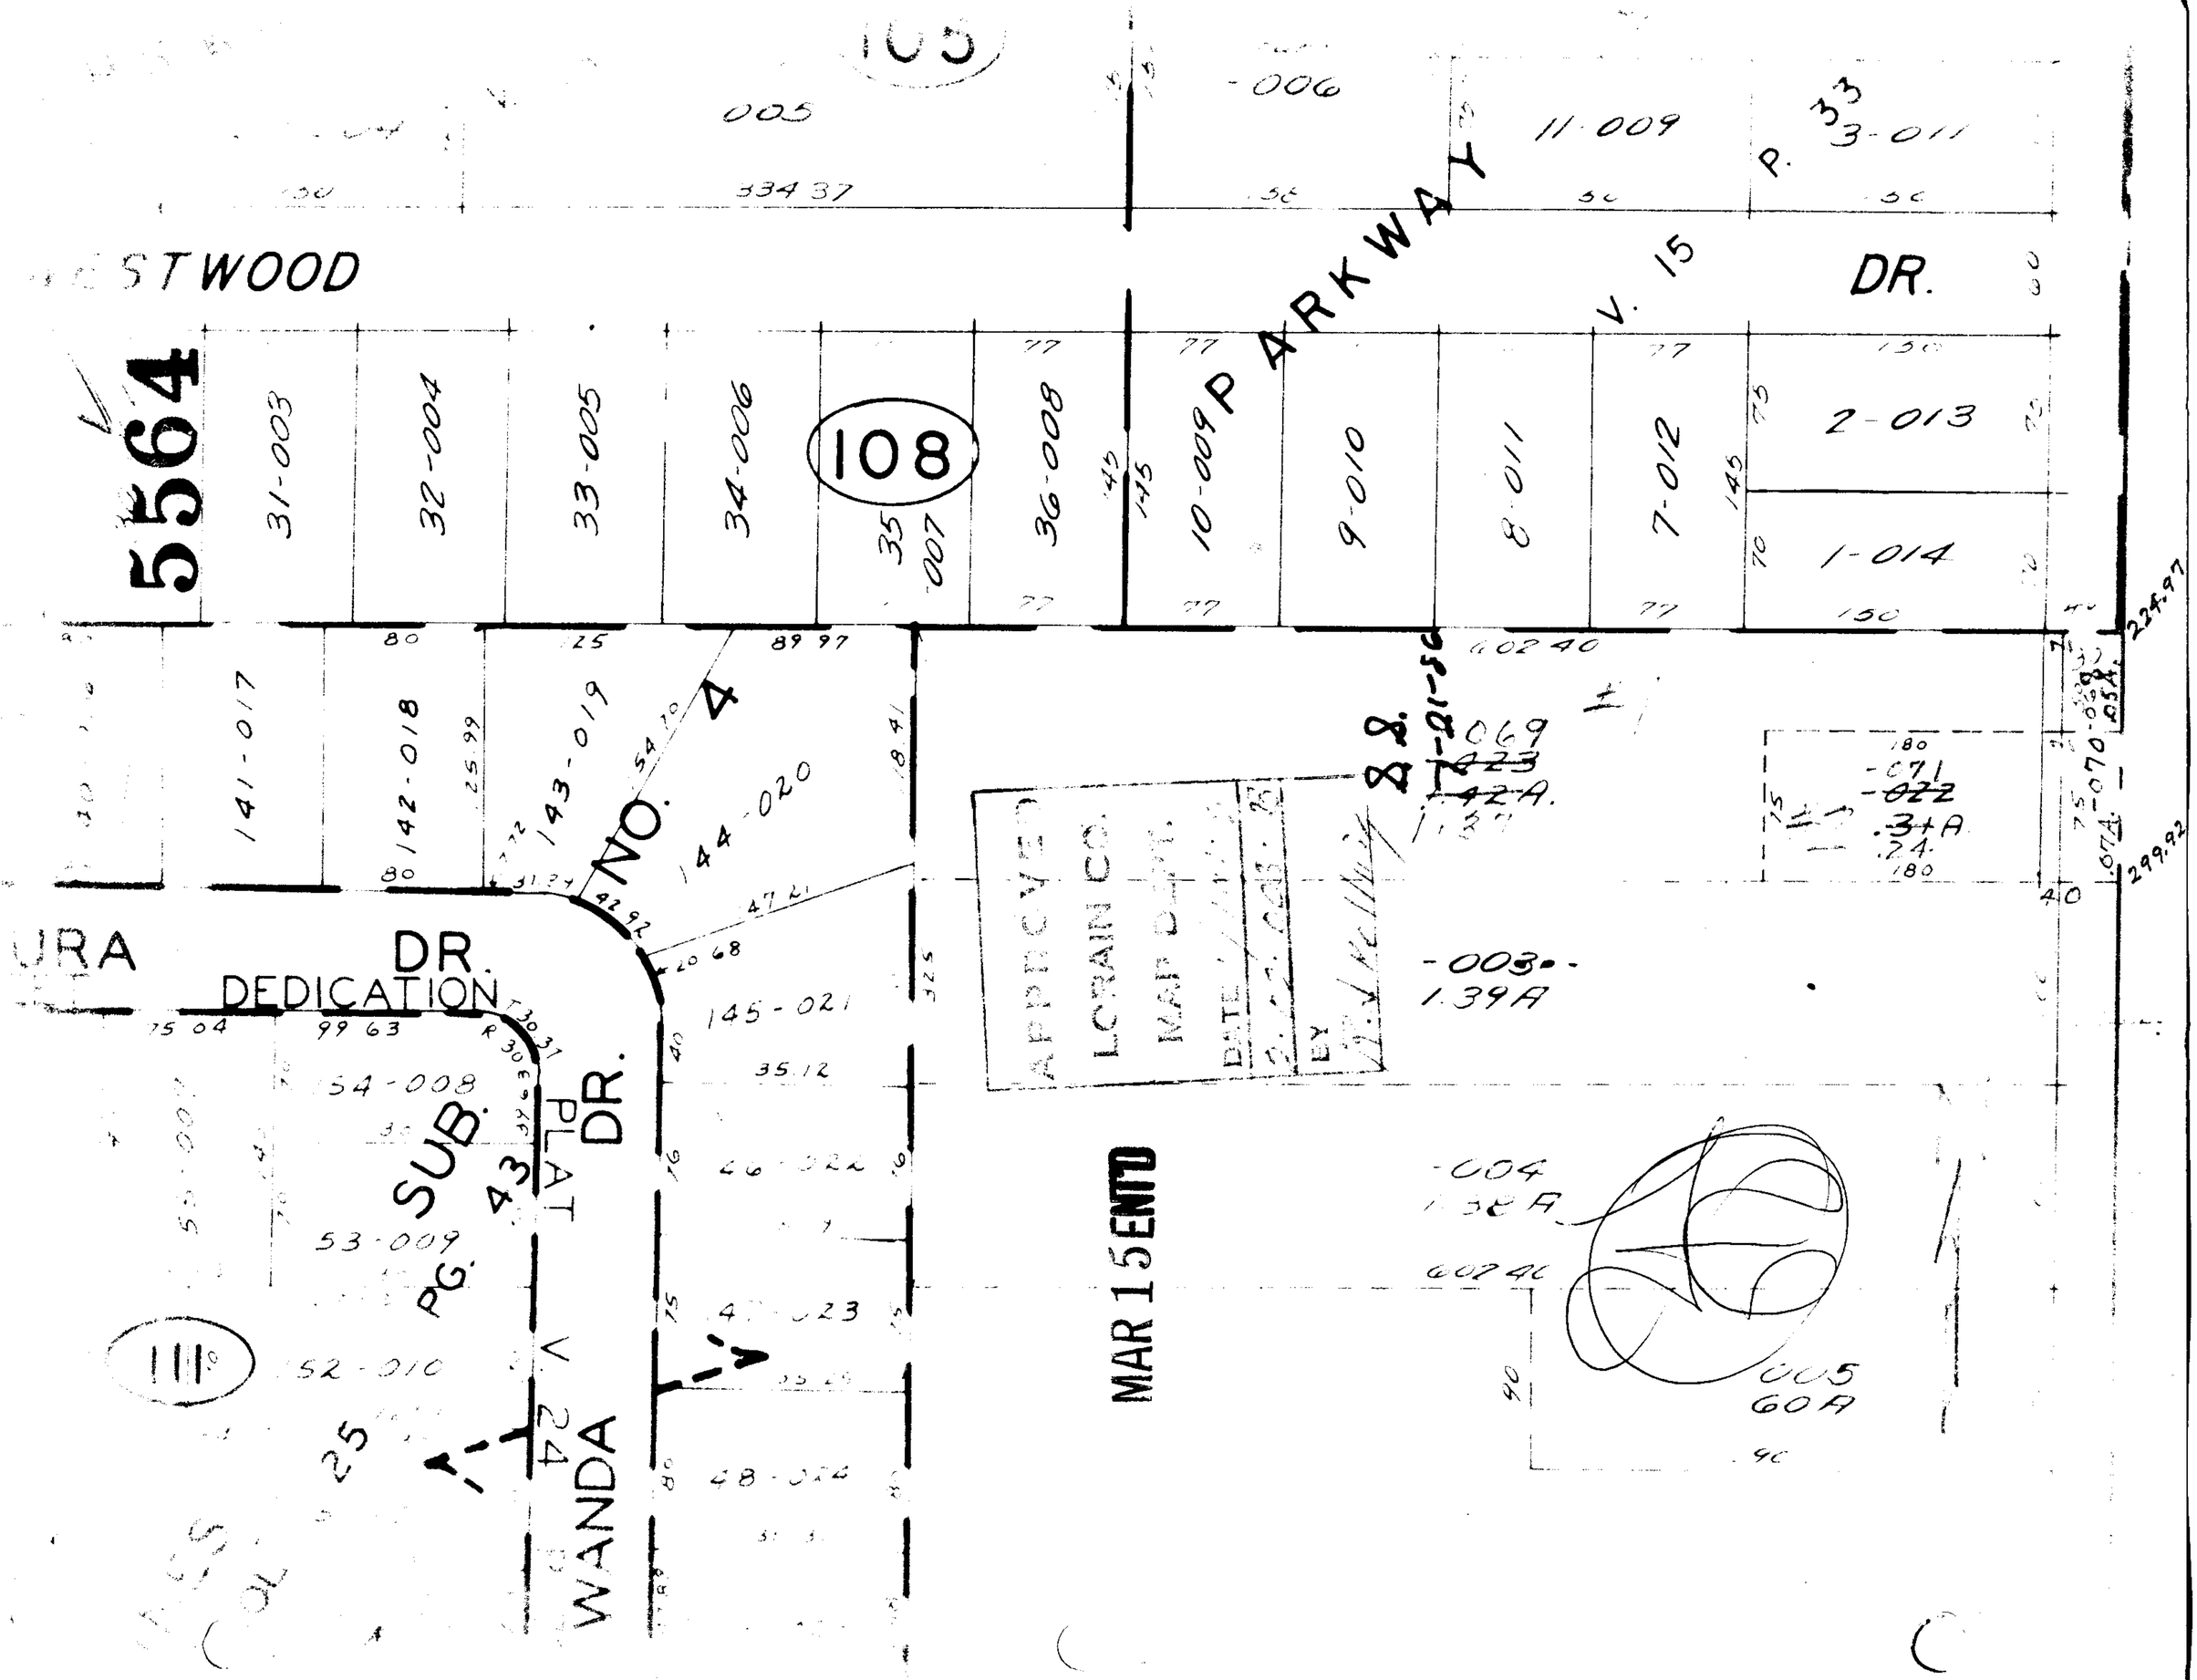

105
005
-006
11-009
P. 33
3-011
334 37
STWOOD
DR.
PARKWAY
V. 15
5564
31-003
32-004
33-005
34-006
108
35
-007
36-008
10-009
9-010
8-011
7-012
2-013
1-014
141-017
142-018
143-019
NO. 4
144-020
145-021
DR.
DEDICATION
SUB.
PLAT
43
PG.
V. 24
WANDA
DR.
54-008
53-009
52-010
25
111
-003
1.39A
-004
1.38A
005
60A
MAR 15 ENTD
APPROVED
LORAIN CO.
MAP DEPT.
DATE
BY