

5573

SEE 2

1380.83 To Tower

5784

5680


5841

5804

5703

5574

5840

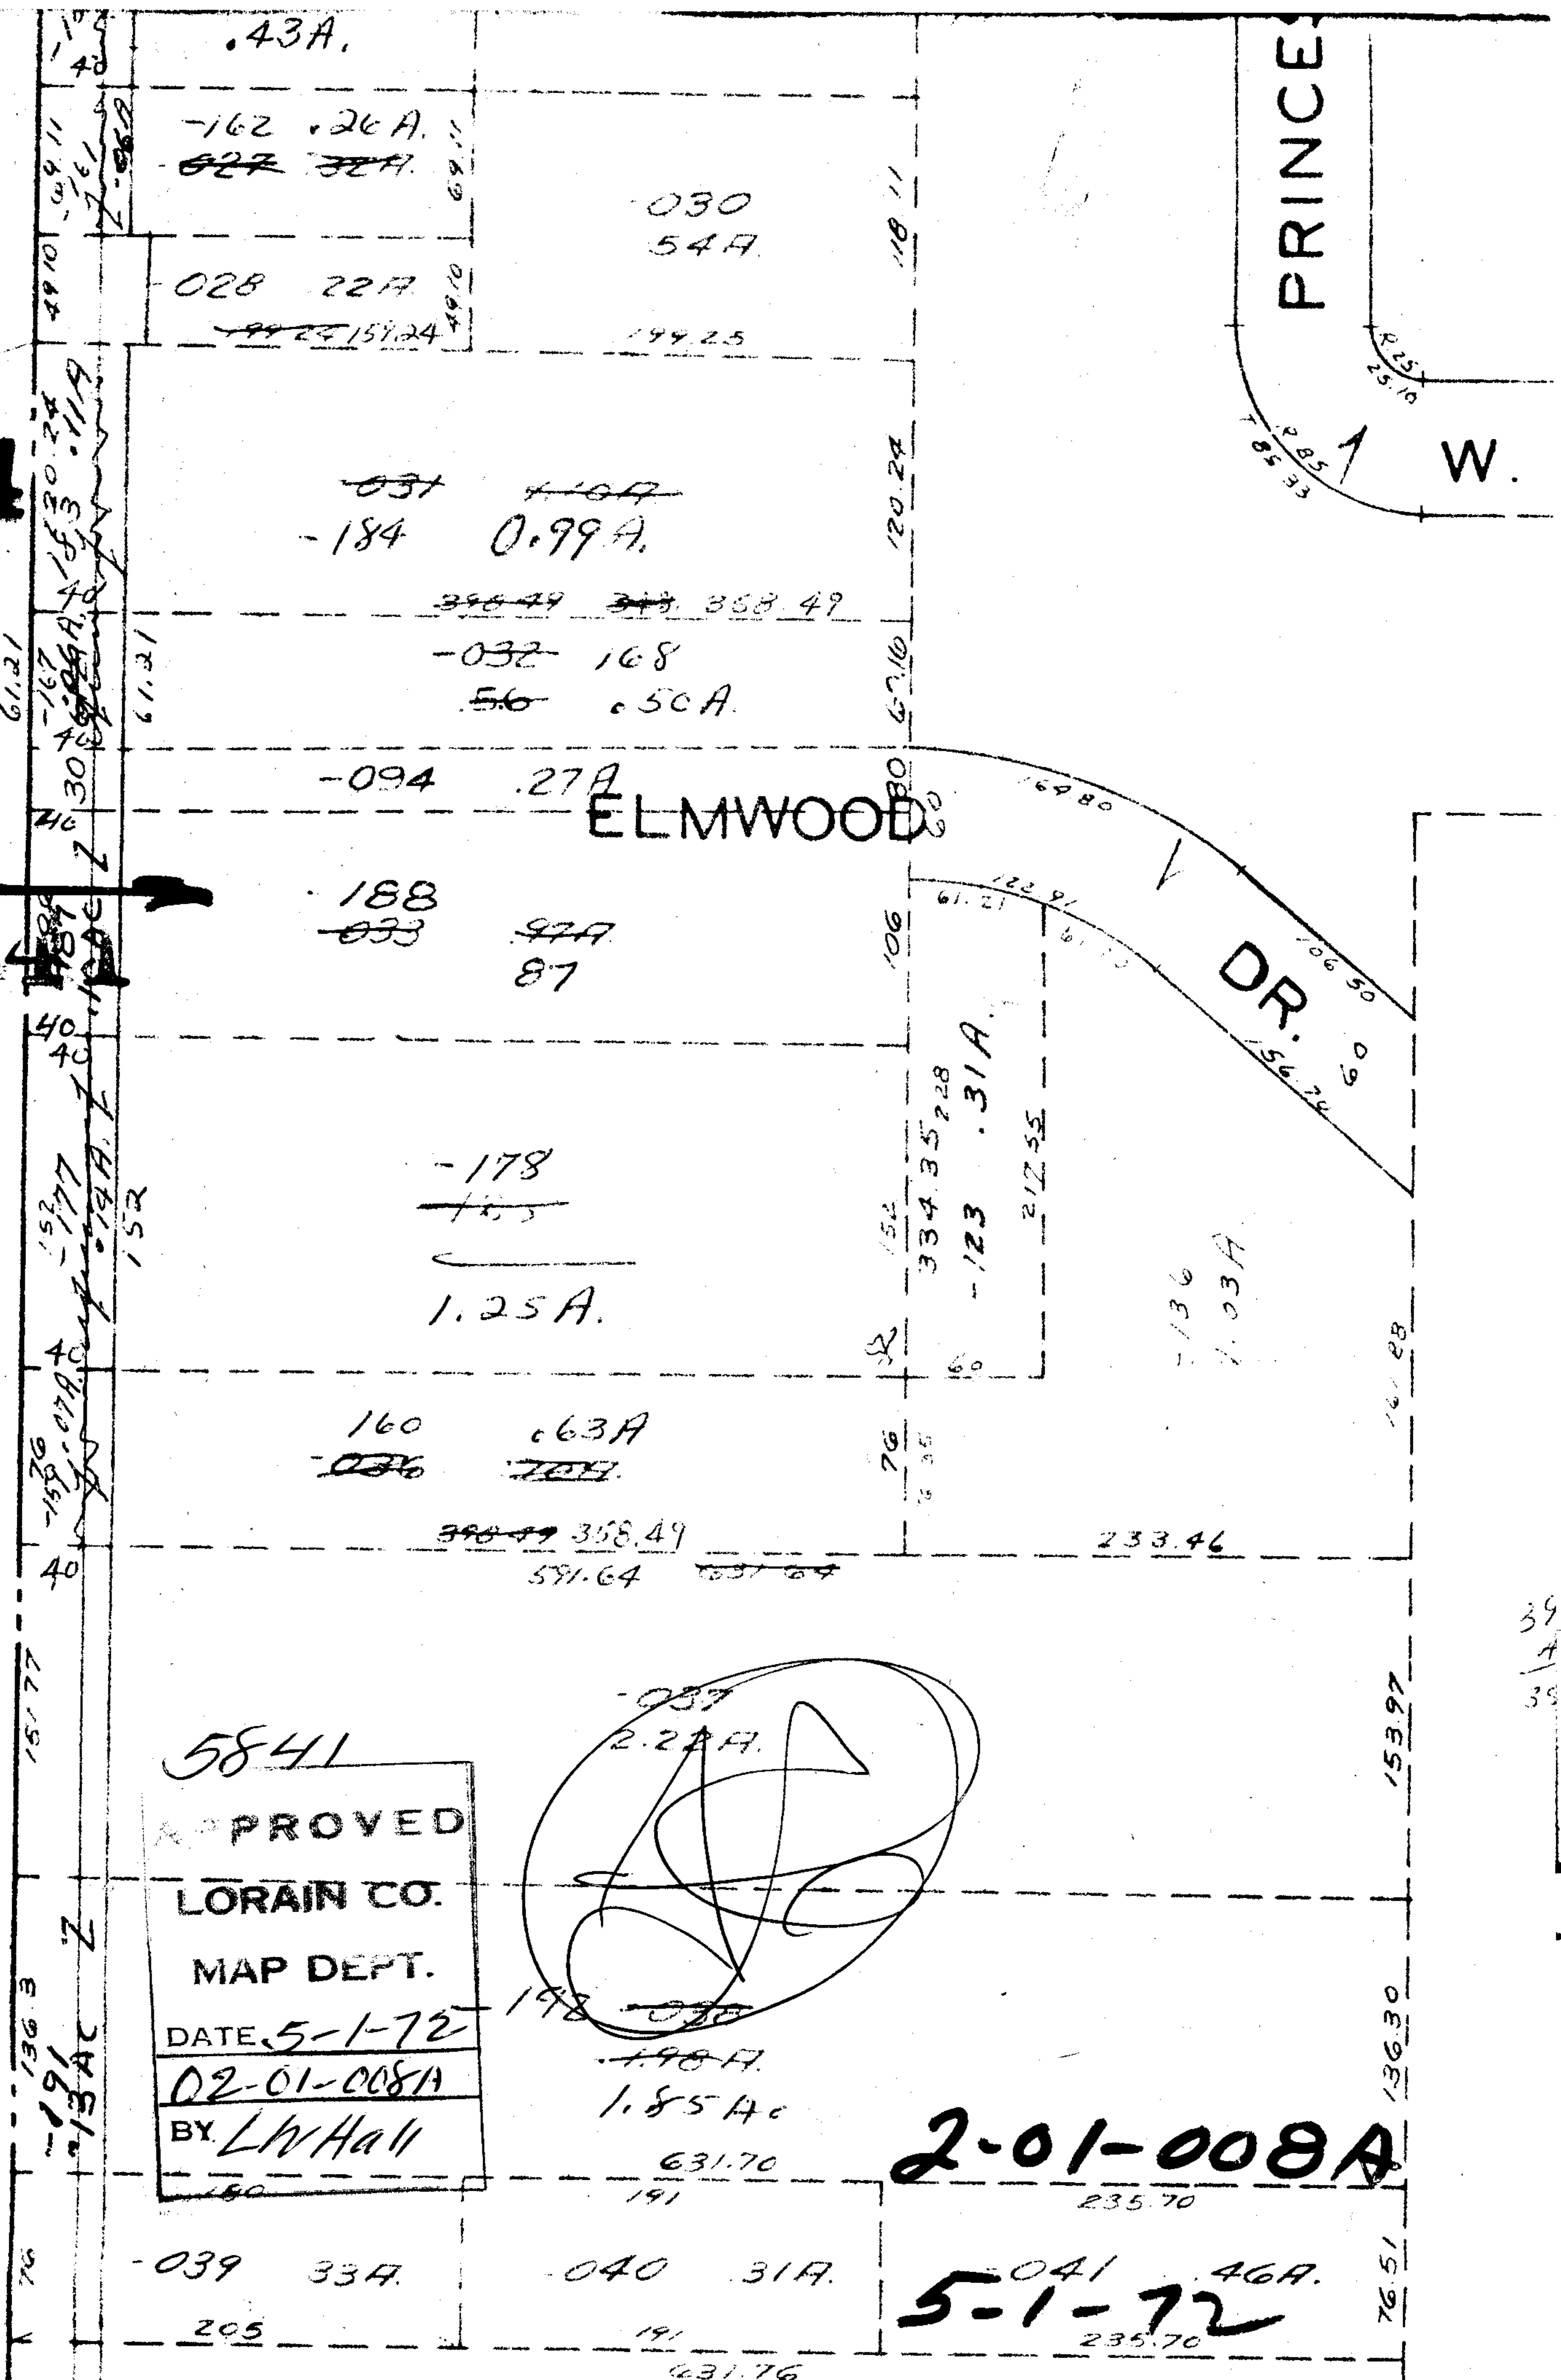

5841

APPROVED

LORAIN CO.

MAP DEPT.

DATE 5-1-72

02-01-008A

BY L.V. Hall

2-01-008A

5-1-72

PRINCES

ELMWOOD

DR.

W.

.43A.

-162 .26A.

030
54A.

028 22A.

~~031~~ ~~118A~~
-184 0.99A.

~~358.49~~ ~~348~~ 358.49

-032 168
56 .50A.

-094 .27A

188
~~033~~ 97A
87

-178
~~155~~

1.25A.

160 .63A
~~036~~ ~~70A.~~

~~358.49~~ 358.49
591.64 ~~637.69~~

~~037~~
2.21A.

198 ~~030~~
~~198A.~~
1.85Ac

631.70
191

-039 33A.
205

-040 31A.
191
631.76

-041 .46A.
5-1-72
235.70

39
4
38