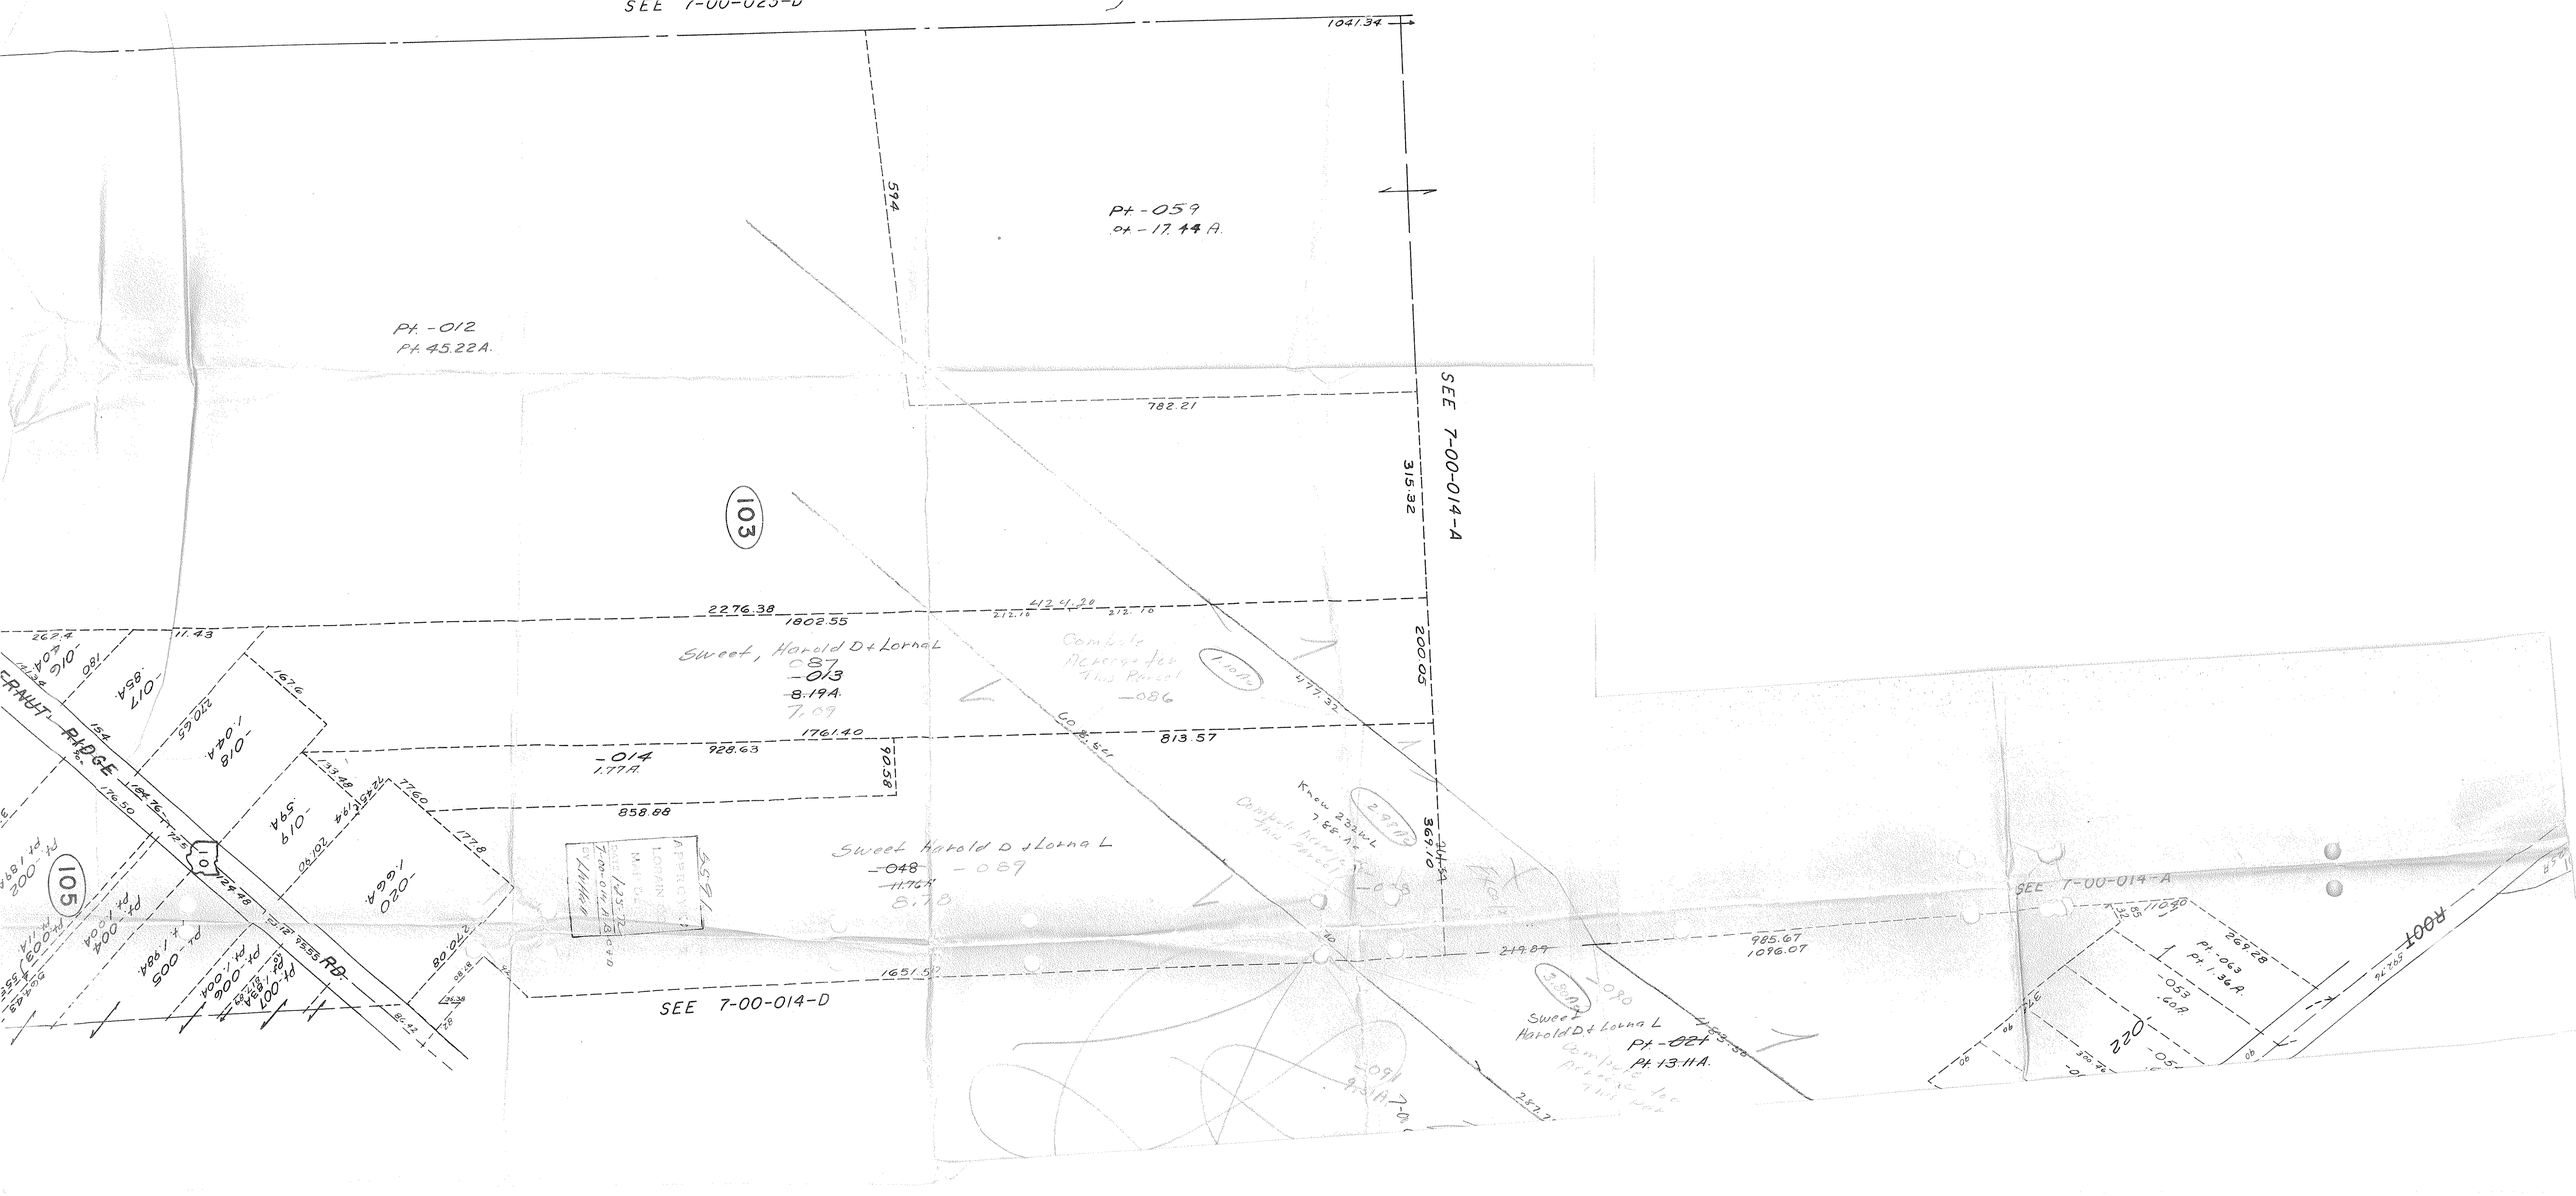
SEE 7-00-025-D
1041.34
Pt.-059
Pt.-17.44 A.
Pt.-012
Pt. 45.22A.
782.21
SEE 7-00-014-A
315.32
103
2276.38
1802.55
Sweet, Harold D + Lorna L
-087
-013
8.19A.
7.09
Combs Acreage for This Parcel
-086
200.05
477.32
1761.40
813.57
-014
1.77A.
928.63
858.88
Sweet Harold D + Lorna L
-048
-089
8.17B
Know 232WL
7.88A.
367.10
CRANUT RIDGE
105
RD.
SEE 7-00-014-D
1651.57
219.89
985.67
1096.07
Sweet Harold D + Lorna L
Pt.-021
Pt. 13.11A.
SEE 7-00-014-A
Pt.-063
Pt. 1.36A.
-053
.60A.
220
ROUTE