5602

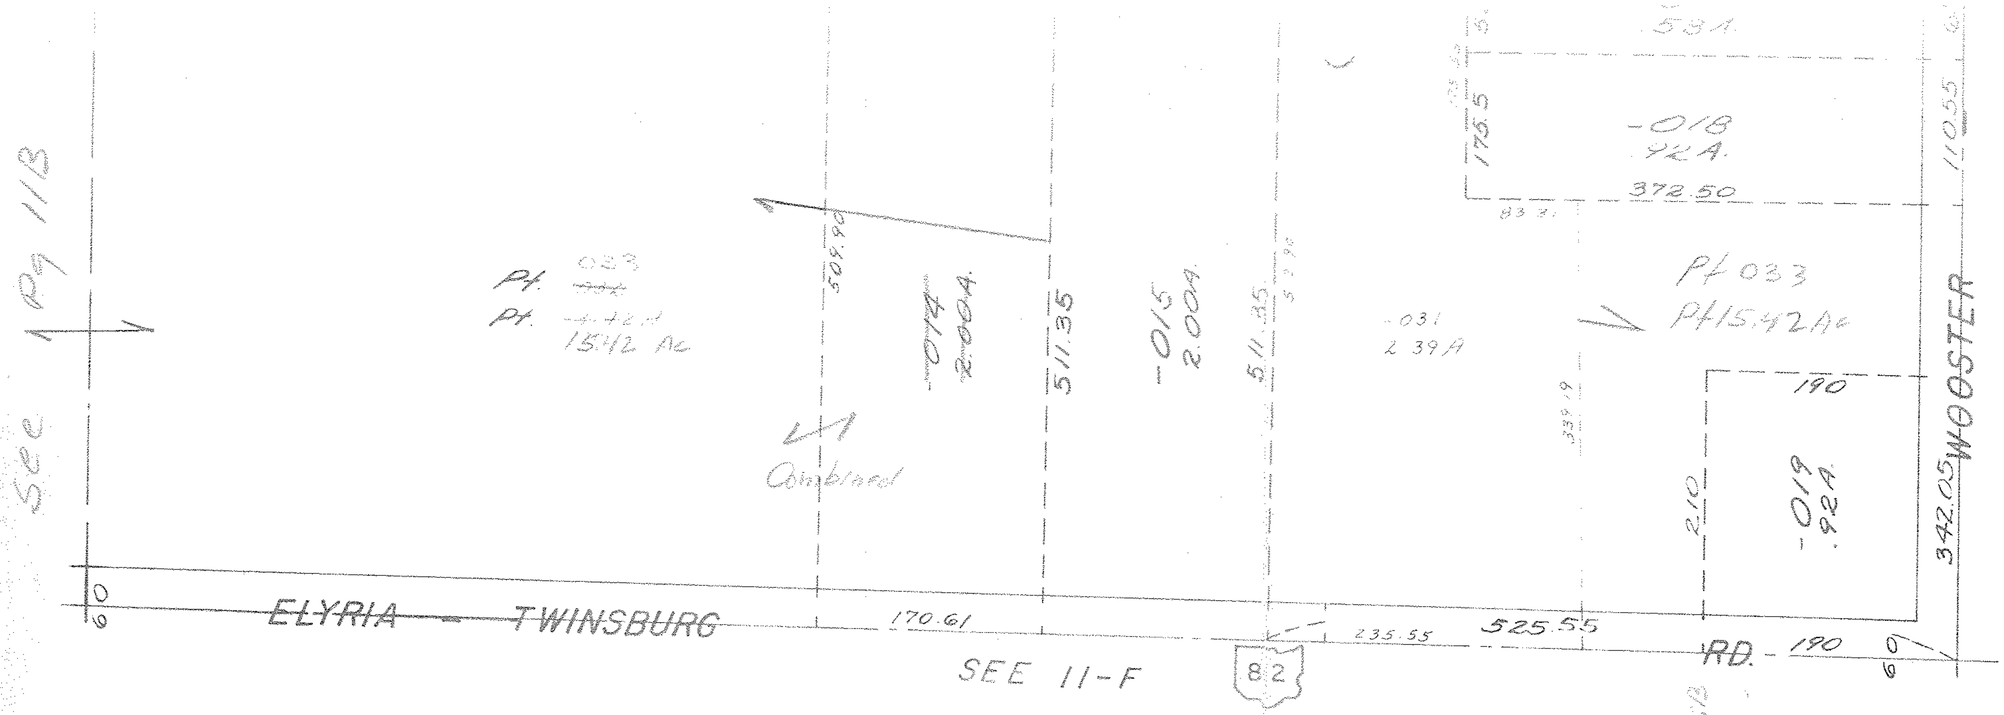

APPROVED
LORAIN CO.
MAP DEPT.
DATE 1-31-72
11B-11-00-055B
BY L. W. Hall

MAR 17 ENTD
S. S.
7-23-86

EATON TWP.

Copyright 1964

5602