


5603, 04, 05

301

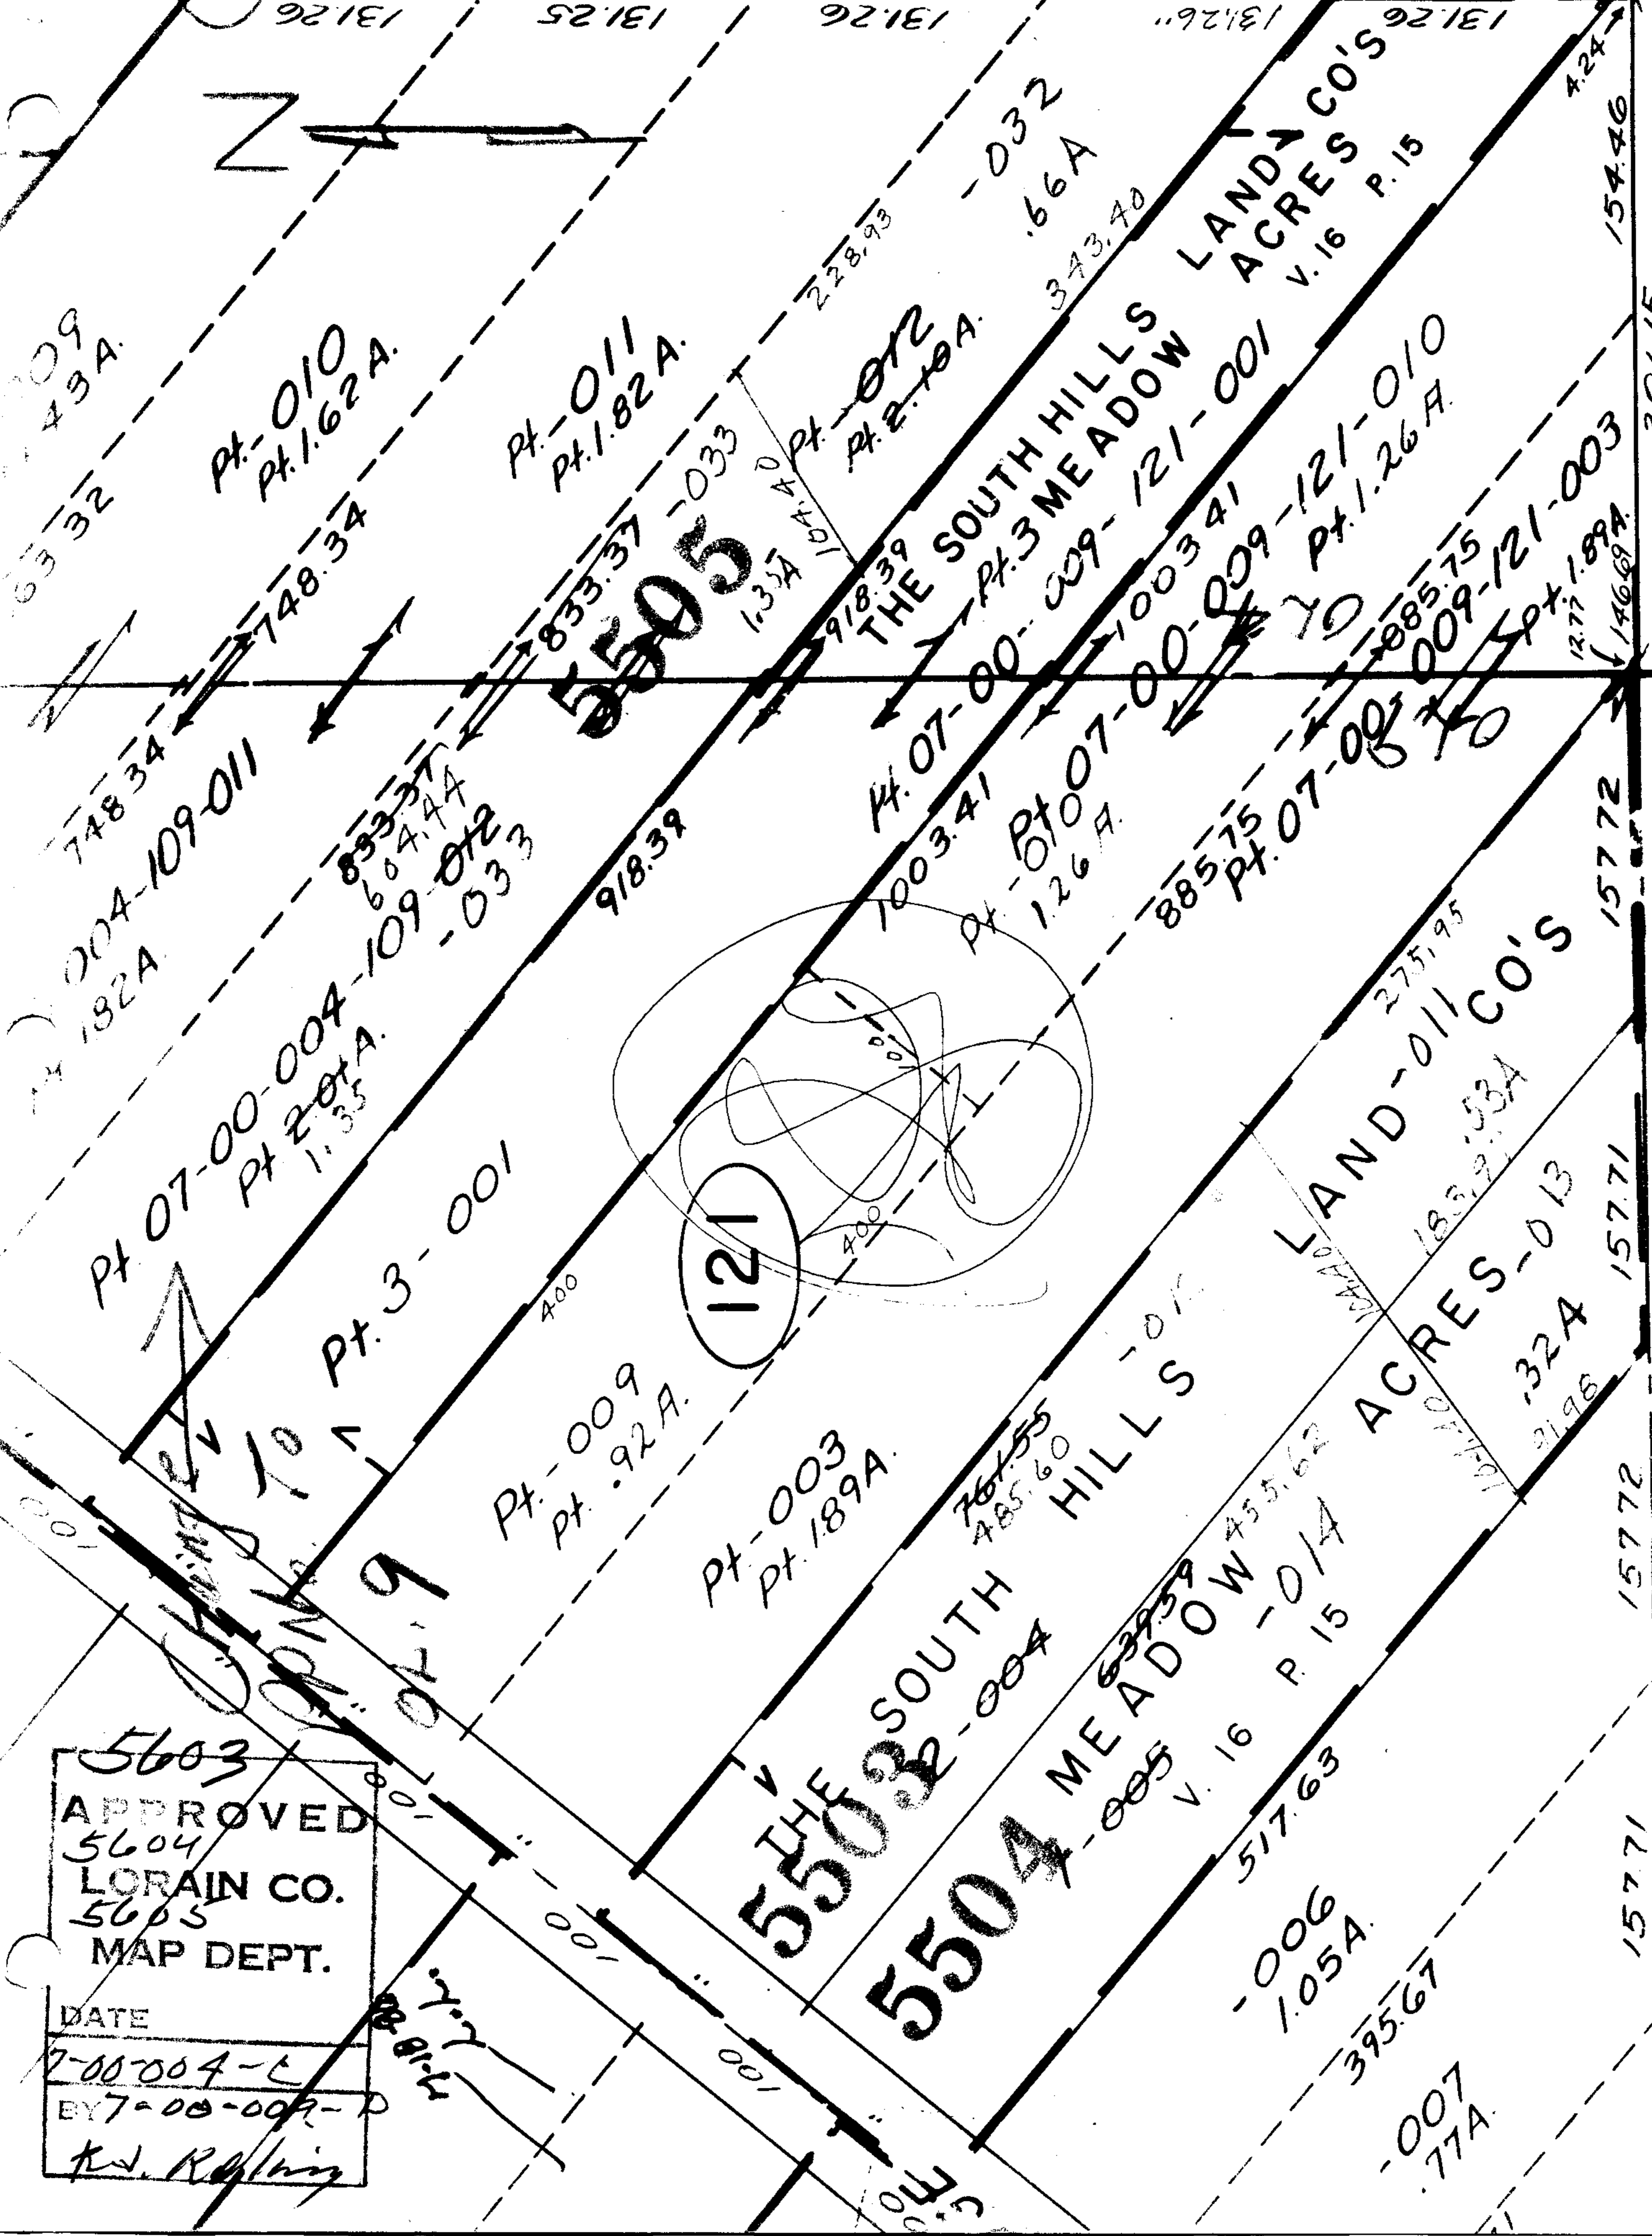

5603
 APPROVED
 5604
 LORAIN CO.
 5605
 MAP DEPT.
 DATE
 7-00-04-C
 BY 7-00-007-D
 K.W. Reilly