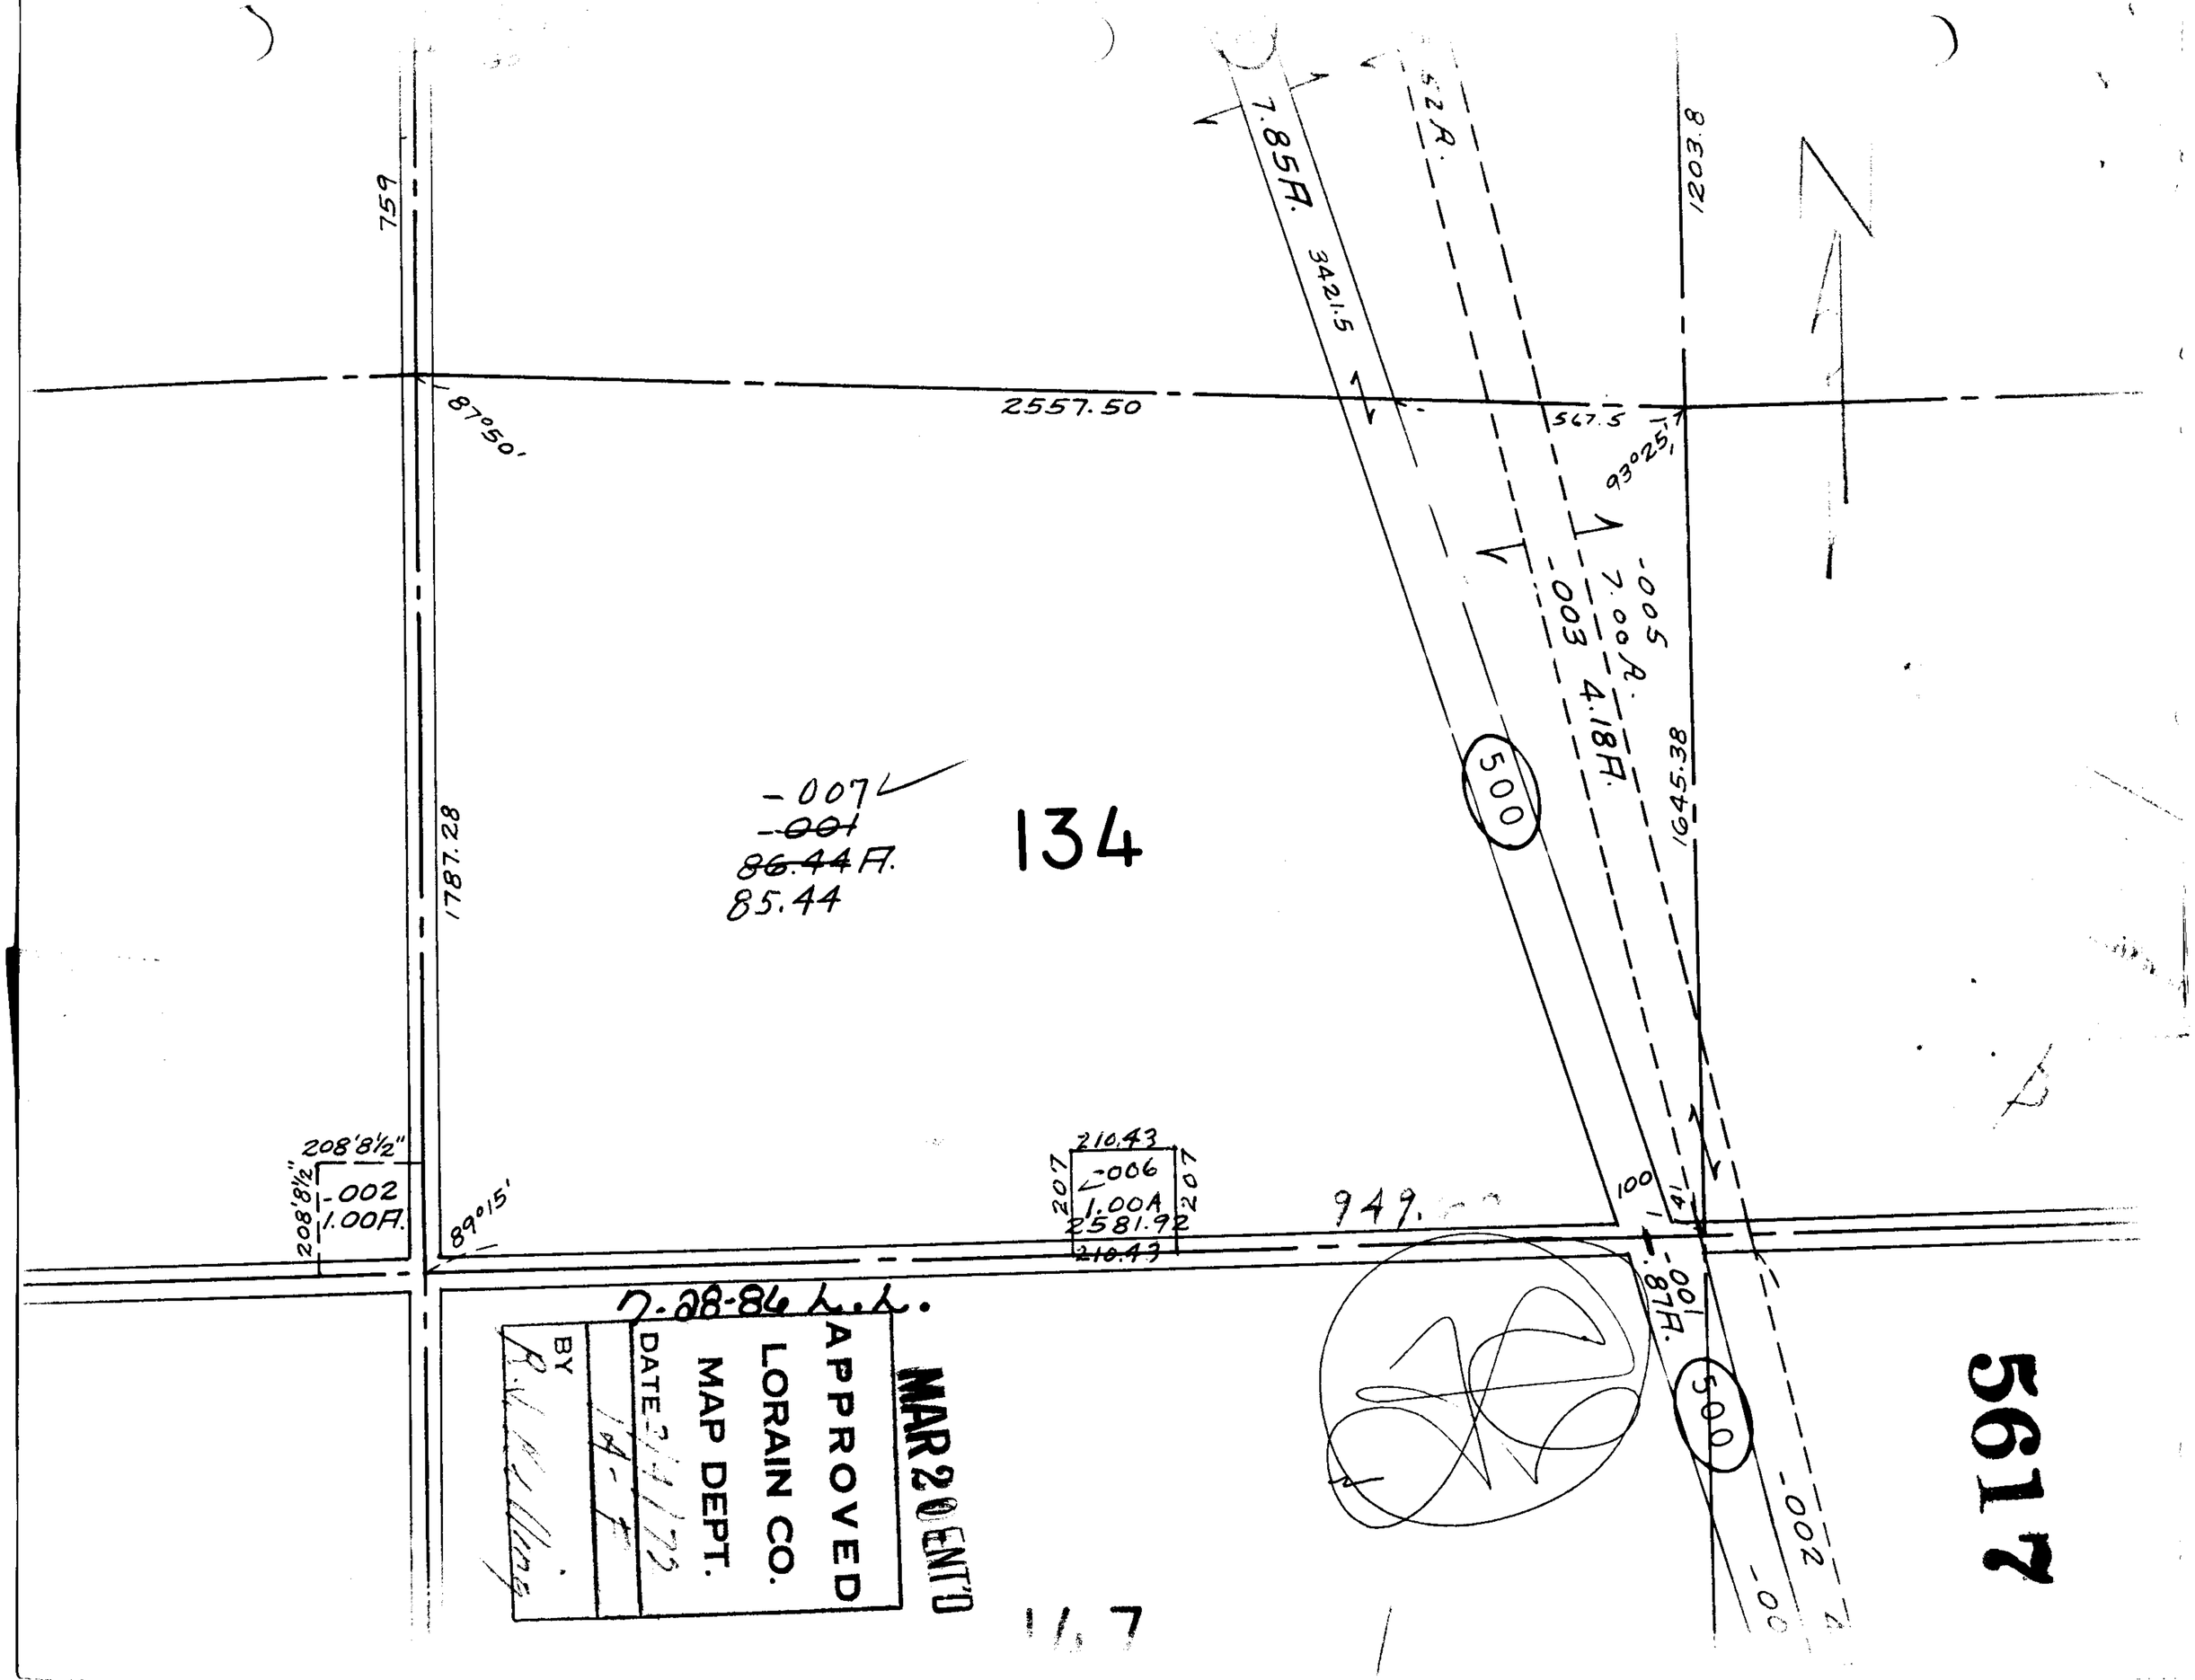

759
87°50'
2557.50
7.85A.
3421.5
52A.
1203.8
567.5
93°25'
-005
7.00A.
-003
4.18A.
500
1645.38
-007
~~-001~~
~~86.44~~A.
85.44
134
1787.28
208'8½"
208'8½"
-002
1.00A.
89°15'
210.43
207
-006
1.00A
207
2581.92
210.43
949.
100
41
-001
.87A.
500
-002
-00
7-28-86 L.L.
APPROVED
LORAIN CO.
MAP DEPT.
DATE
BY
MAR 20 ENT'D
5617