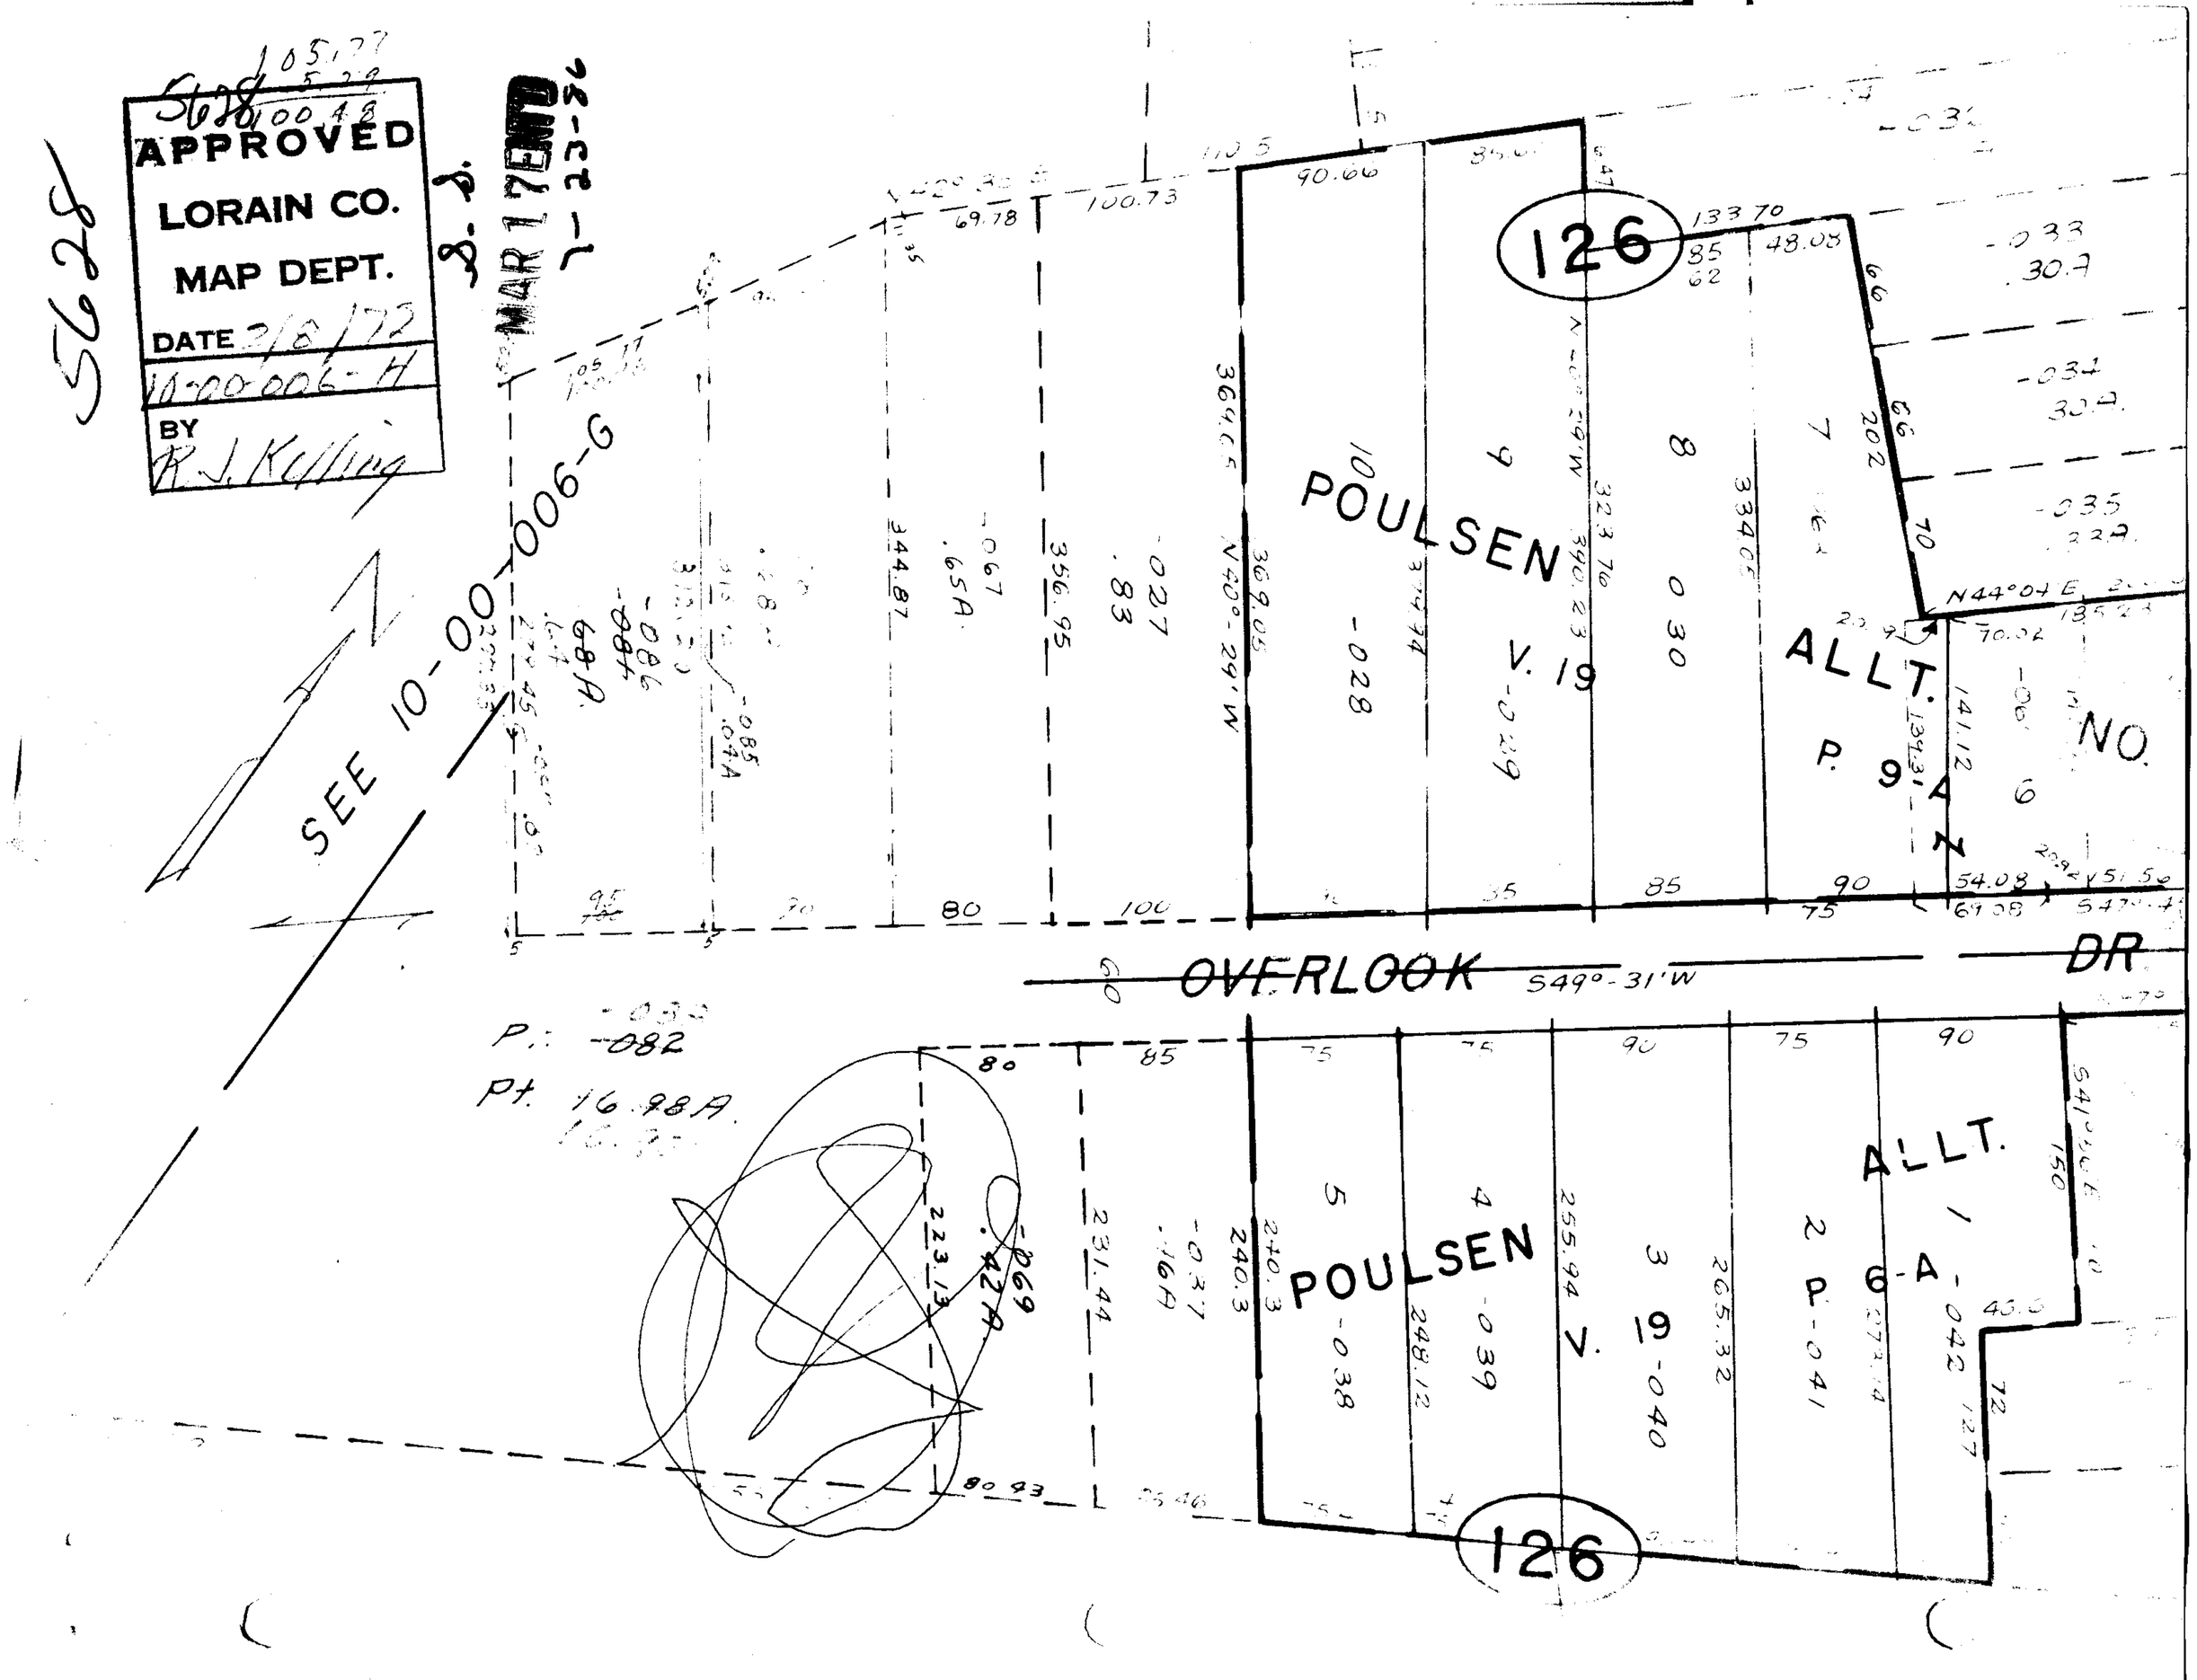

5628
APPROVED
LORAIN CO.
MAP DEPT.
DATE 2/8/72
10-00-006-H
BY
R.J. Kelling
MAR 17 ENTD
7-23-86
SEE 10-00-006-G
126
POULSEN
V. 19
ALLT.
P. 9-A
NO. 6
OVERLOOK
DR
S49°-31'W
N44°04'E
N40°-29'W
P.: -082
Pt. 16.98A.
POULSEN
V. 19
ALLT.
P. 6-A
126