


5635

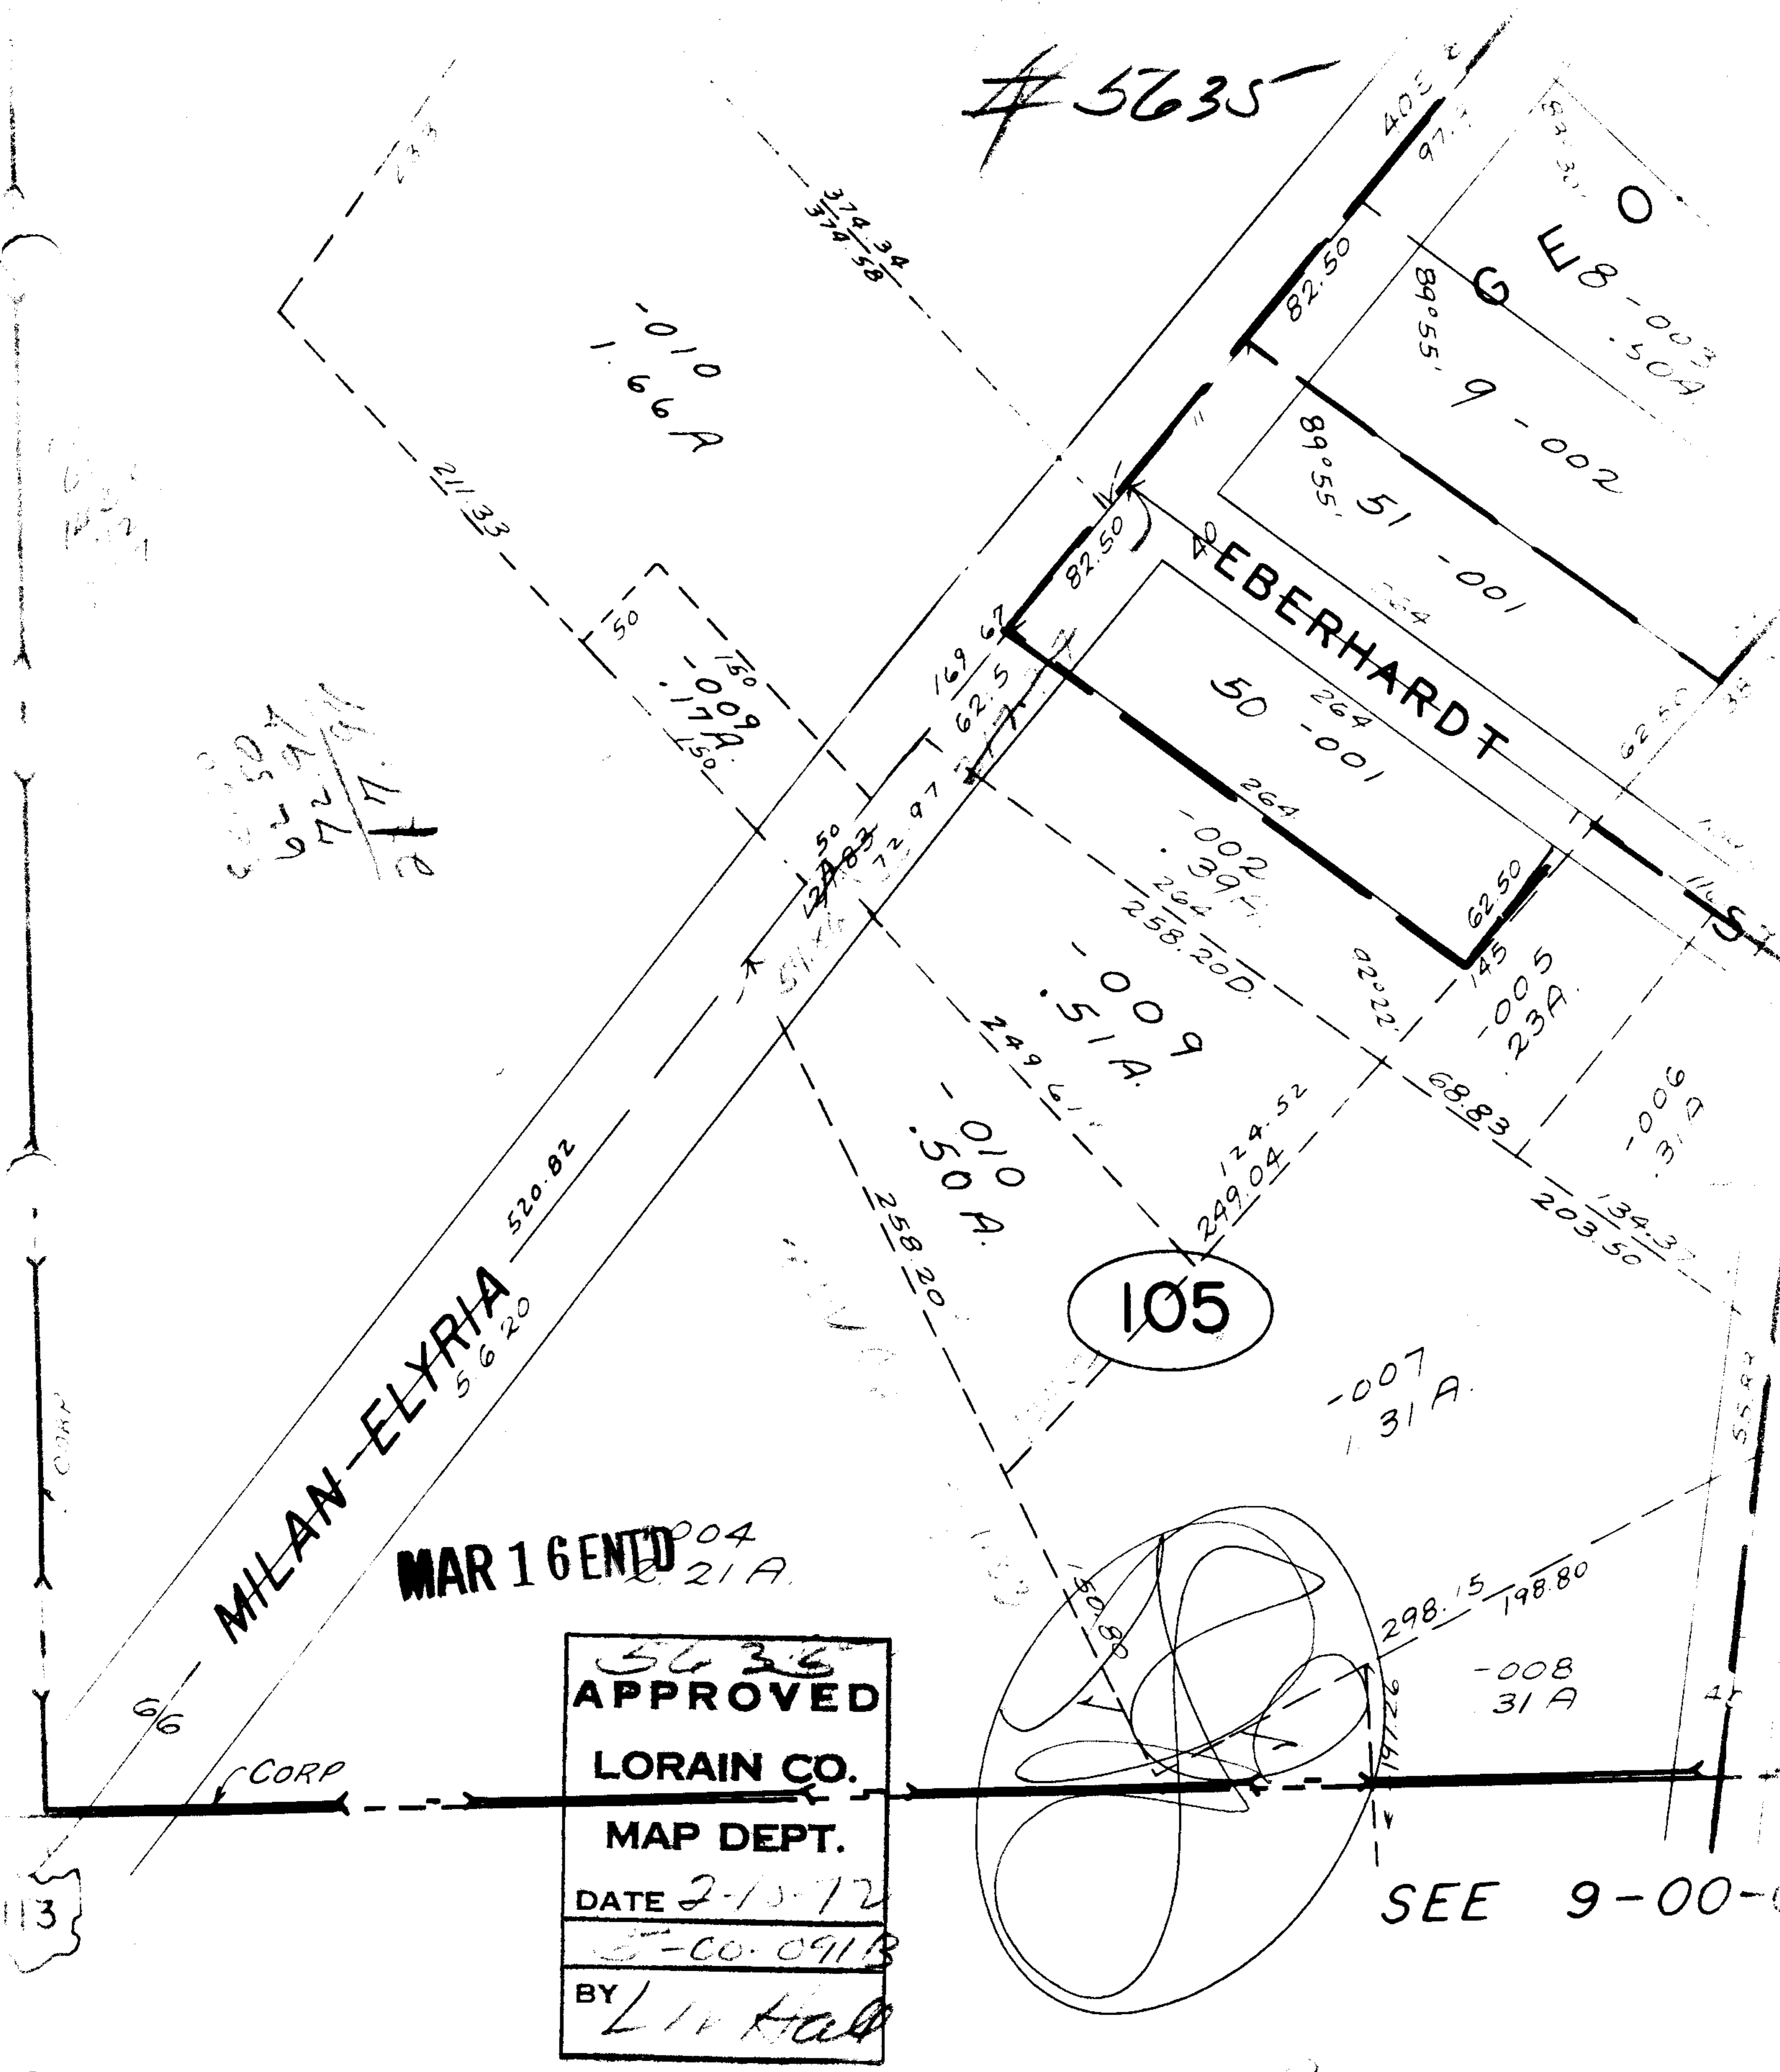

MILAN-ELYRIA
520.82
5620

105


5635
APPROVED
LORAIN CO.
MAP DEPT.
 DATE 2-15-72
 5-CO-091B
 BY L. H. HALL

SEE 9-00-0

AMHERST TWP

SCALE: 1" = 100'

P4
5-00-091B