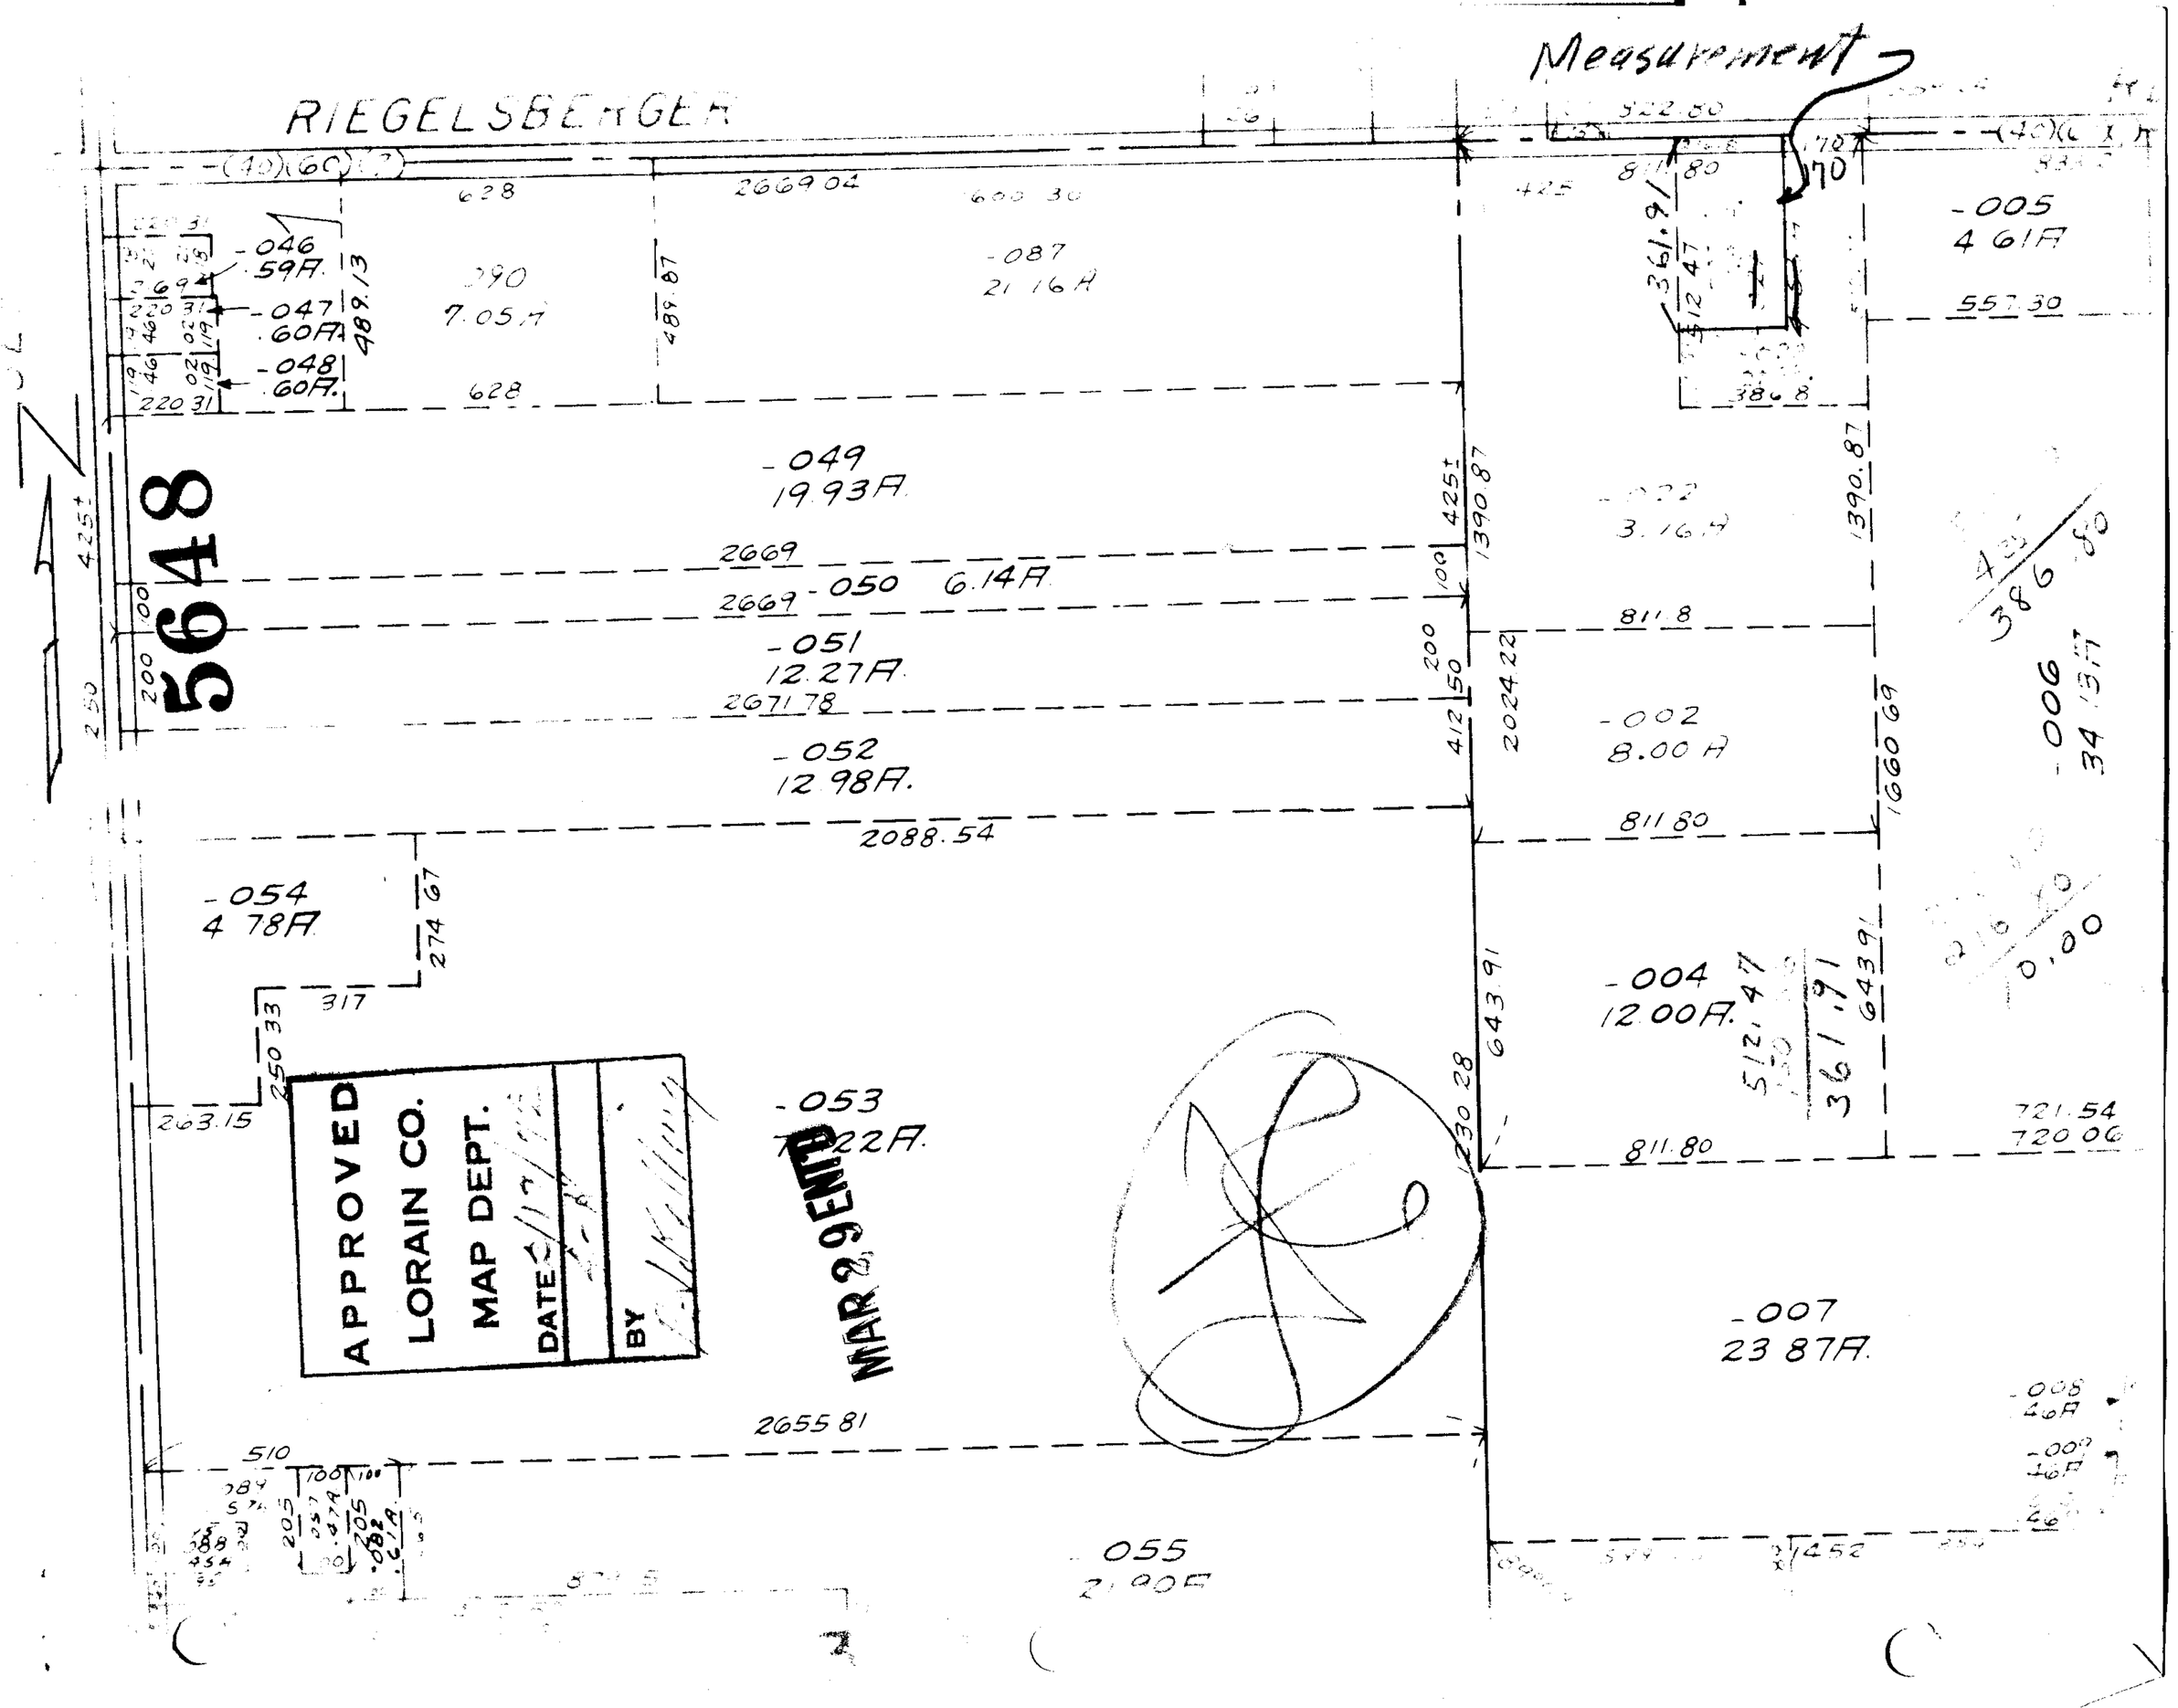

Measurement
RIEGELSBERGER
5648
-046 .59A.
-047 .60A.
-048 .60A.
-090 7.05A
-087 21.16A
-005 4.61A
-049 19.93A
-050 6.14A
-051 12.27A
-052 12.98A.
-054 4.78A
-053 7.22A.
-055 21.90A
-002 8.00A
-004 12.00A.
-007 23.87A.
-006 34.13A
APPROVED
LORAIN CO.
MAP DEPT.
DATE
BY
MAR 29 ENTD