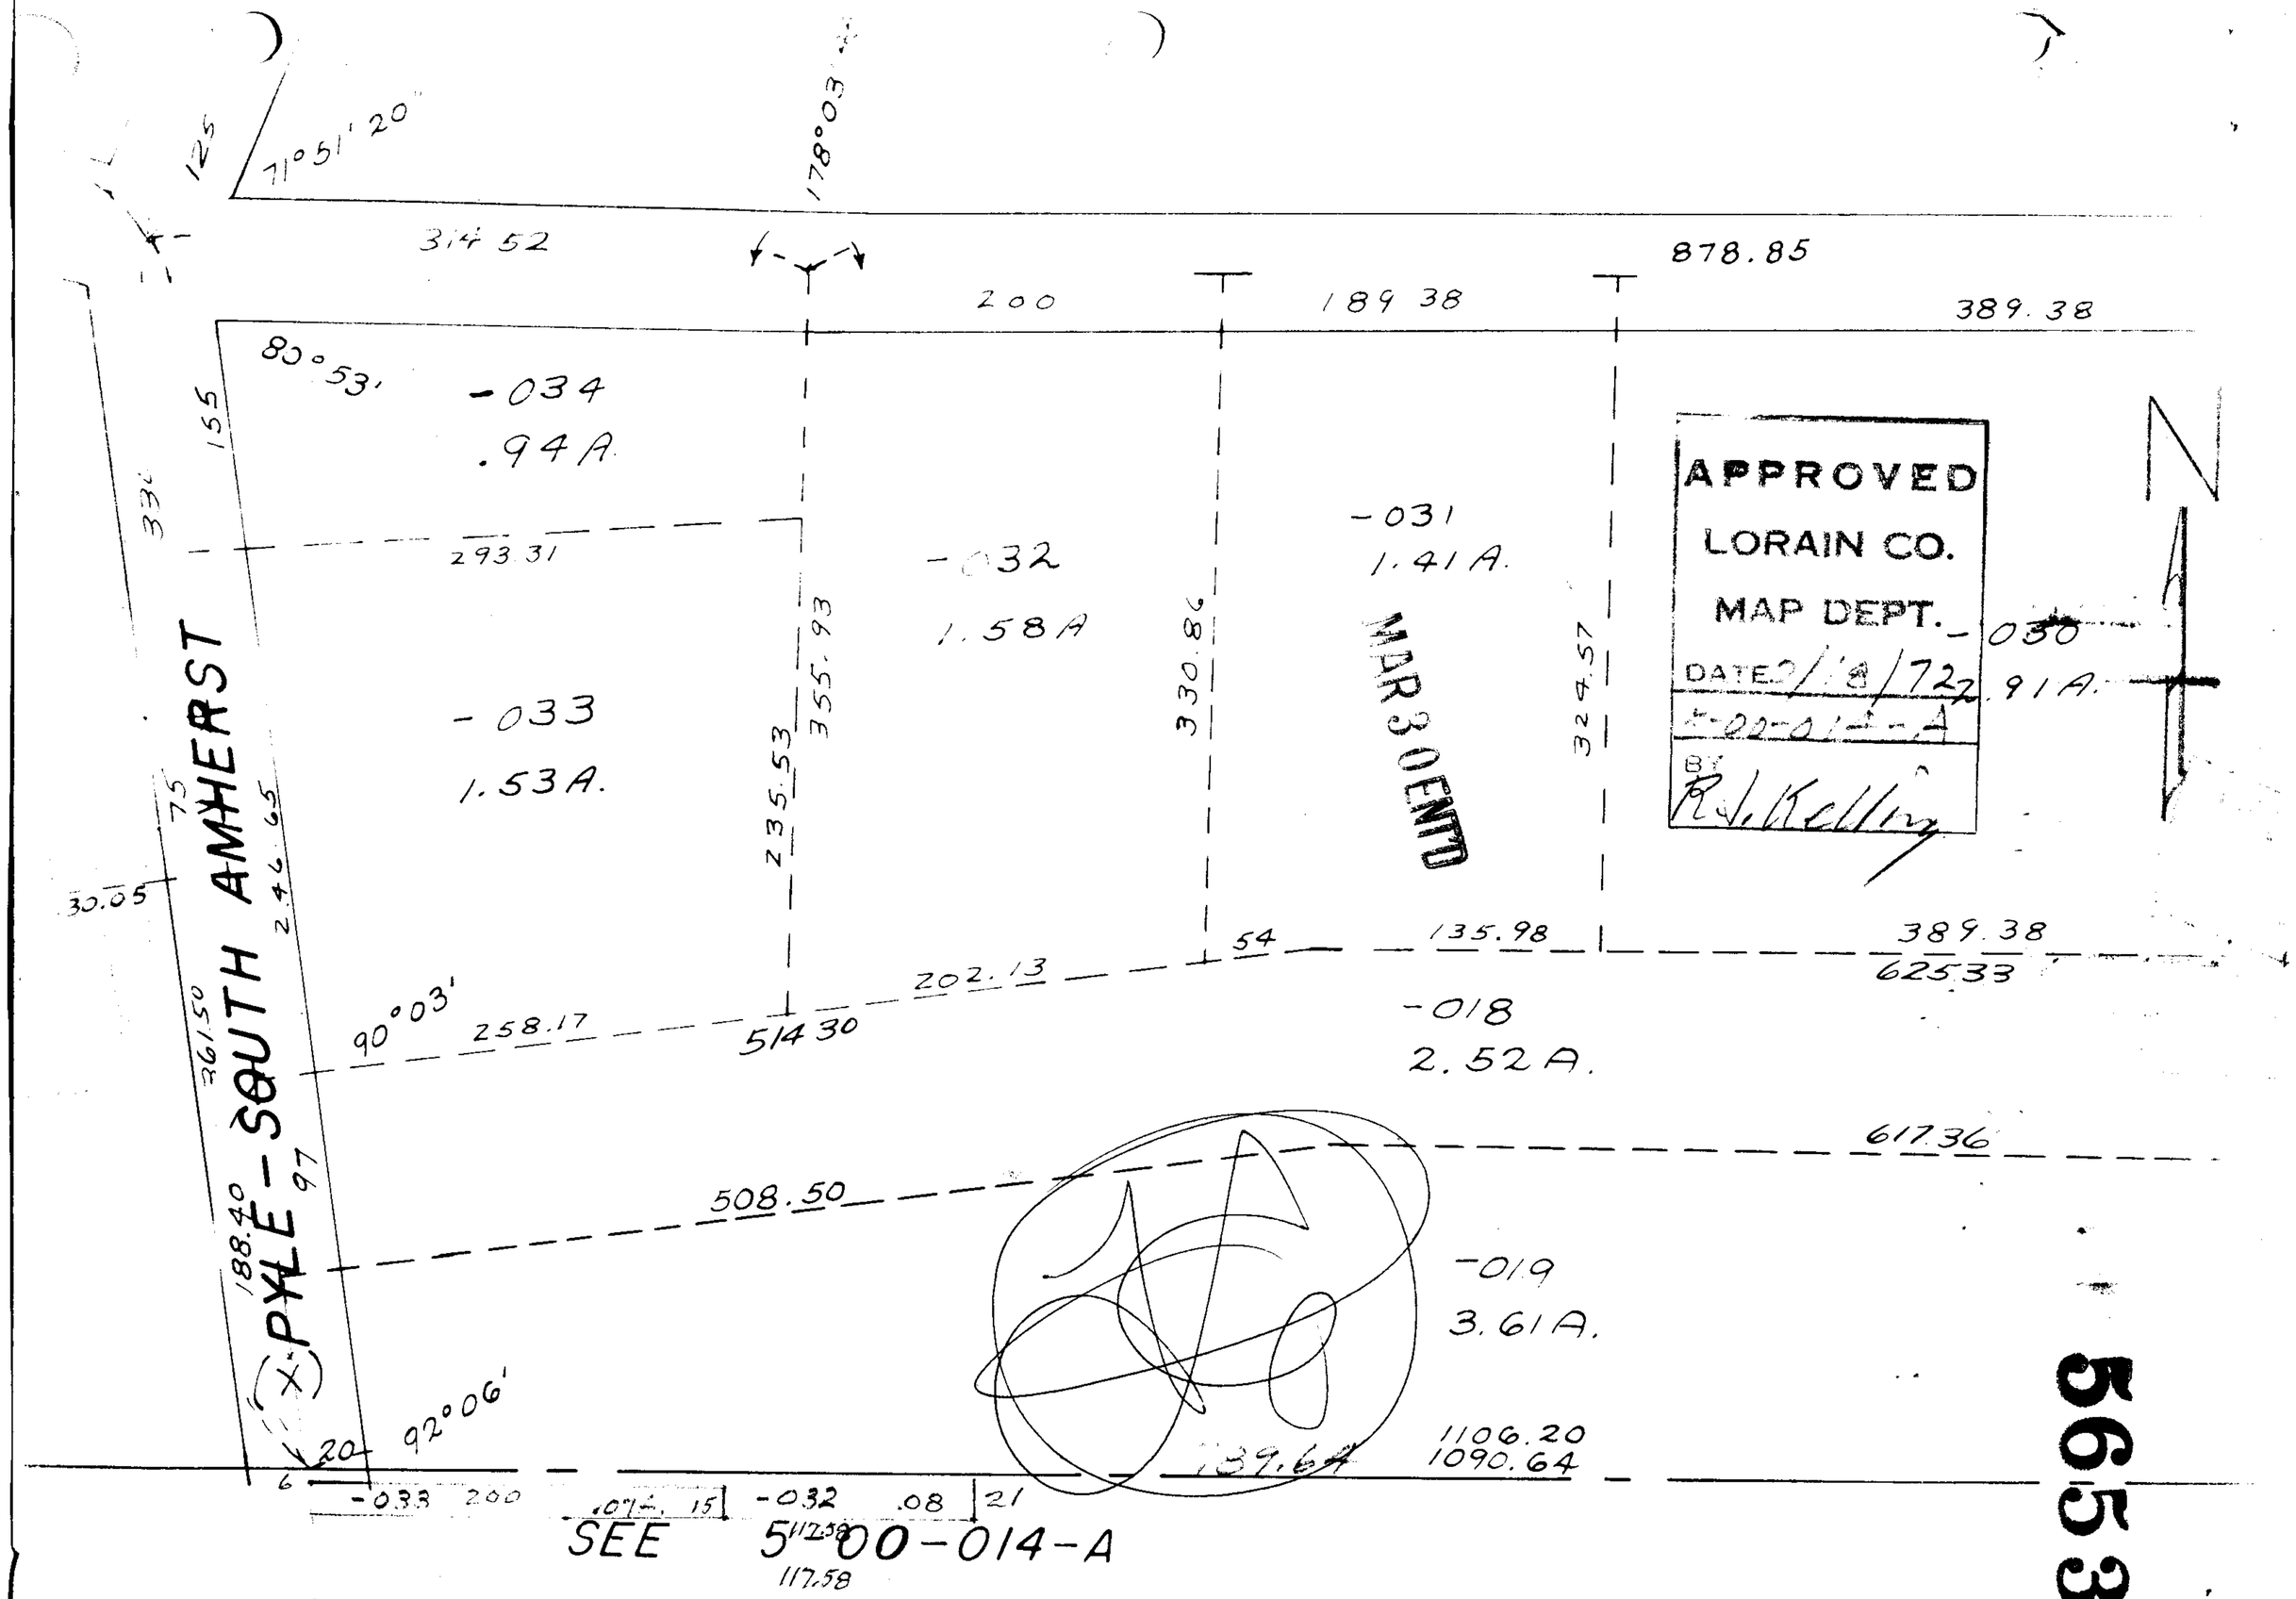
71°51' 20"
125
178°03'
314 52
878.85
200
189 38
389.38
80°53'
-034
.94A
155
336
293.31
-032
1.58A
-031
1.41A.
355.93
330.86
324.57
-030
.91A.
-033
1.53A.
235.53
75
30.05
246.65
AMHERST
PYLE - SOUTH
361.50
188.40
97
54
135.98
389.38
62533
202.13
90°03'
258.17
514 30
-018
2.52A.
617.36
508.50
-019
3.61A.
92°06'
20
6
-033
200
.07A.
15
-032
.08
21
139.64
1106.20
1090.64
SEE 5-00-014-A
117.58
117.58
APPROVED
LORAIN CO.
MAP DEPT.
DATE 2/18/72
BY R. J. Kelling
MAR 30 ENTD
N
5653