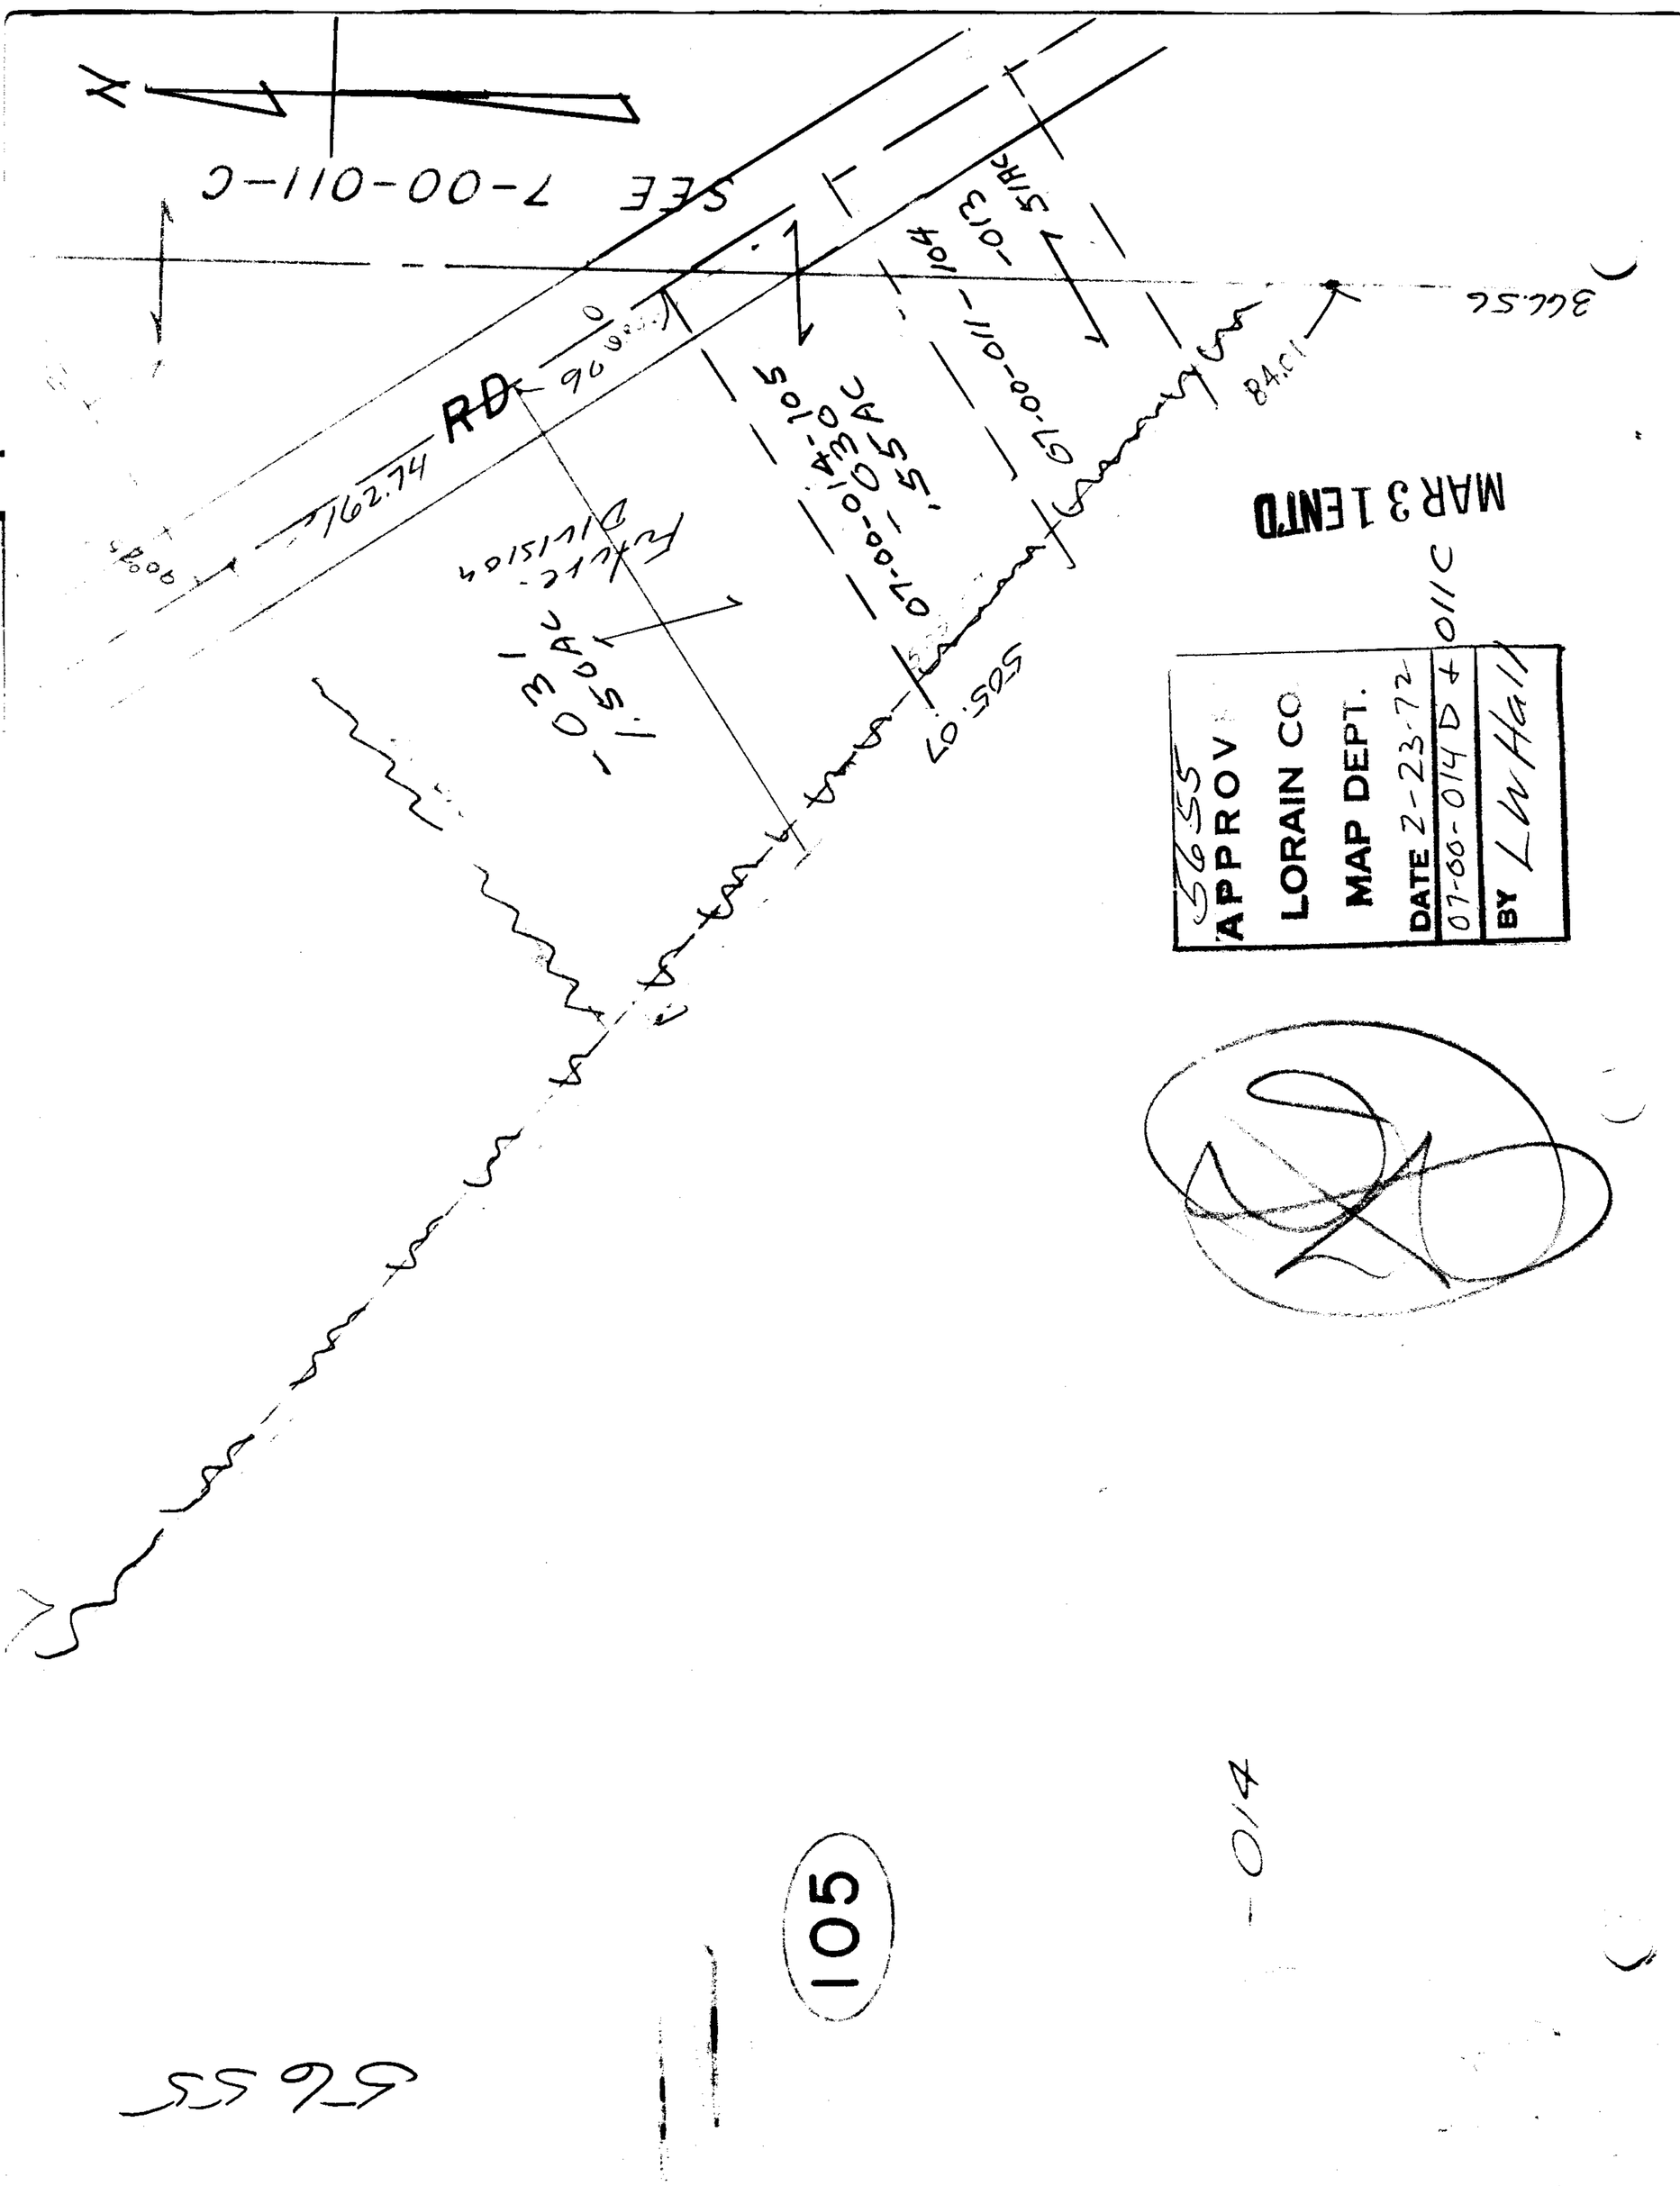
N
SEE 7-00-011-C
RD
162.74
07-00-014-105
.030
.55AC
07-00-011-104
-013
.51AC
84.01
366.56
505.07
-031
1.50AC
Future Division
MAR 31 ENT'D
5655
APPROV
LORAIN CO
MAP DEPT.
DATE 2-23-72
07-00-014 D + 011C
BY LWHall
105
-014
5655