


5658

LOGAN

LOGAN

AVE.

AVE.

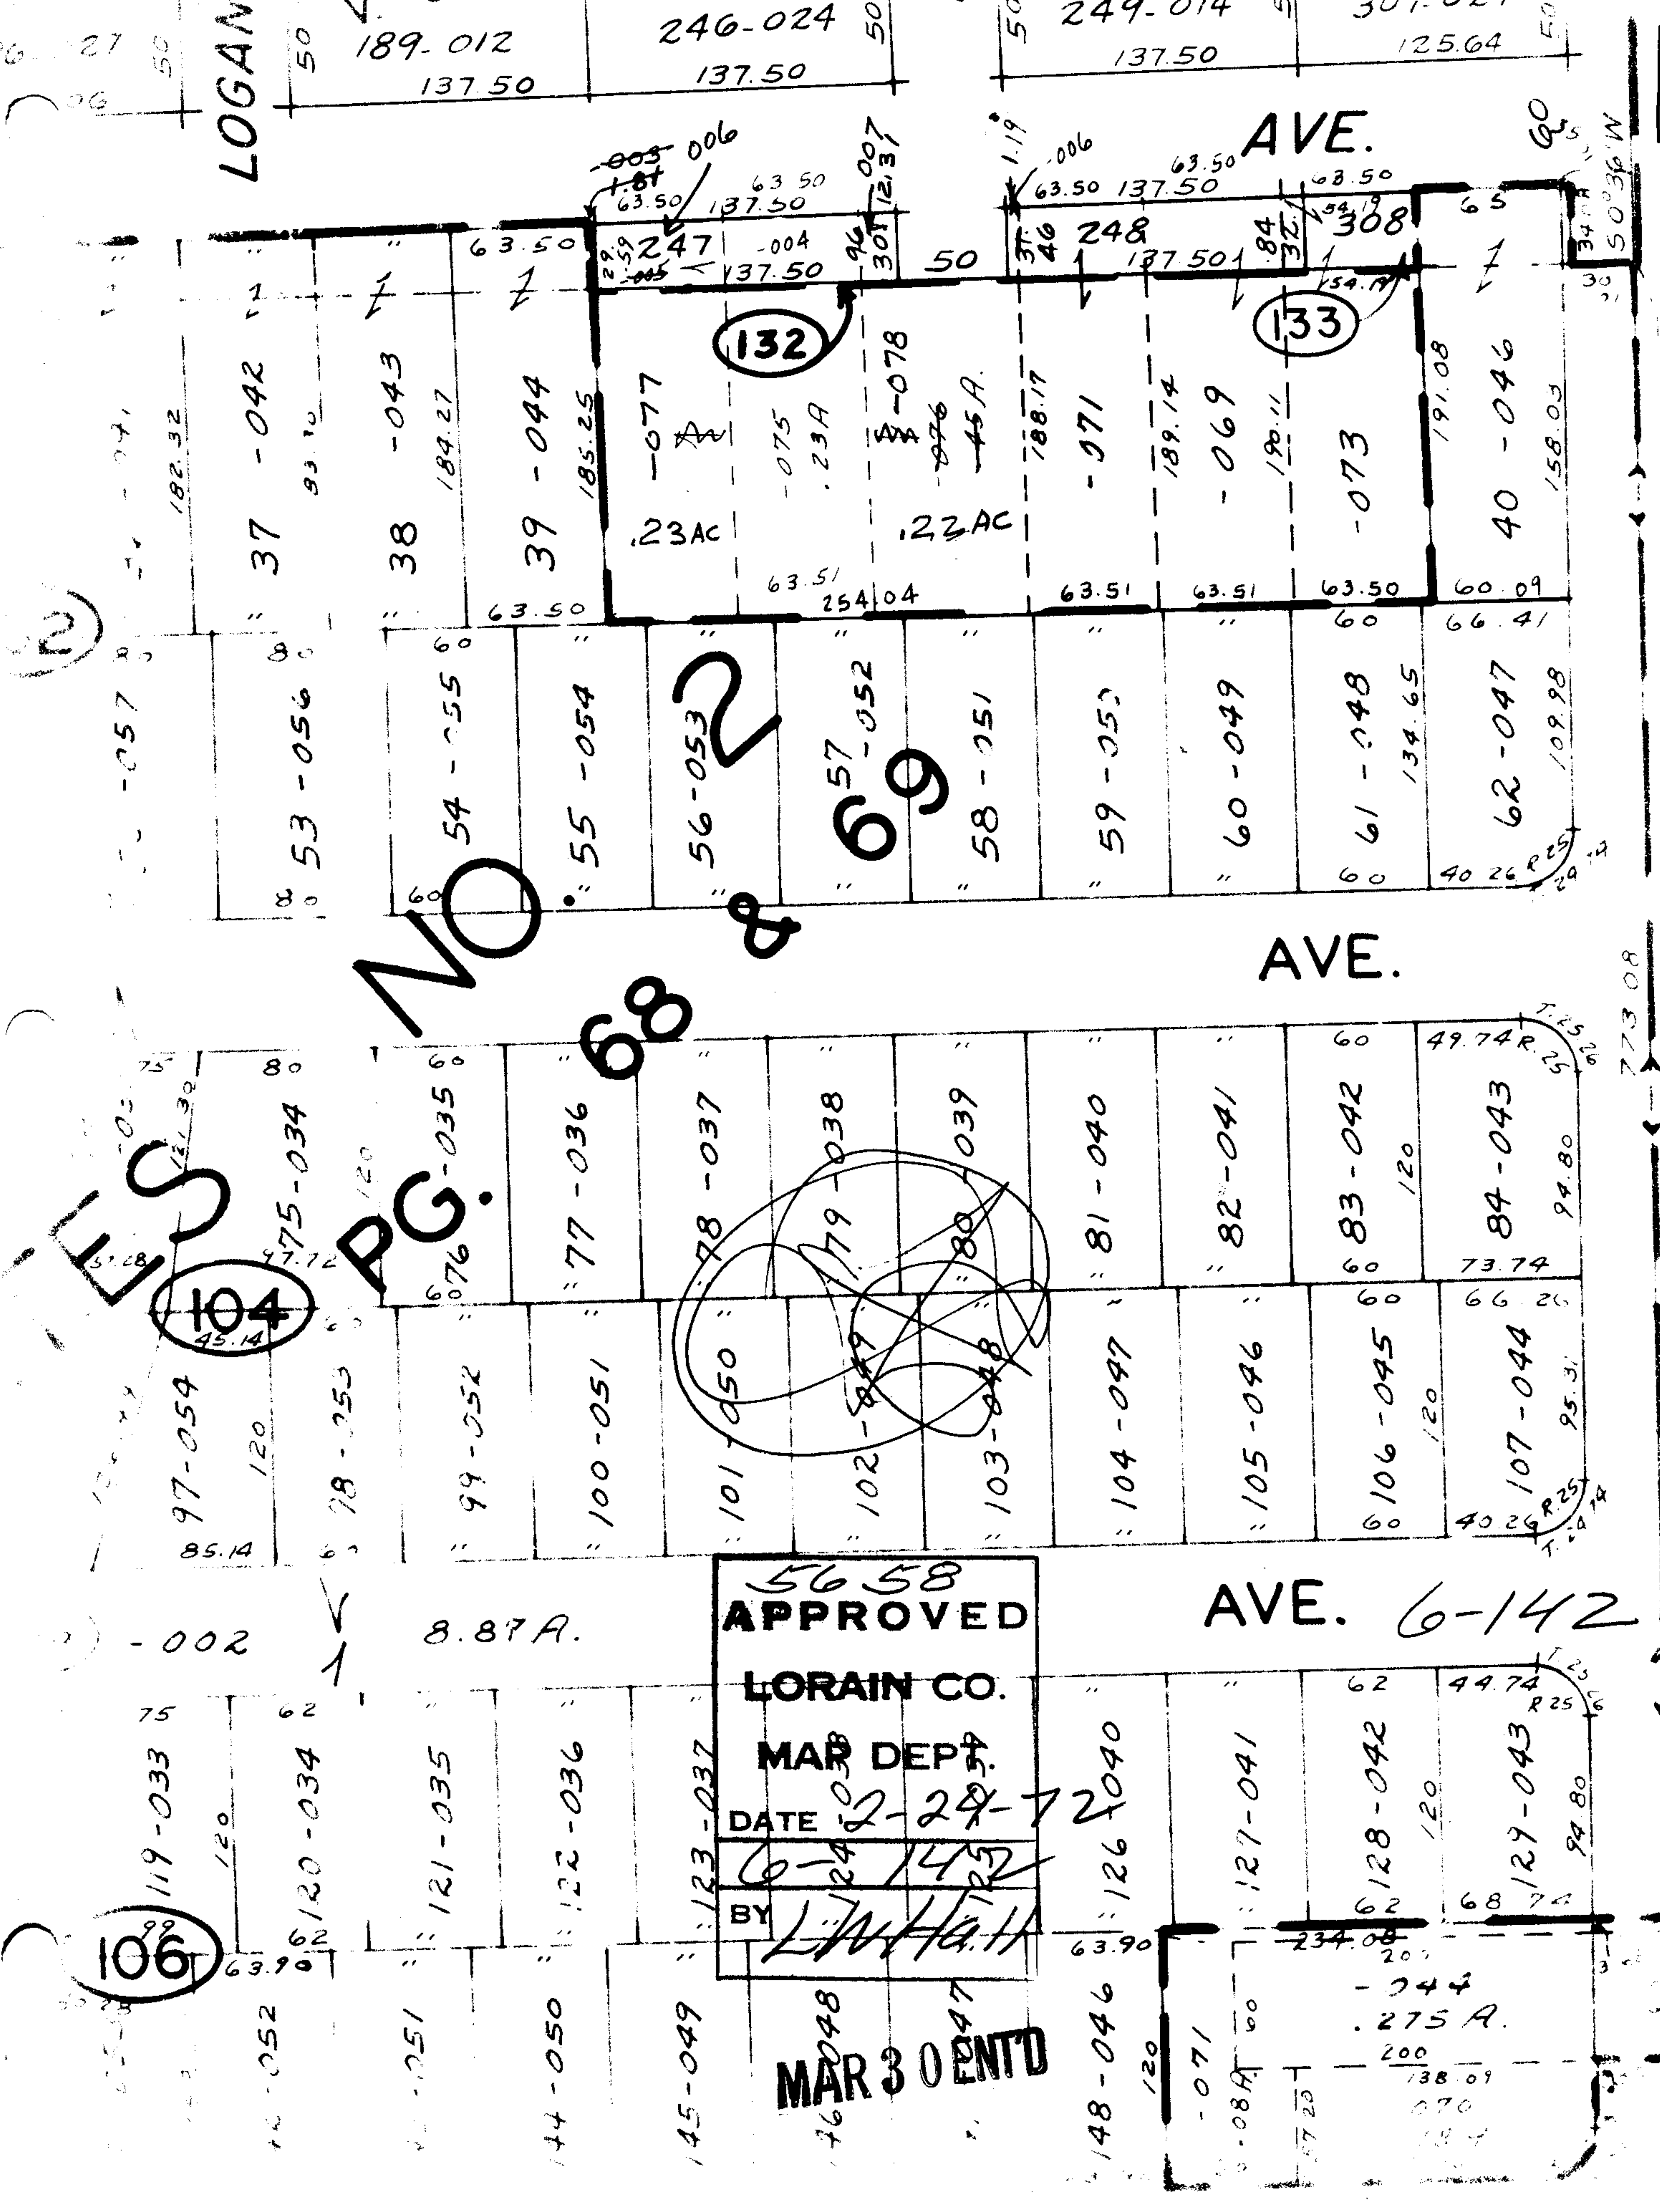

(2)

LES

NO 68 & 69

5658
 APPROVED
 LORAIN CO.
 MAP DEPT.
 BY L.W. Hall

 FNTD

106

104

132

133

37 - 042

38 - 043

39 - 044

23AC

22AC

248

308

40 - 046

97-054

98-055

99-052

100-051

101-050

102-049

103-048

104-047

105-046

106-045

107-044

119-033

120-034

121-035

122-036

123-037

124-038

125-039

126-040

127-041

128-042

129-043

140-052

141-051

144-050

145-049

146-048

