

3-00-034A

ON THE S. SIDE OF LAKE


APPROVED  
LORAIN CO.  
MAP DEPT.  
DATE 2-29-72  
BY [Signature]

CLUE  
DR.

SUNSET COUNTRY  
PRIVATE WALK  
50.10 22.026  
51.52 46.98.52  
51.52 46.98.52  
A 21-01  
V. 11 99.37

RD.

6/2

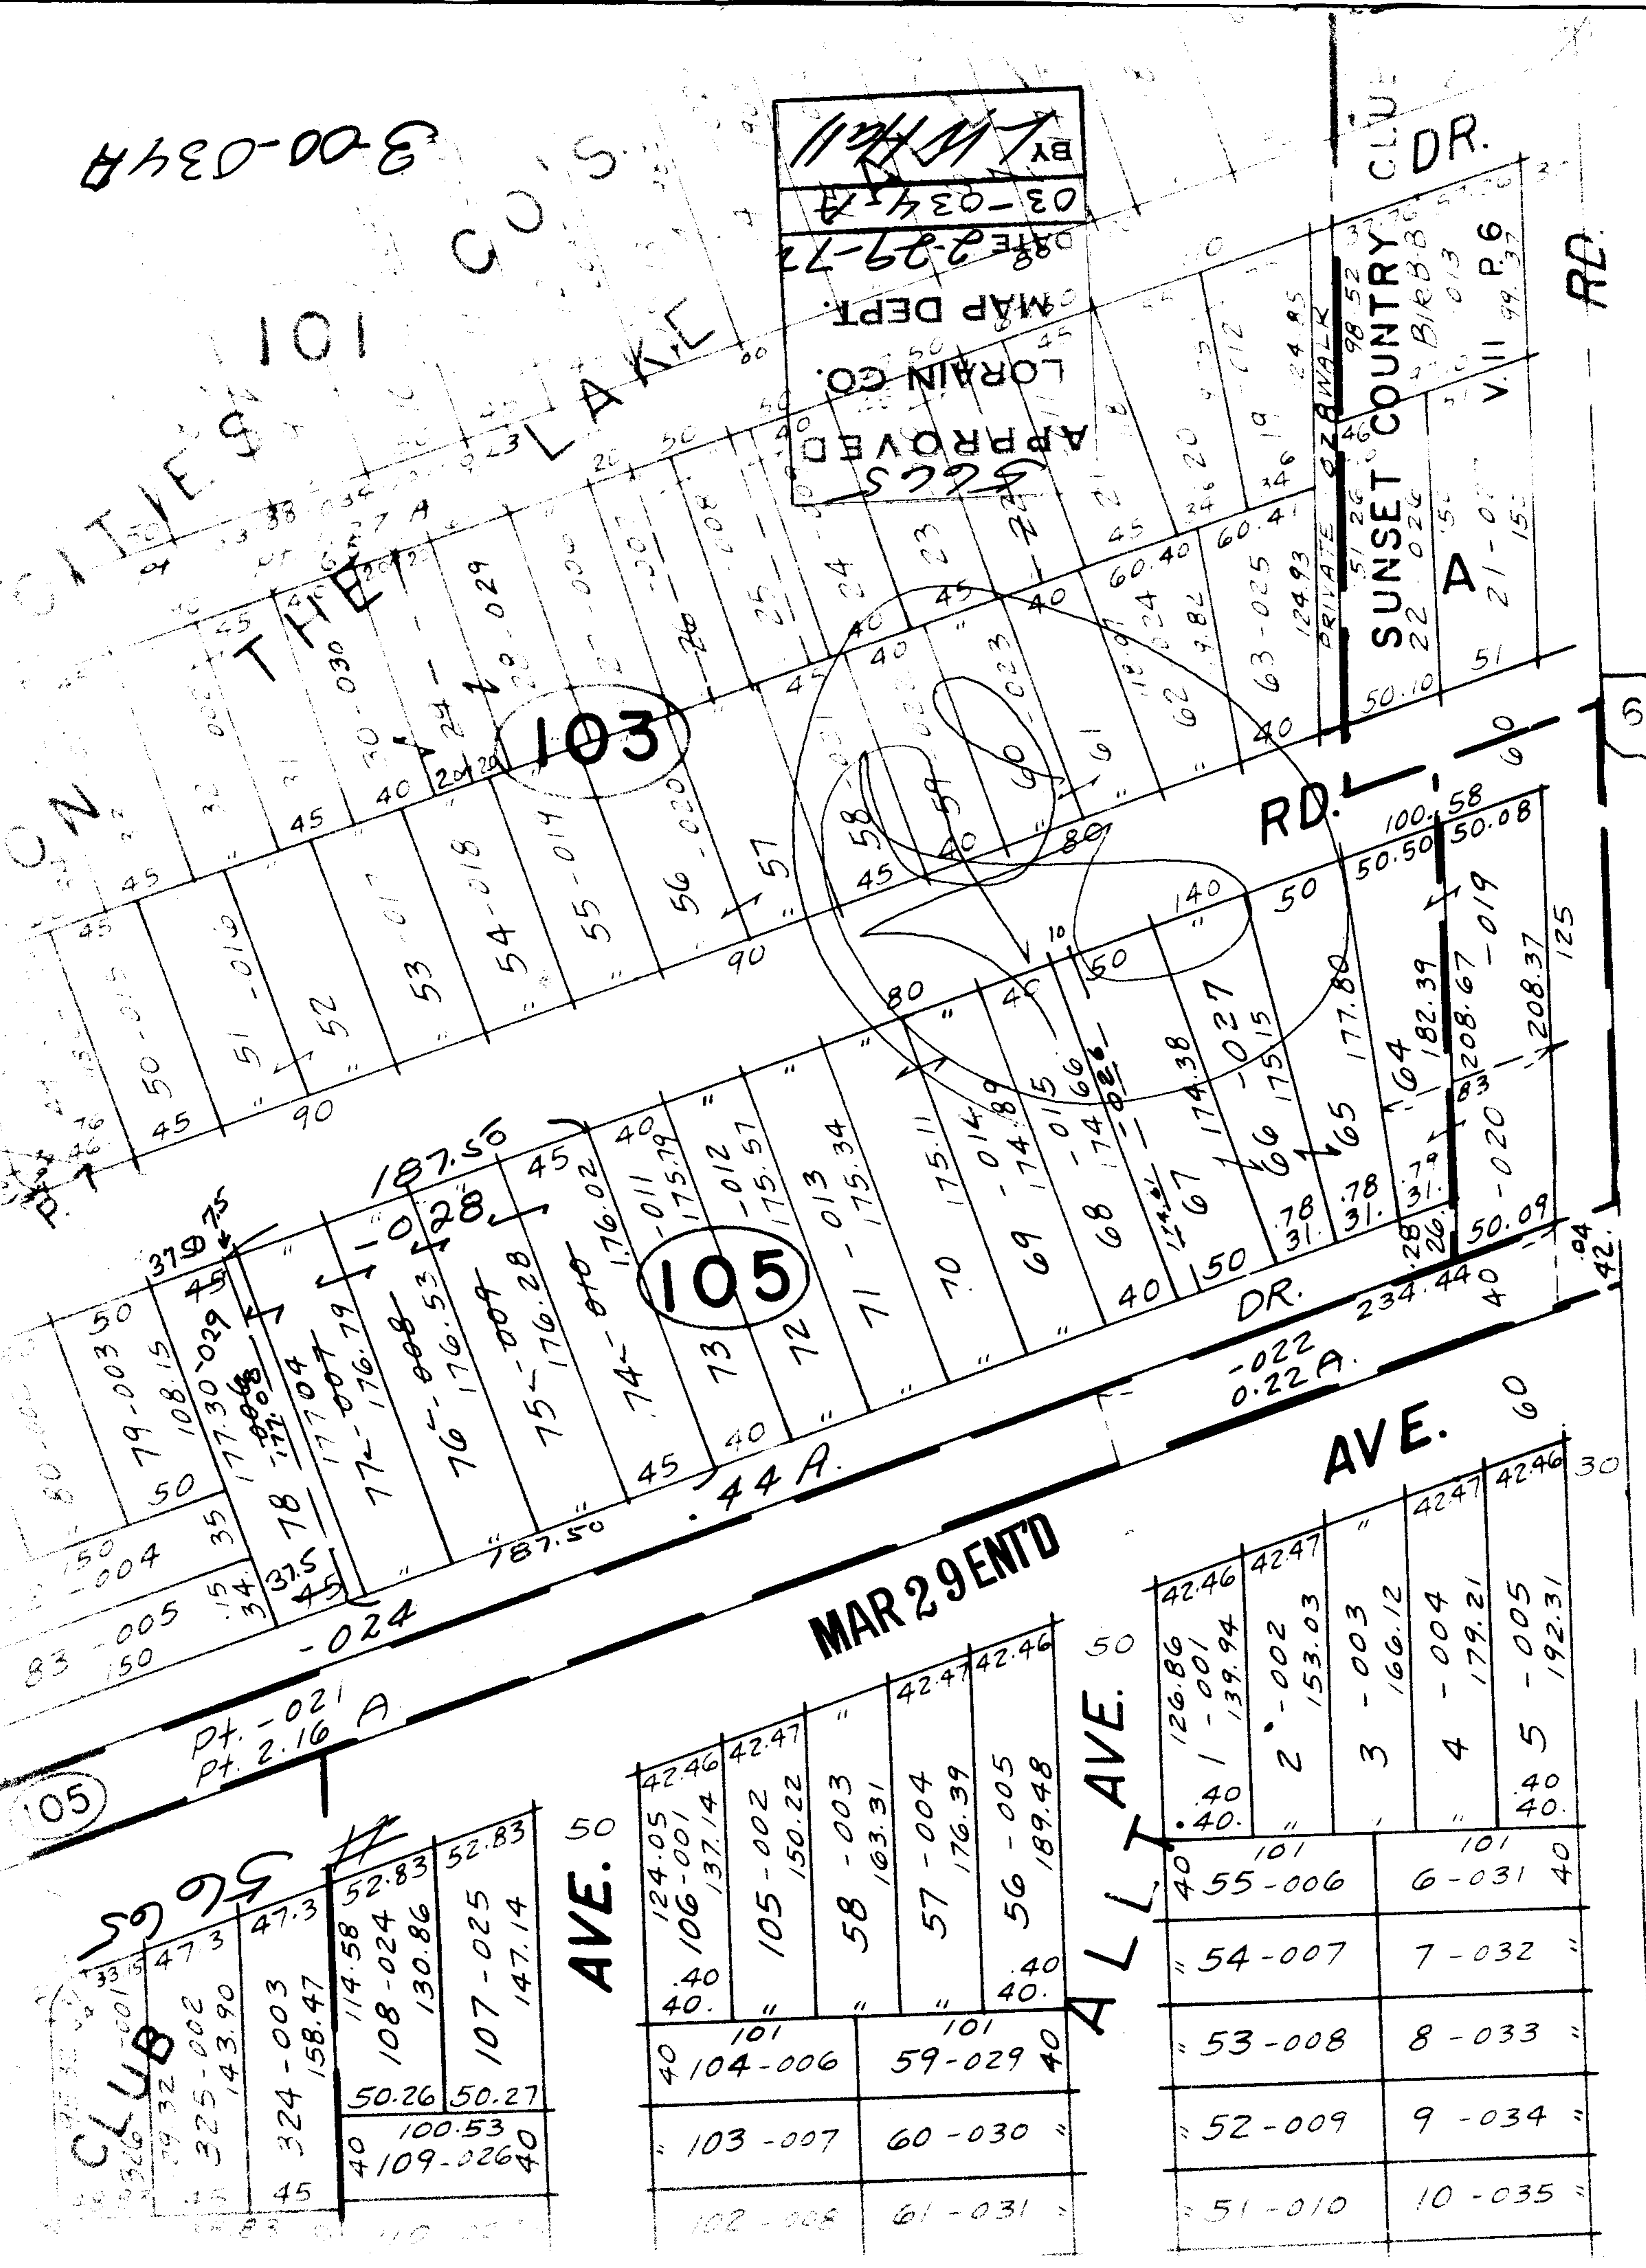

CLUB  
325-002  
143.90  
324-003  
158.47

47.3	47.3
50.26	52.83
100.53	52.83
109-026	147.14
40	40



(SEE 3-00-033-A)