
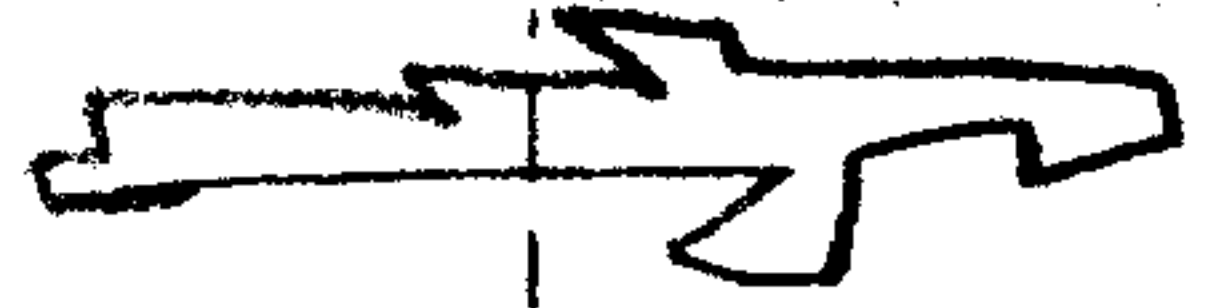
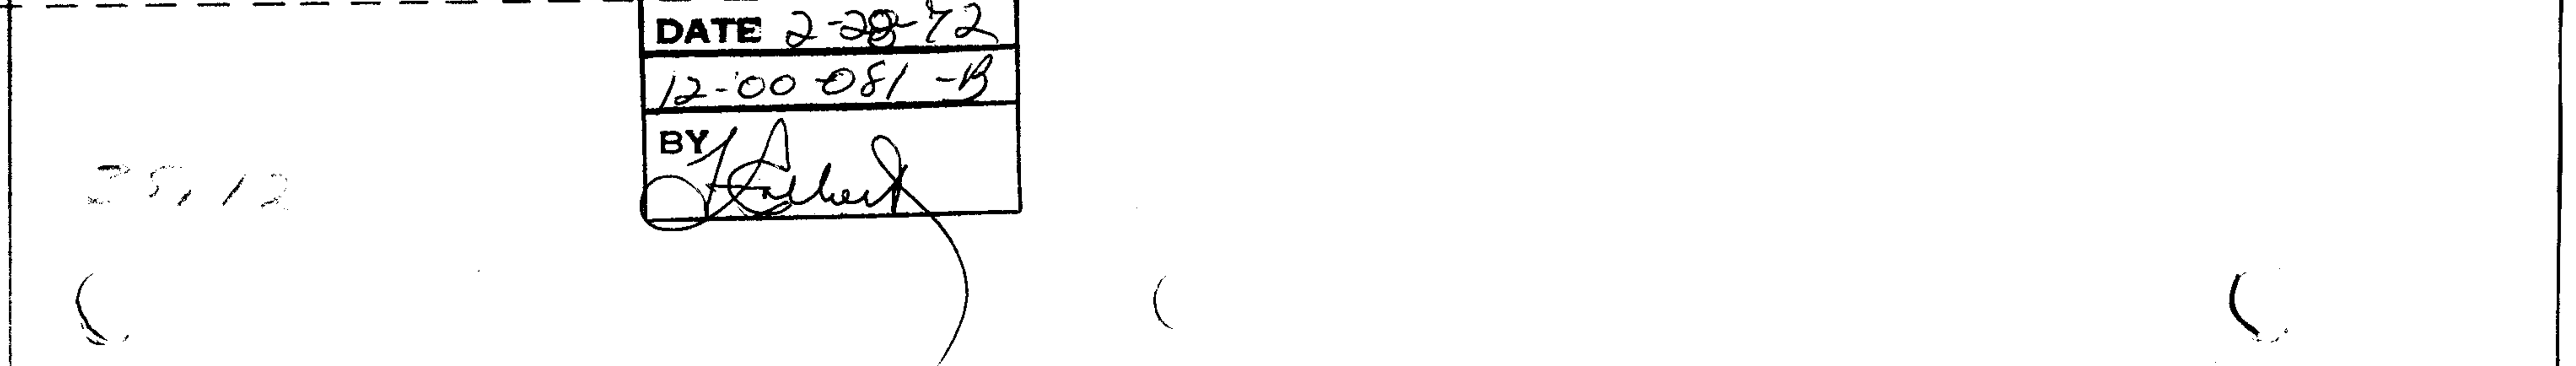
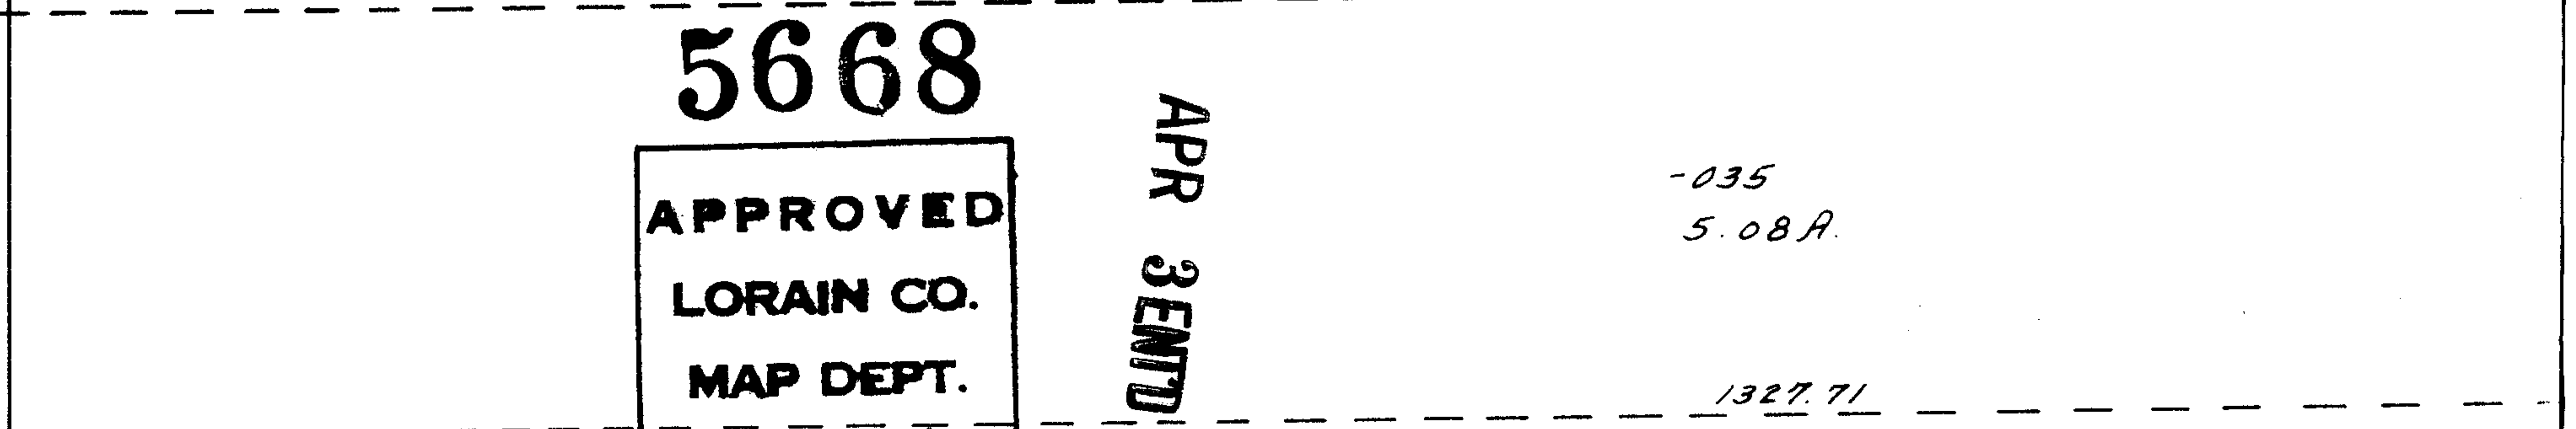
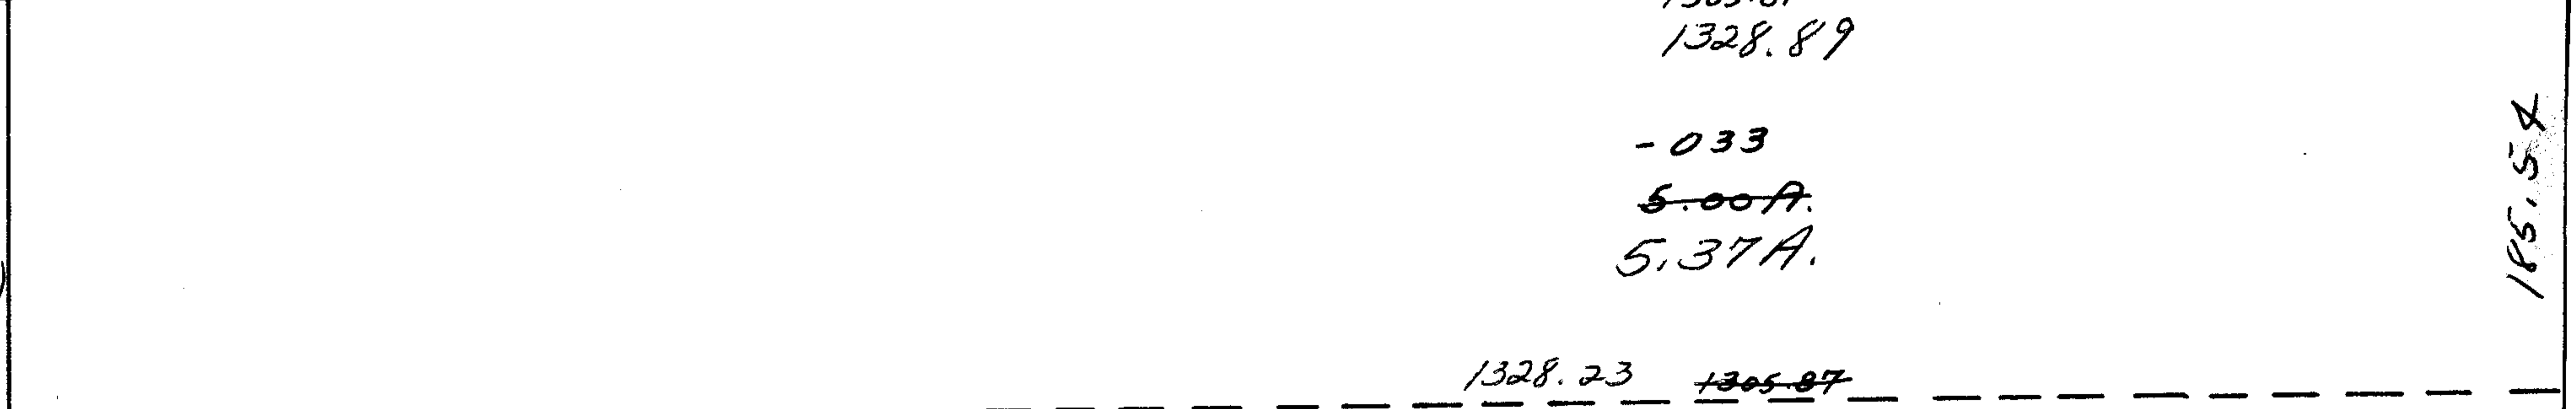


SEE 12-00-081-A Mitchell Rd.

To & Sprague Rd.  
1081.55

166.60

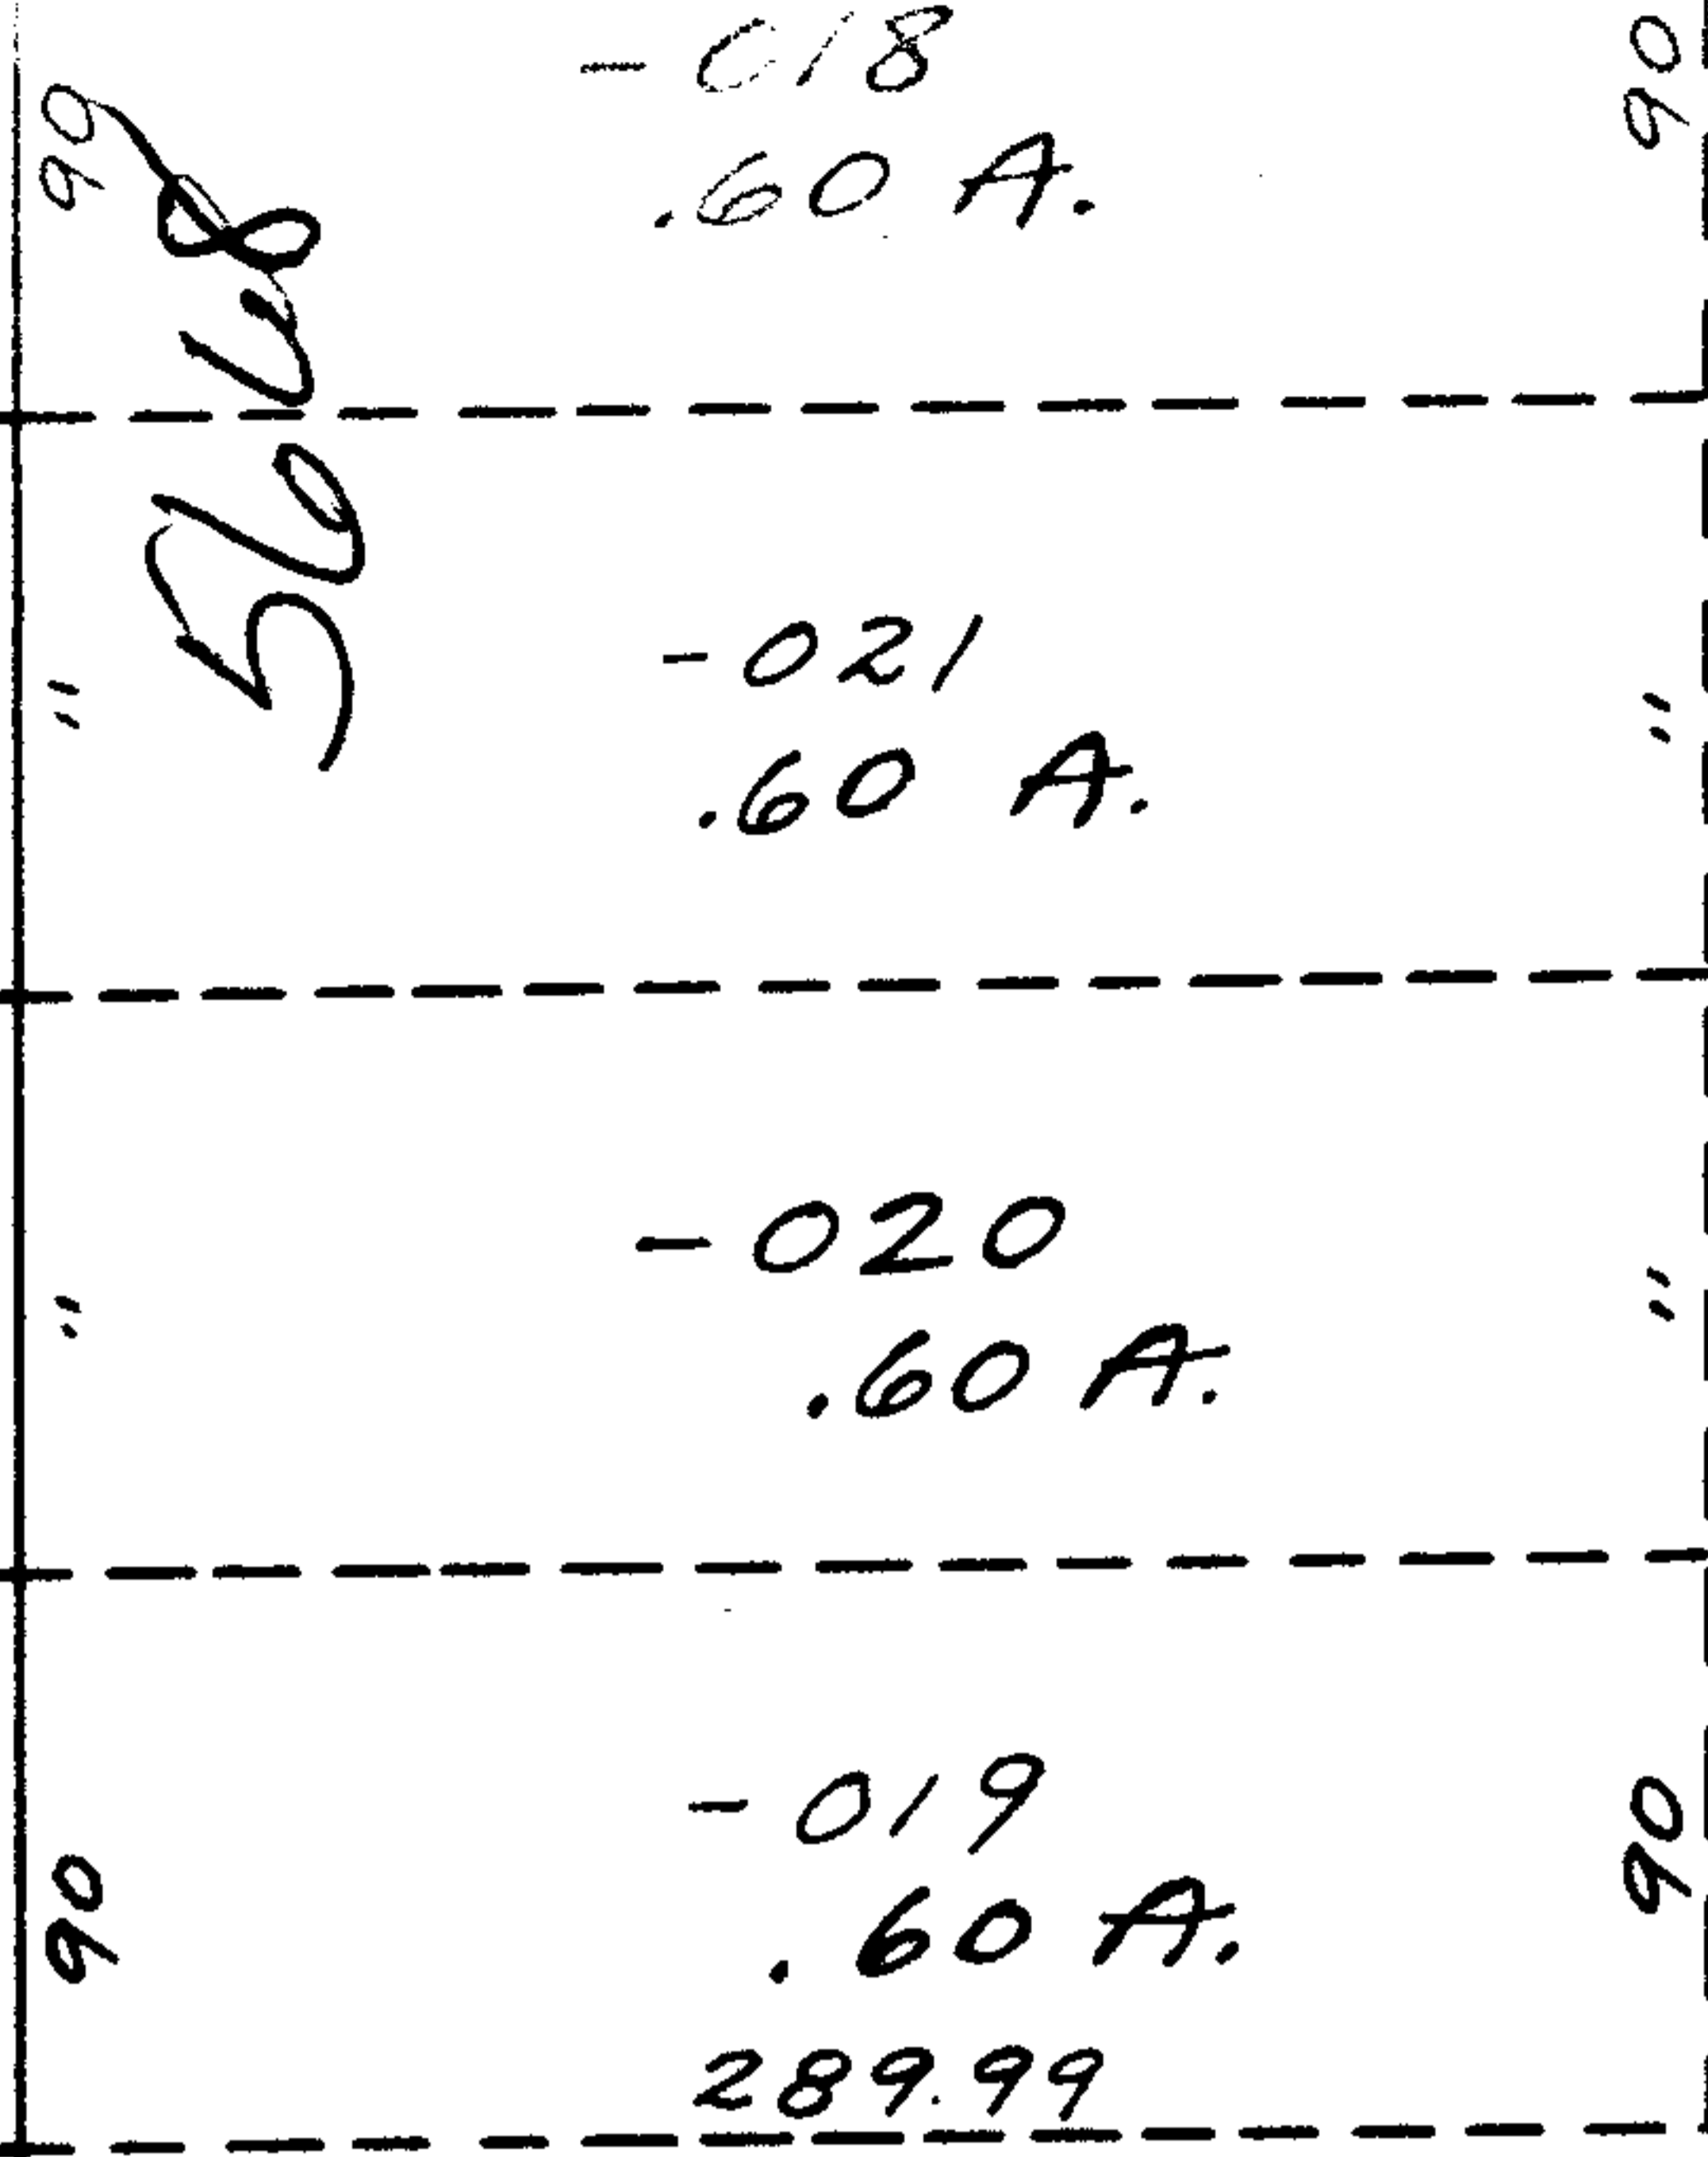

5668

**APPROVED**  
**LORAIN CO.**  
**MAP DEPT.**  
 DATE 2-28-72  
 12-00-081-B  
 BY *[Signature]*

APR 3 1972

25, 12

185.54