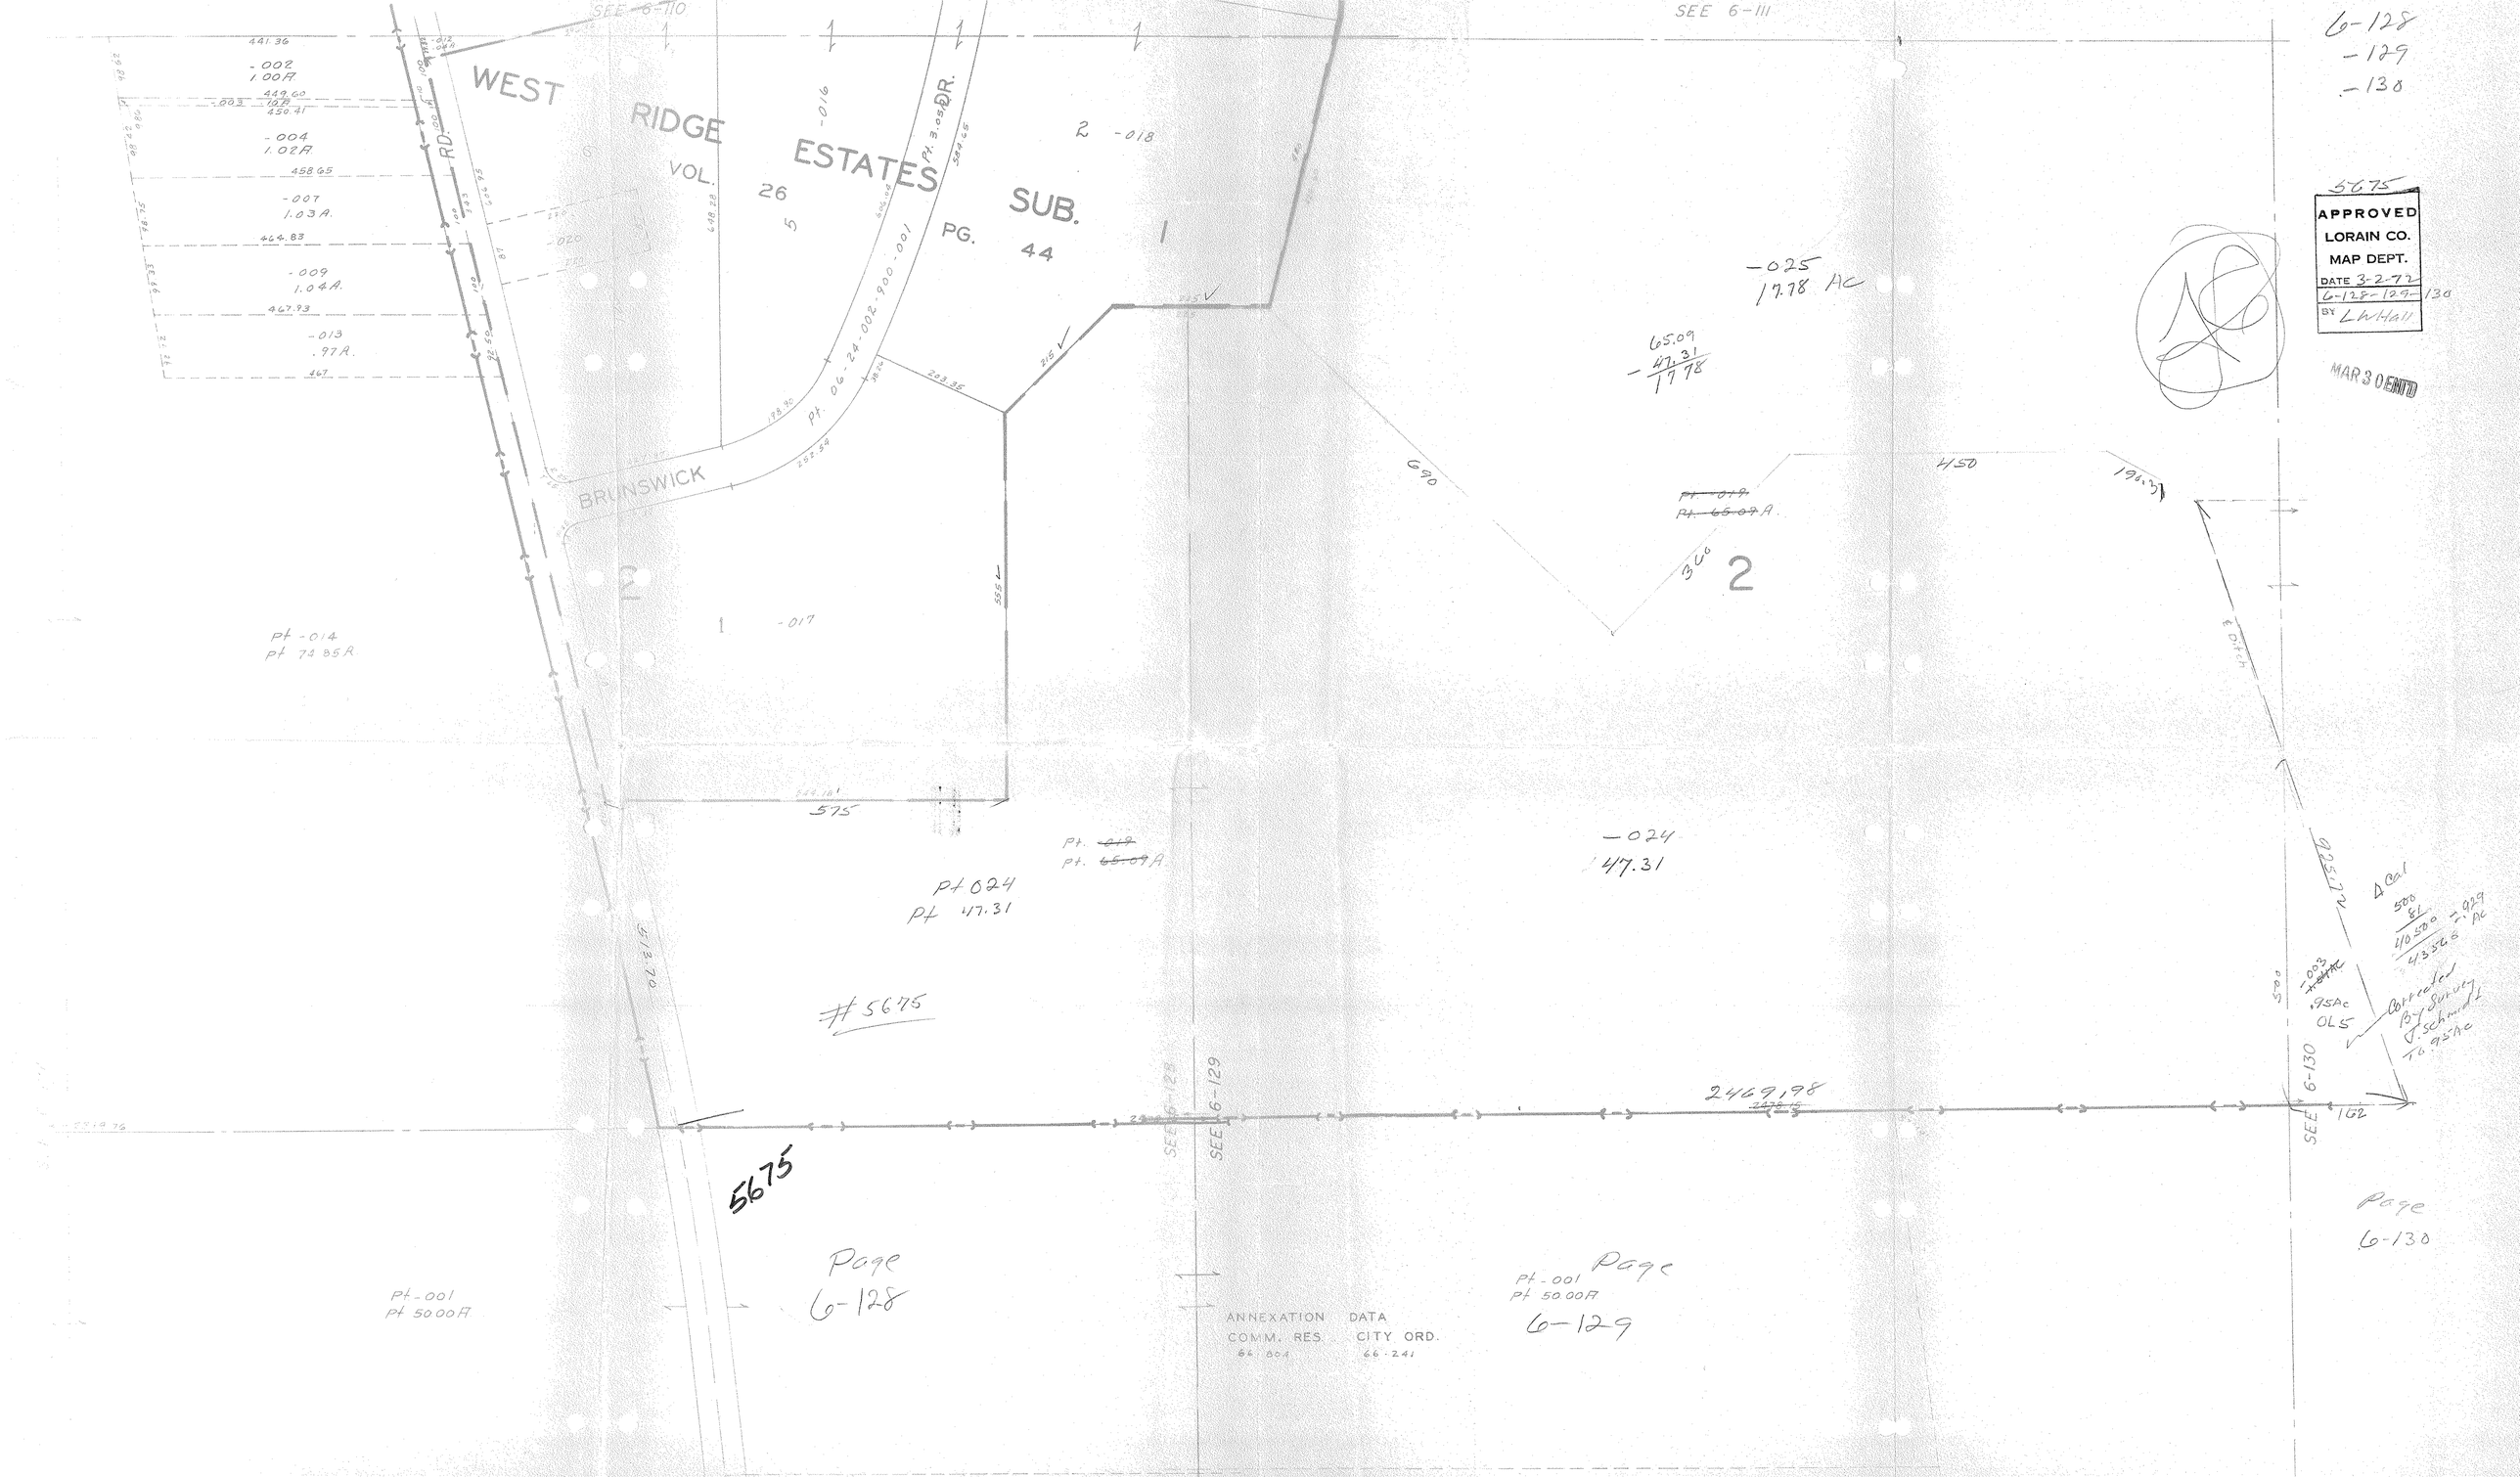
SEE 6-110
SEE 6-111
6-128
-129
-130
WEST RIDGE ESTATES SUB.
VOL. 26 PG. 44
RD.
DR.
BRUNSWICK
Pt. 06-24-002-900-001
Pt. 3.05 A
-016
-018
-017
-020
-025
17.78 AC
65.09
47.31
17.78
690
450
194.37
-014
Pt 74.85 R
-002
1.00 A
-003
-004
1.02 A
-007
1.03 A
-009
1.04 A
-013
.97 A
441.36
449.60
450.41
458.65
464.83
467.93
467
575
Pt. 019
Pt. 65.09 A
Pt 024
Pt 47.31
-024
47.31
#5675
5675
APPROVED
LORAIN CO.
MAP DEPT.
DATE 3-2-72
6-128-129-130
BY L W Hall
MAR 30 1972
SEE 6-129
SEE 6-130
2469.98
925.72
Page
6-128
Page
6-129
Page
6-130
Pt-001
Pt 50.00 A
ANNEXATION DATA
COMM. RES. 64-804
CITY ORD. 66-241