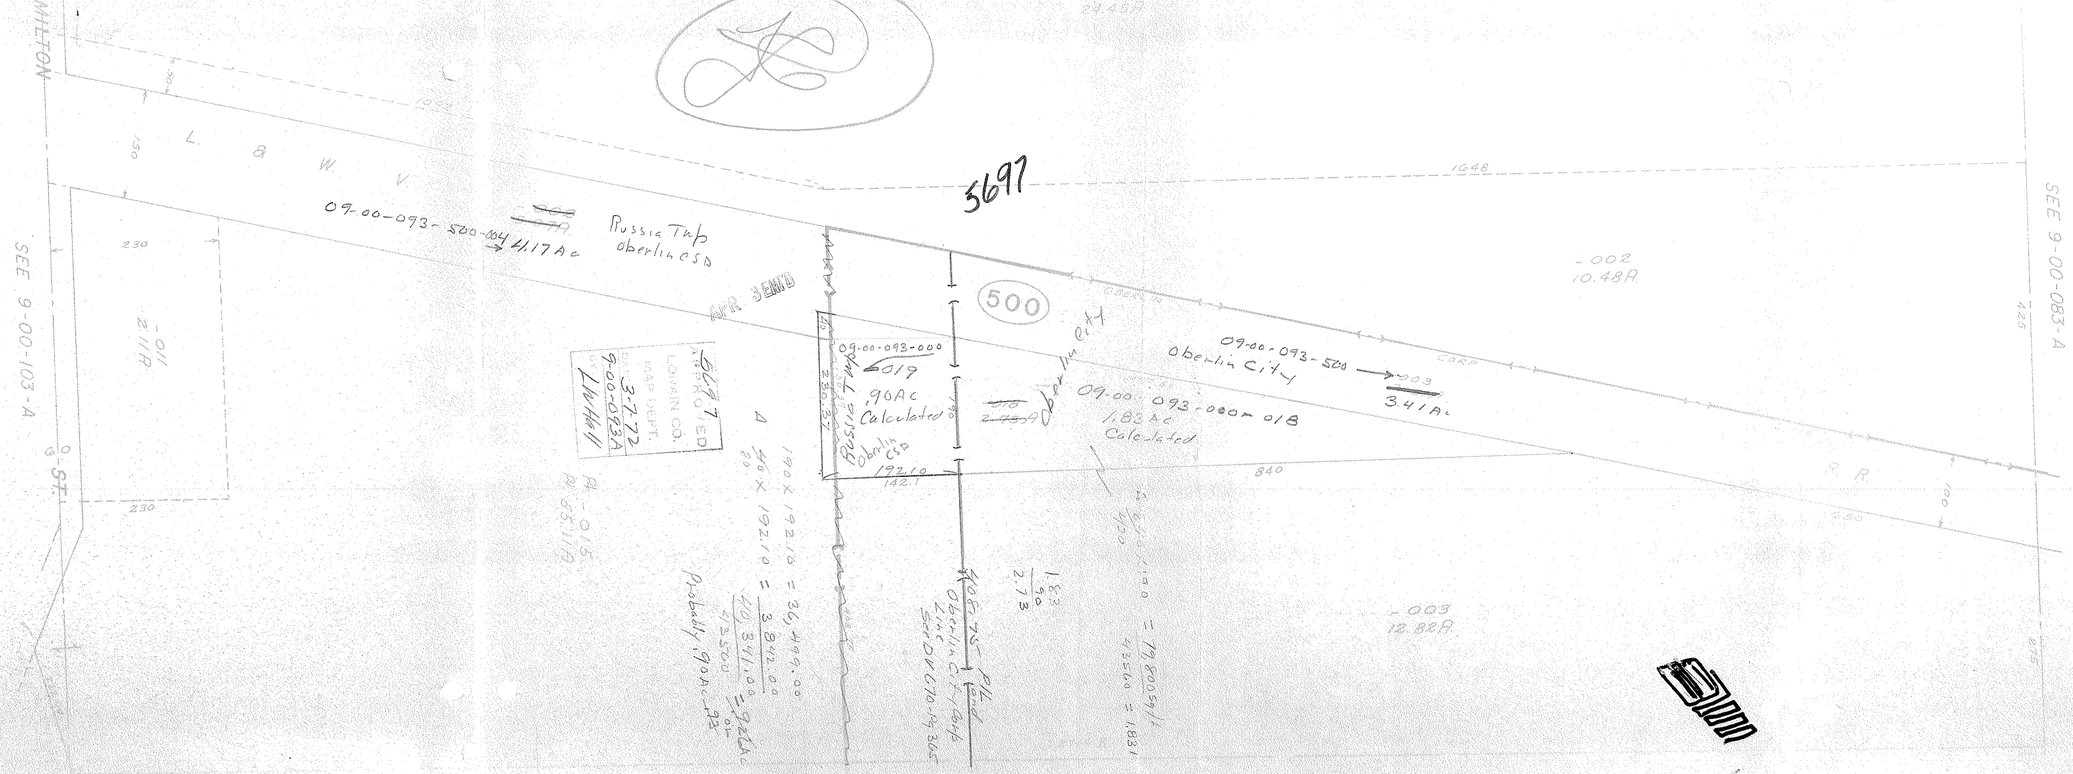
5697
09-00-093-500-004 4.17 Ac
Russia Twp
Oberlin CSD
500
09-00-093-000
019
.90Ac
Calculated
Russia Twp
Oberlin CSD
09-00-093-500
Oberlin City
3.41Ac
09-00-093-000 & 018
1.83 Ac
Calculated
Oberlin City
- 002
10.48A
- 003
12.82A
- 011
2.11A
SEE 9-00-083-A
SEE 9-00-103-A
L. & W. V.
MILTON
1648
840
150
230
425
100
CORP
R. R.
ST.
5697
LORAIN CO.
MAP DEPT.
3-7-72
9-00-093A
Lb Hall
Probably .90 A. 22