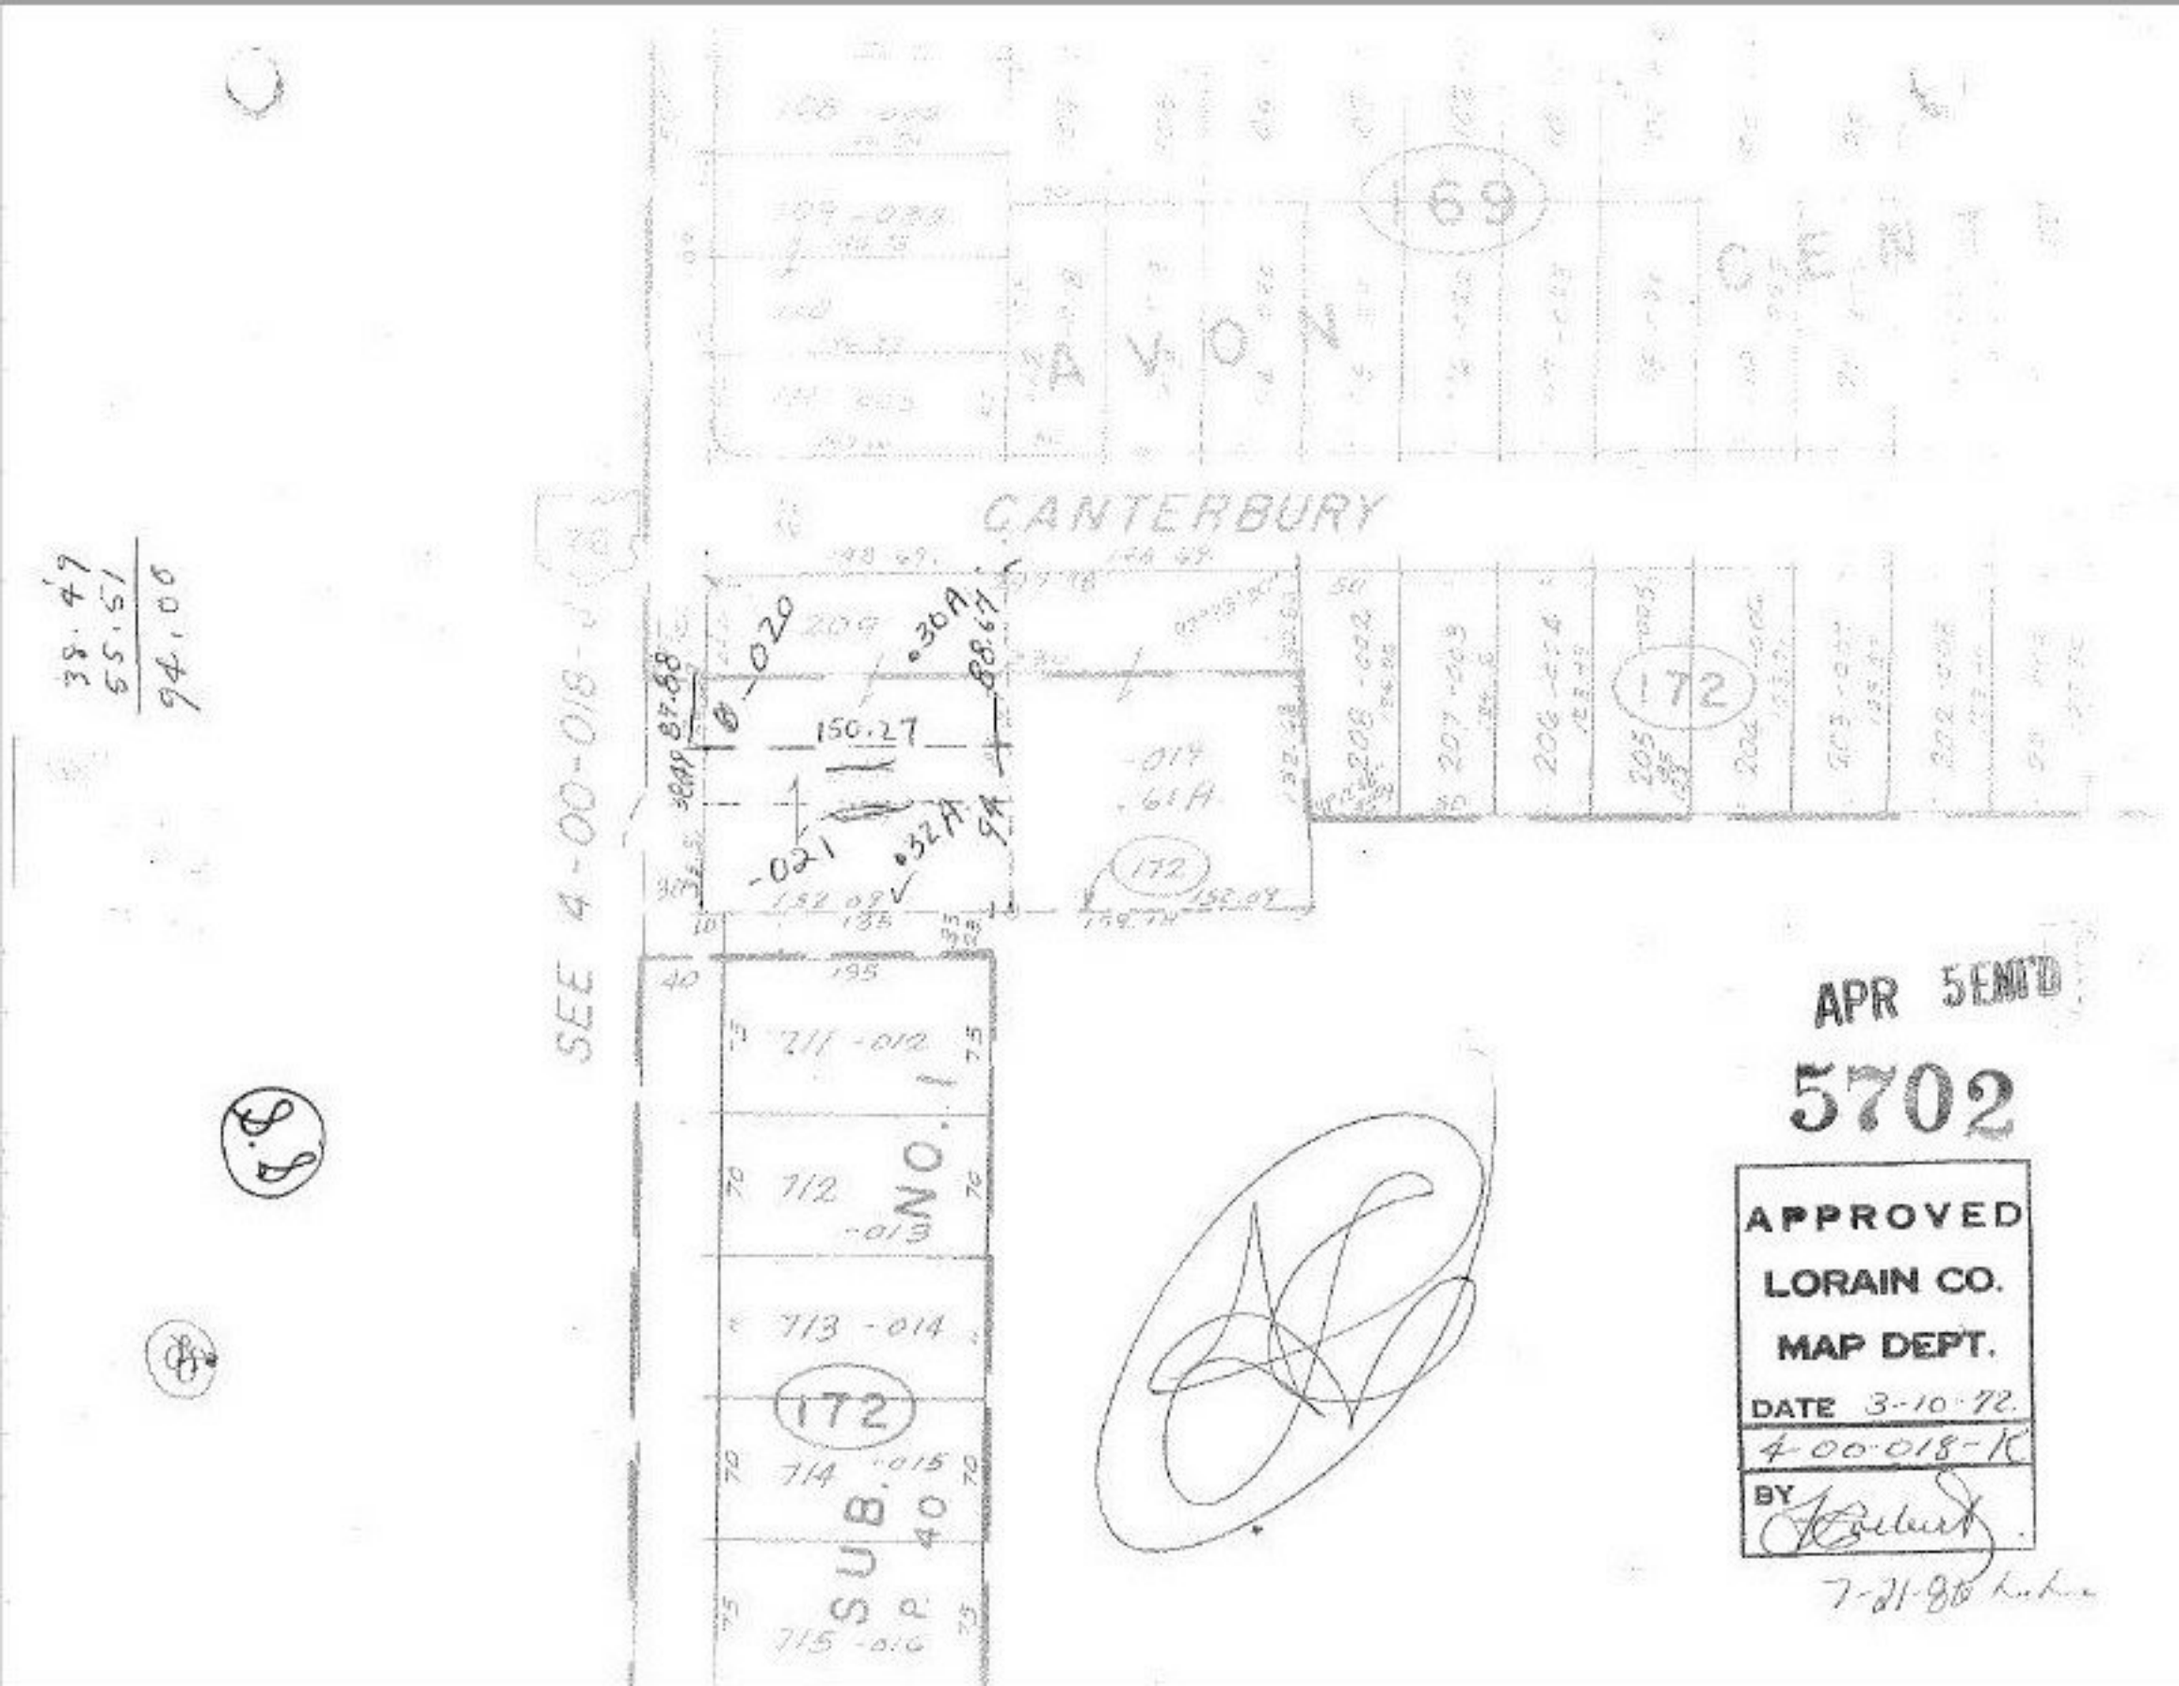
AVON
69
CANTERBURY
SEE 4-00-018-J
38.47
55.51
94.00
-020
.30A
88.67
87.68
150.27
-021
.32A
.61A
-017
172
SUB. NO. 1
711 -012
712 -013
713 -014
714 -015
715 -016
40
APR 5 ENTD
5702
APPROVED
LORAIN CO.
MAP DEPT.
DATE 3-10-72.
4-00-018-K
BY
7-21-86