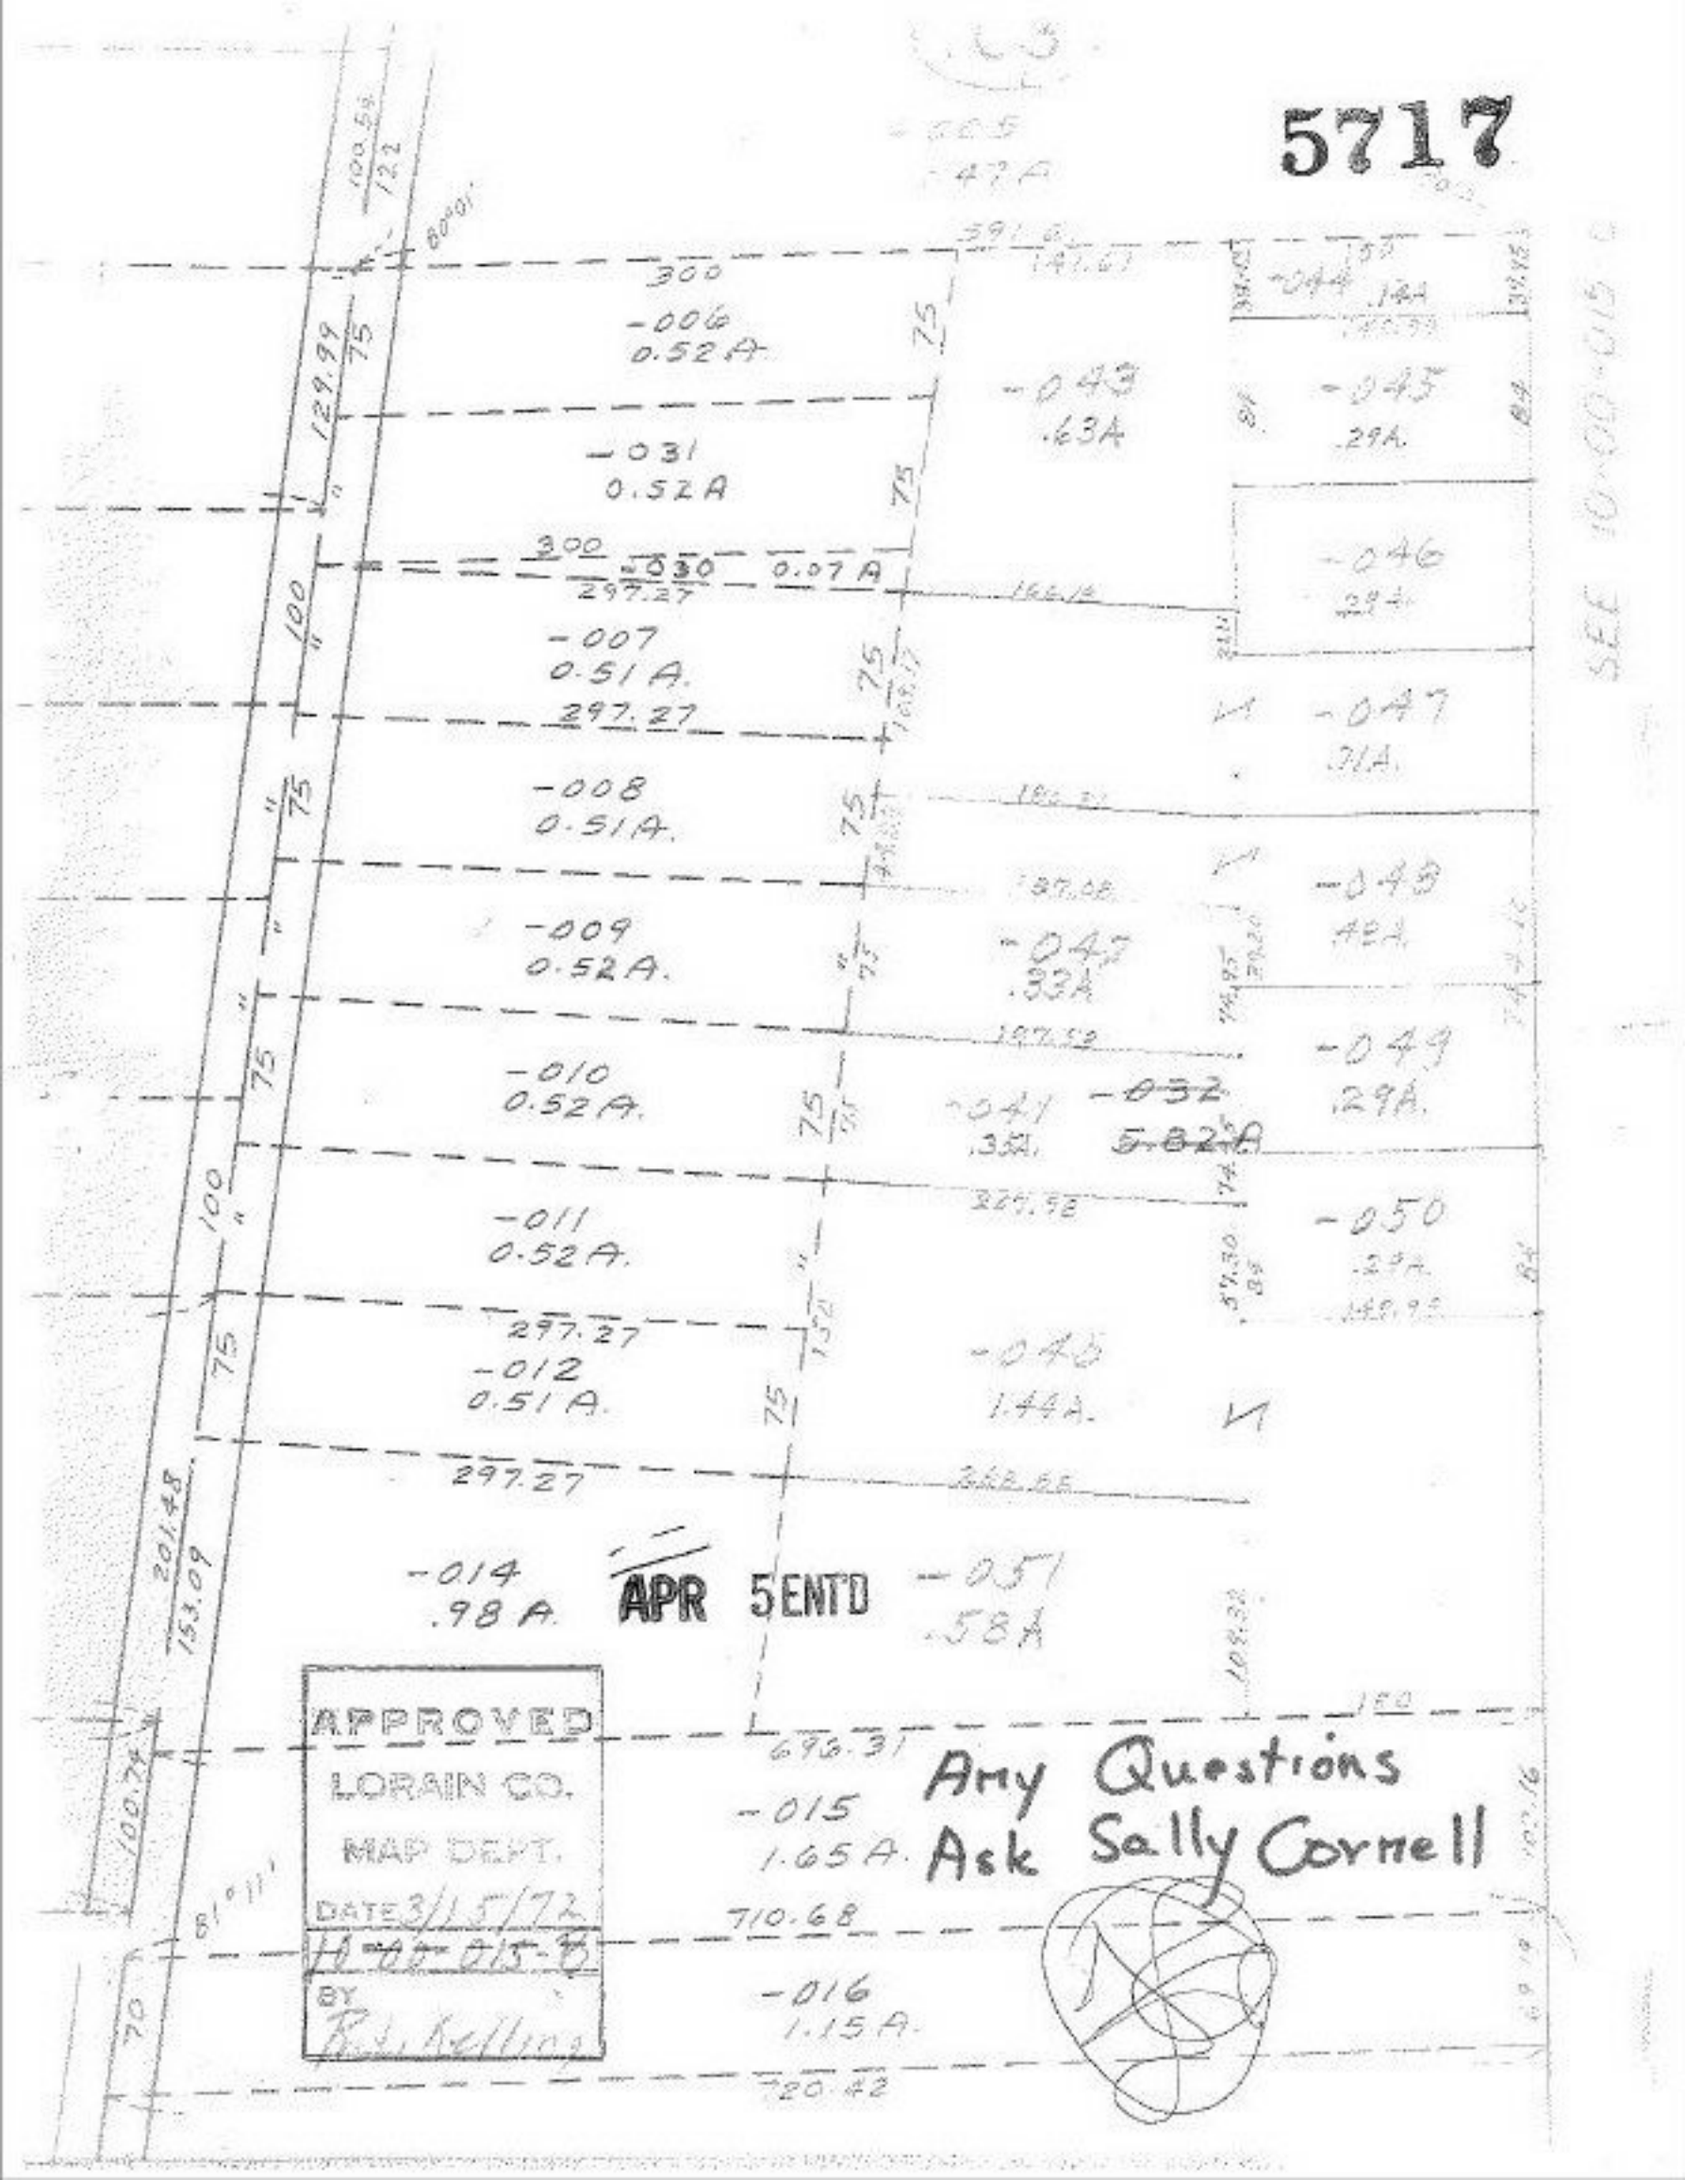
5717
-006
0.52A.
-031
0.52A
-030
0.07A
-007
0.51A.
-008
0.51A.
-009
0.52A.
-010
0.52A.
-011
0.52A.
-012
0.51A.
-014
.98A
-043
.63A
-047
.93A
-041
.35A.
-045
.29A.
-046
.29A.
-047
.71A.
-048
.42A.
-049
.29A.
-050
.29A.
-045
1.44A.
-051
.58A
-015
1.65A.
-016
1.15A.
APR 5 ENTD
APPROVED
LORAIN CO.
MAP DEPT.
DATE 3/15/72
BY R.J. Kelling
Any Questions
Ask Sally Cornell
SEE 10-00-015