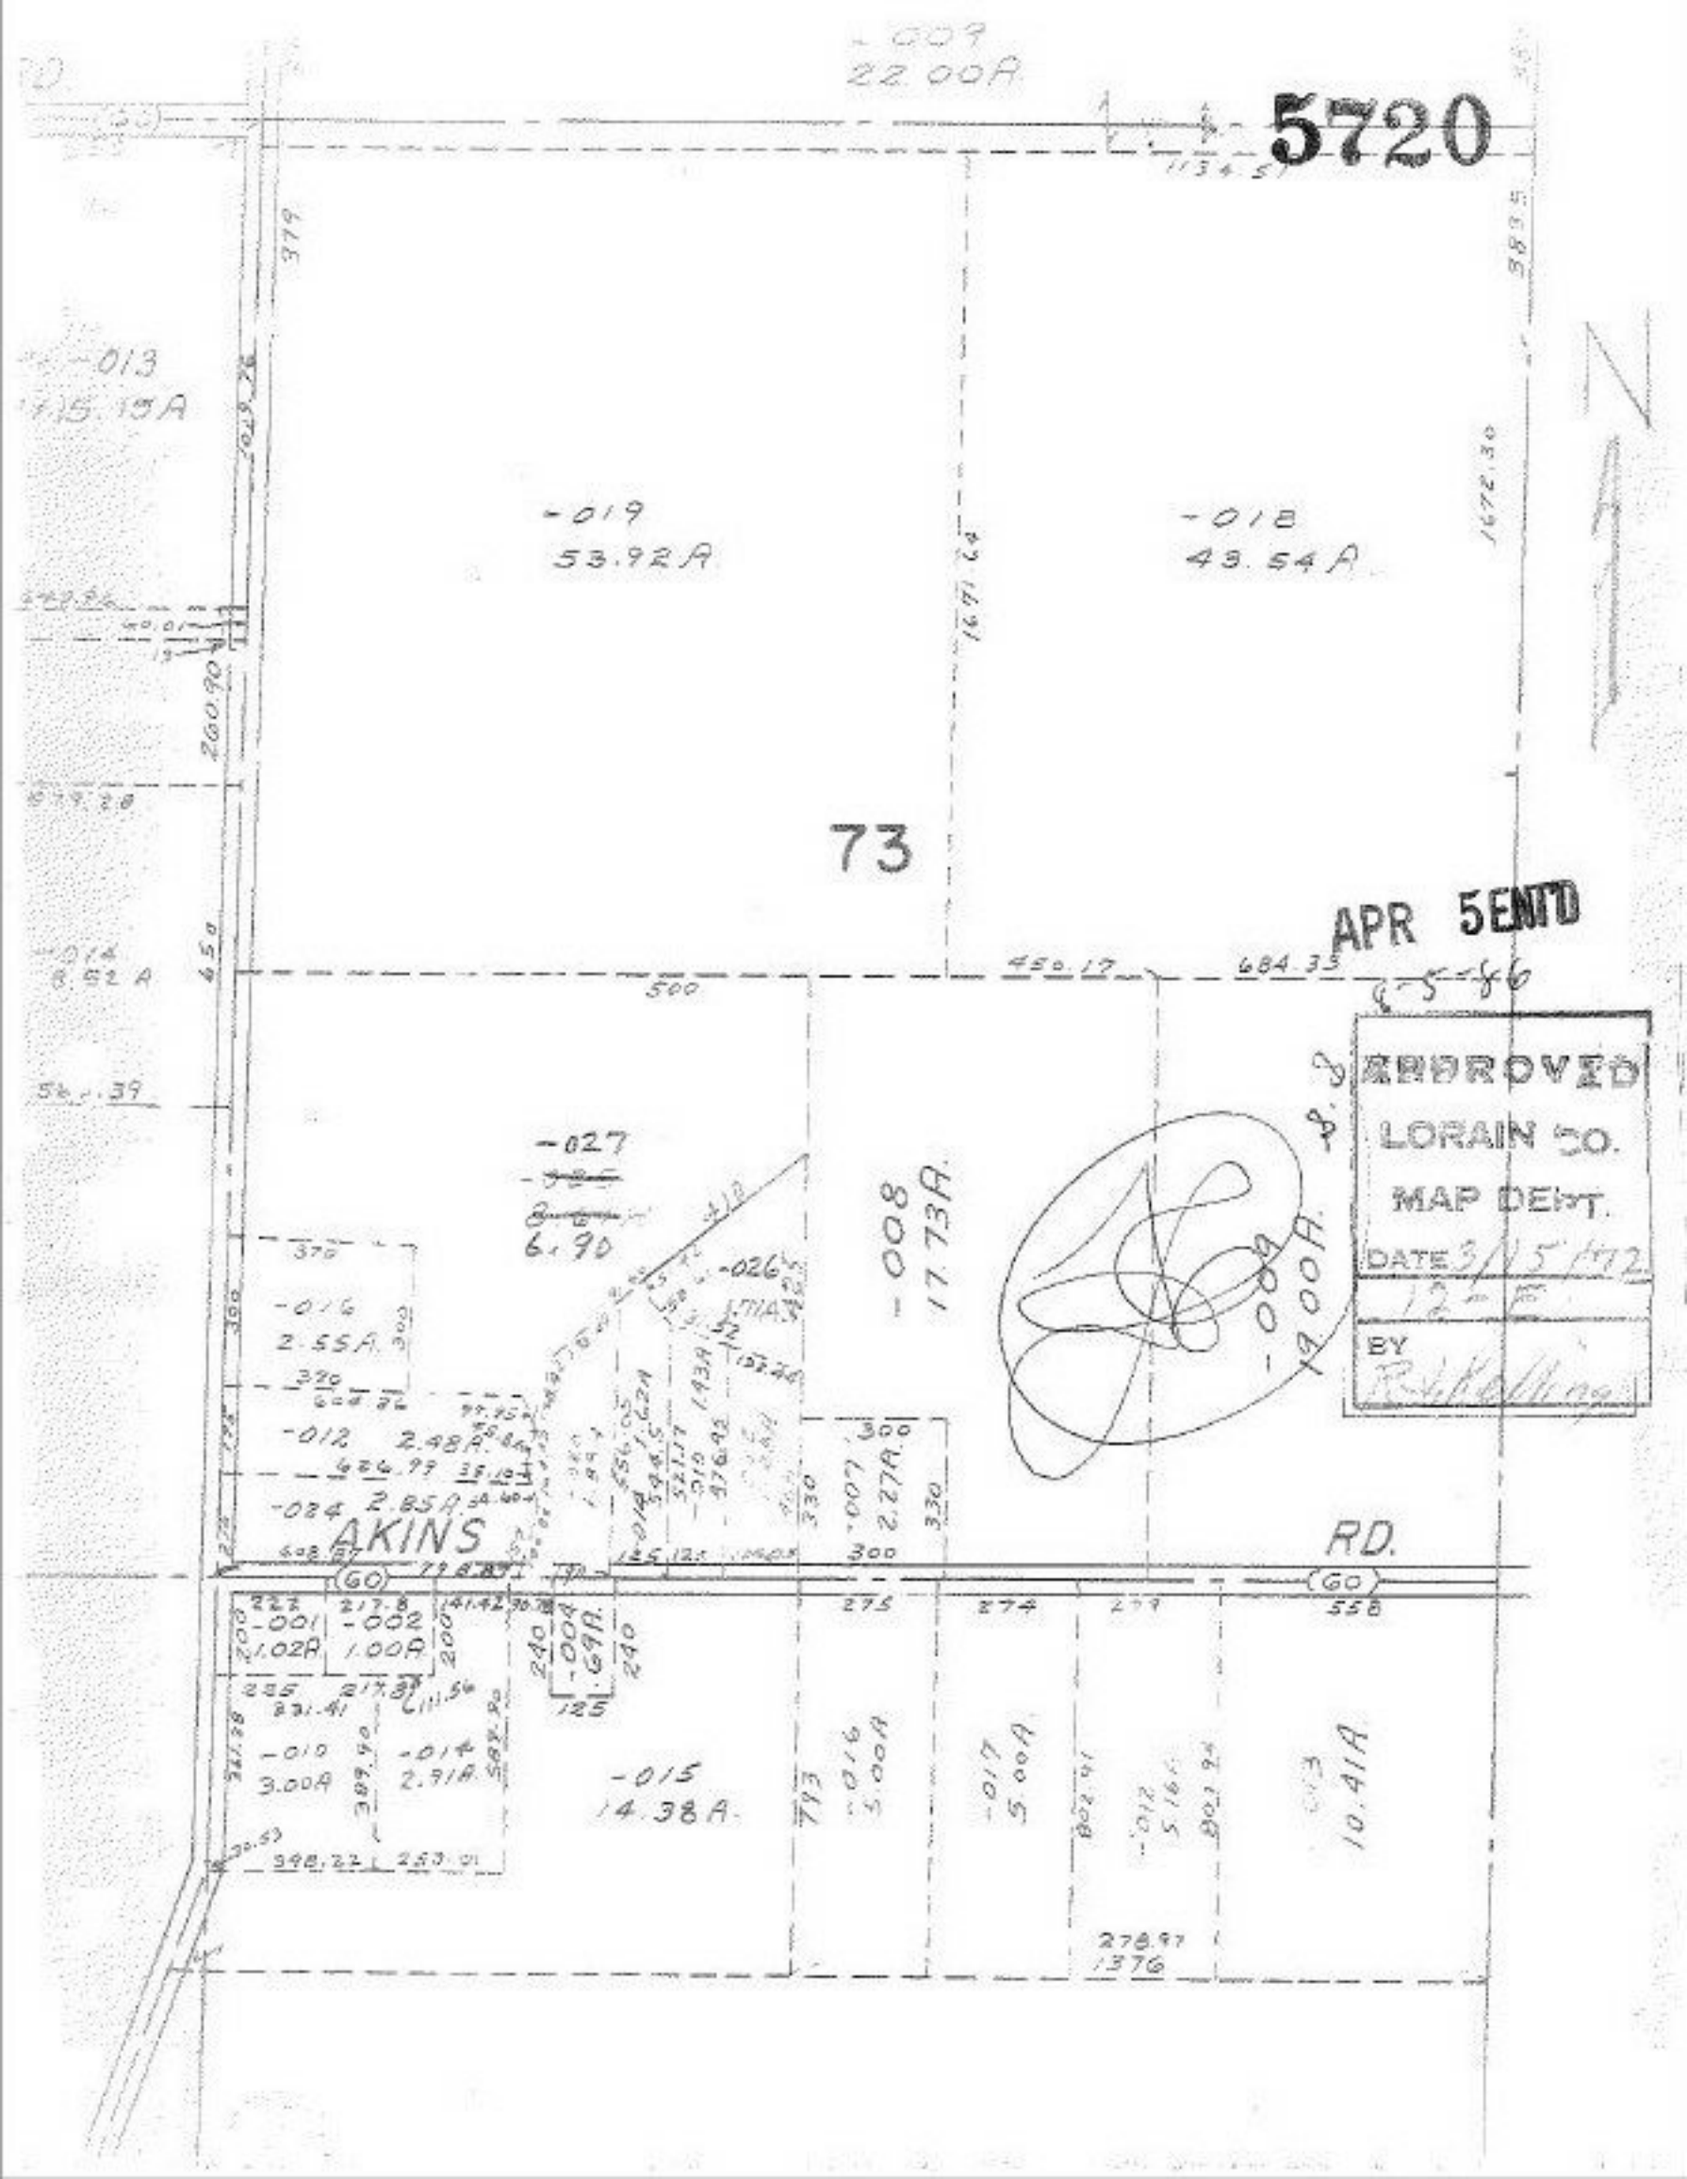
5720
73
-009
22.00A.
-013
15.15A
-019
53.92A
-018
49.54A
-014
8.52A
-027
6.90
-026
-008
17.73A.
-009
19.00A.
-012
2.48A.
-024
2.85A.
-016
2.55A.
-001
2.02A.
-002
1.00A.
-004
.69A.
-010
3.00A.
-014
2.91A.
-015
14.38A.
-016
5.00A.
-017
5.00A.
-013
10.41A.
AKINS
RD.
APR 5 ENTD
APPROVED
LORAIN CO.
MAP DEPT.
DATE 3/15/72
BY