5725

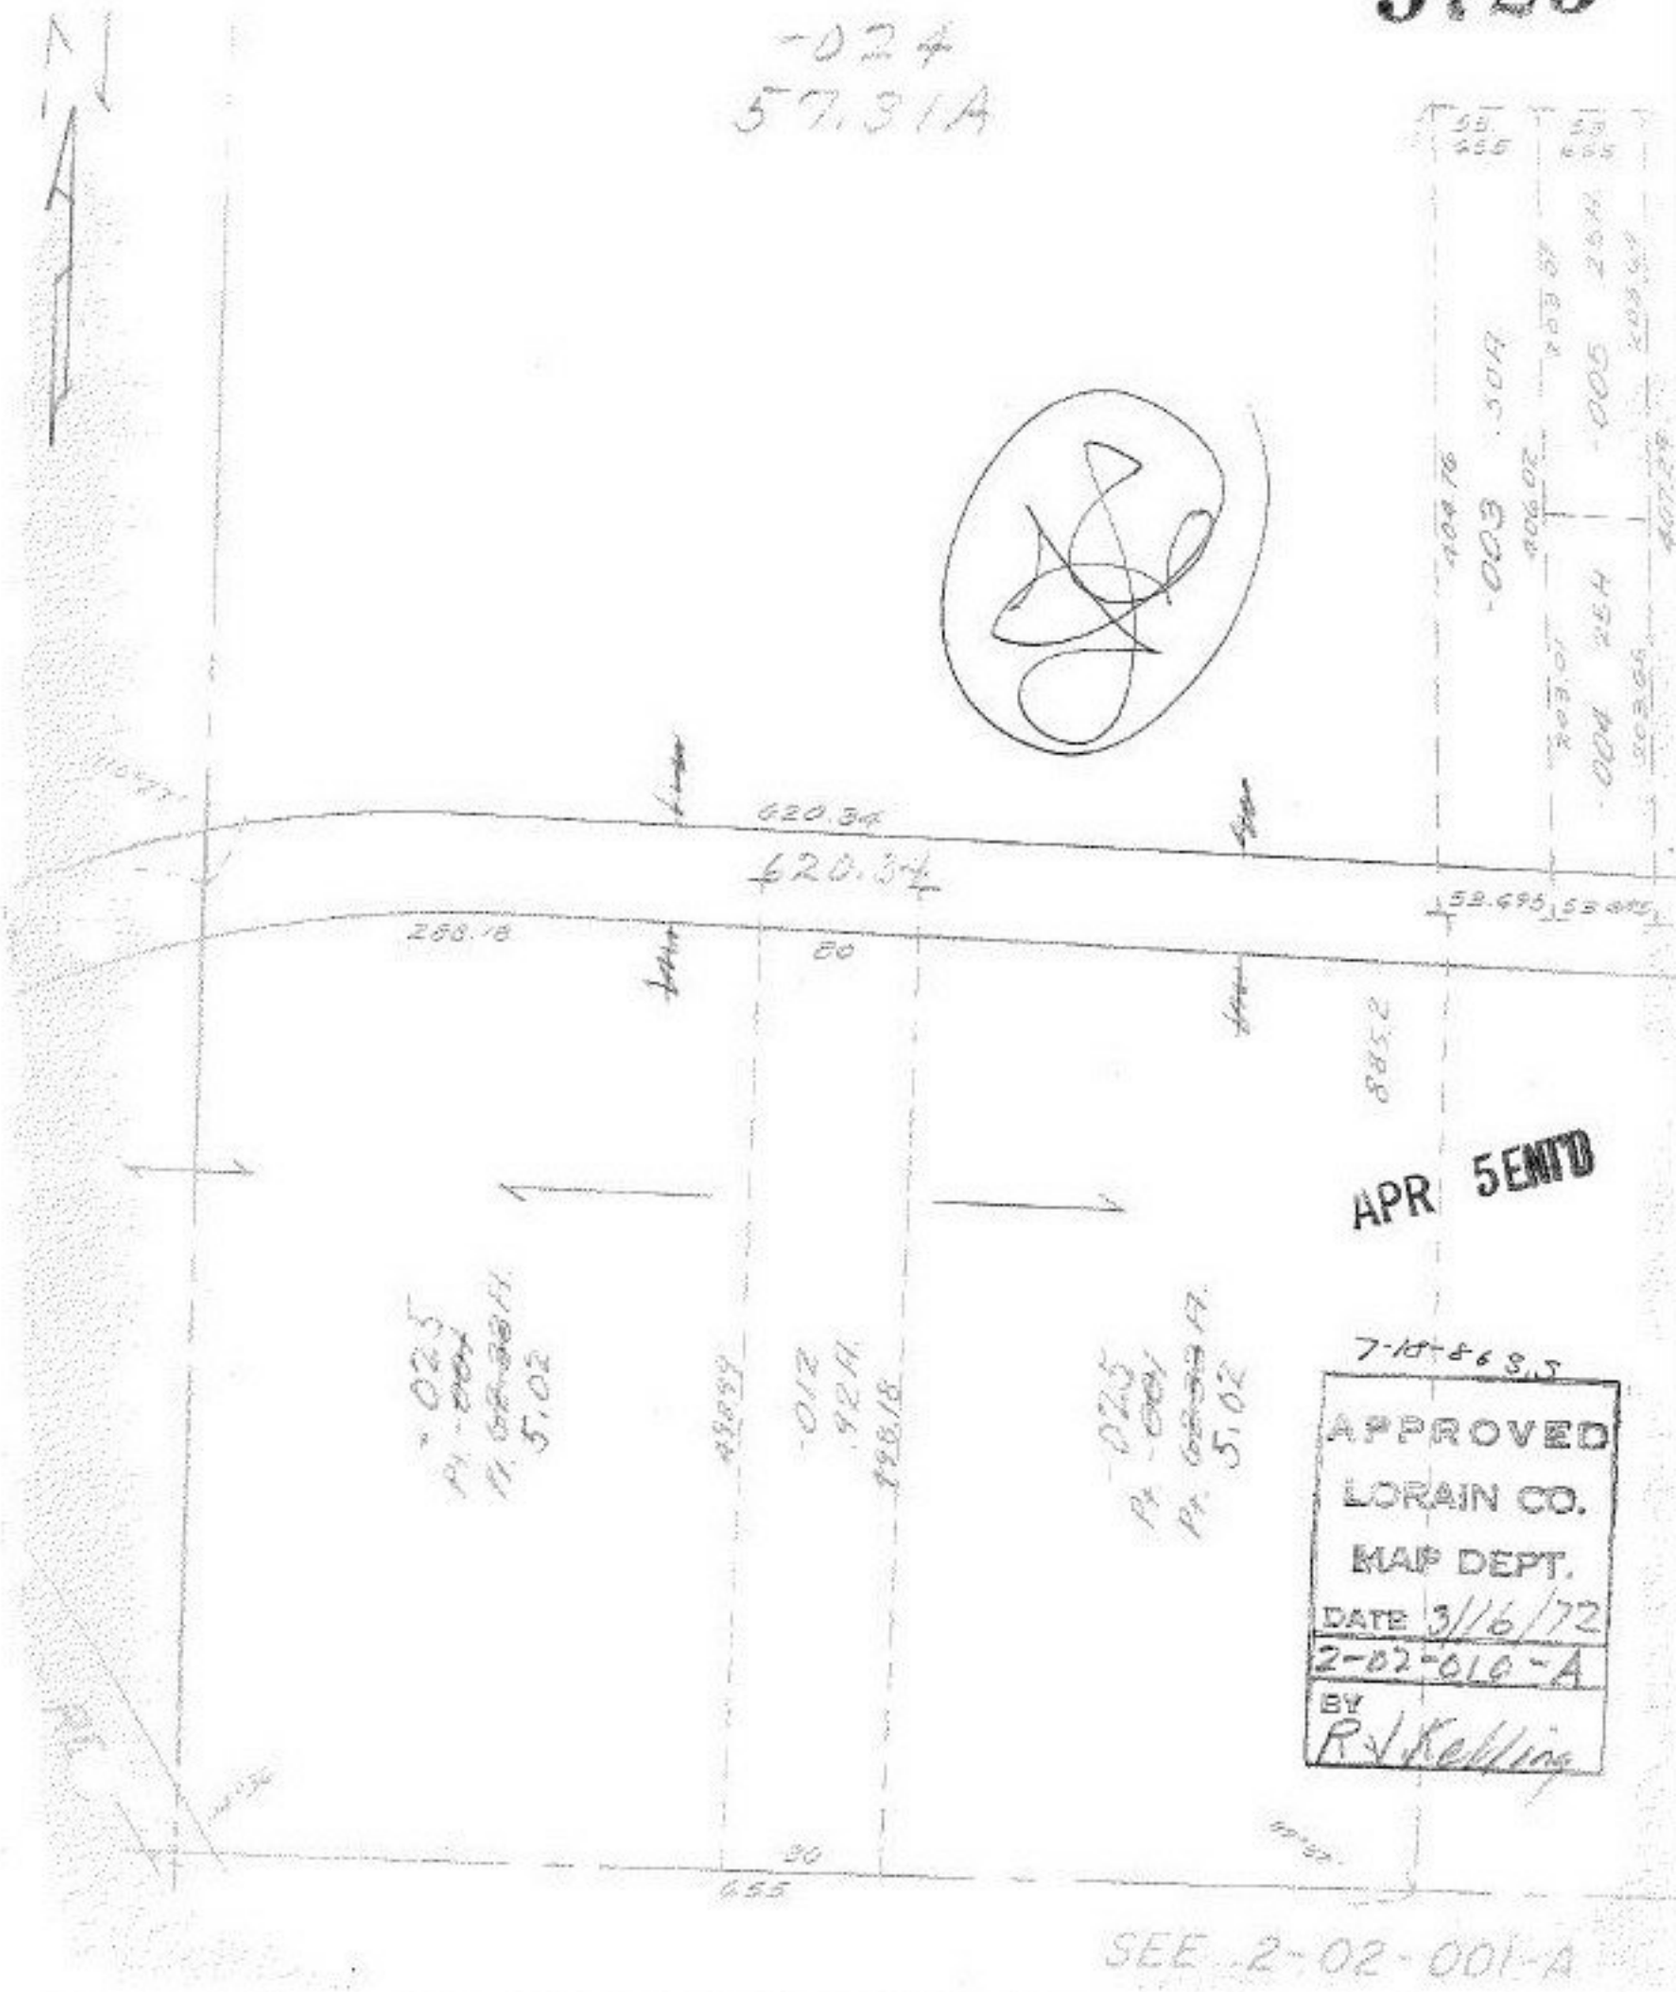

-024
57.31A
620.34
620.34
288.18
80
885.2
-025
5.02
-012
.92A
498.18
-025
5.02
-003
.50A
-005
-004
.25A
APR 5 ENT'D
7-18-86 S.S
APPROVED
LORAIN CO.
MAP DEPT.
DATE 3/16/72
2-02-010-A
BY
R J Kelling
SEE 2-02-001-A