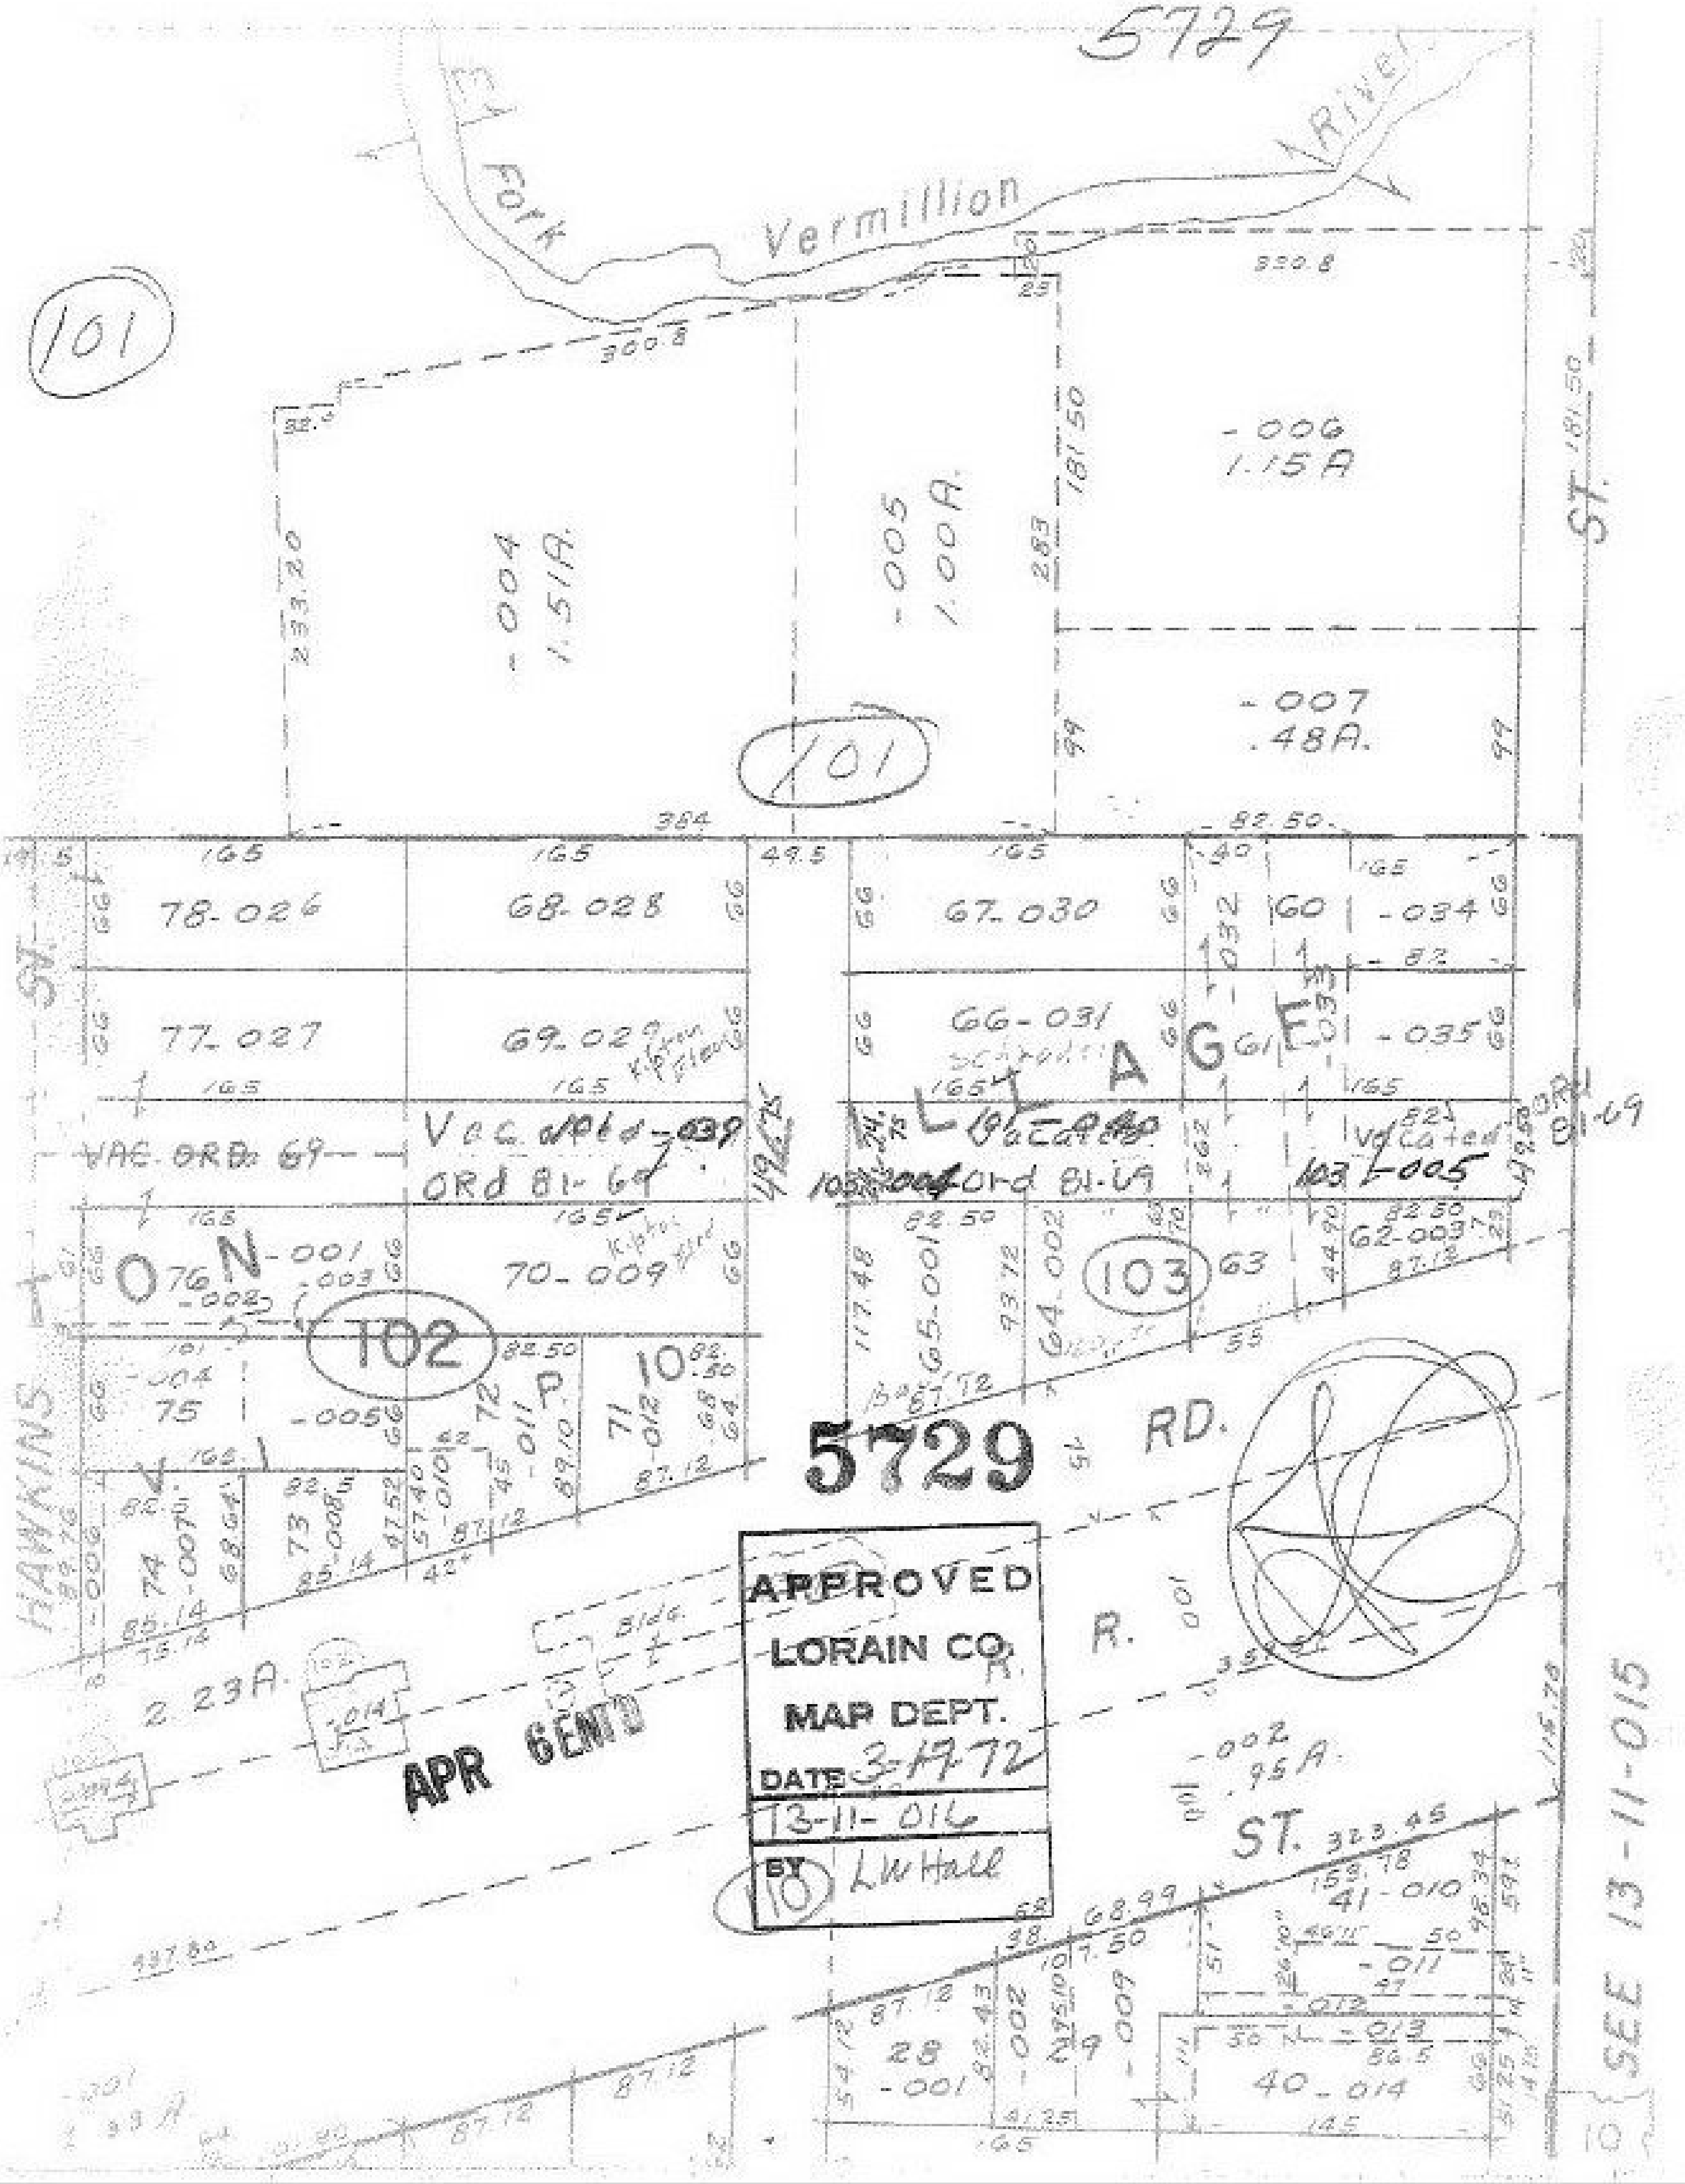

5729
Fork
Vermillion
River
101
-006
1.15A
-005
1.00A
-004
1.51A
-007
.48A
78-026
68-028
67-030
-034
77-027
69-029
66-031
-035
VAC. ORD. 69
Vac. Ord 81-69
Vacated Ord 81-69
70-009
102
103
HAWKINS ST.
5729
RD.
2.23A
APPROVED
LORAIN CO.
MAP DEPT.
DATE 3-19-72
13-11-016
BY LW Hall
APR 6 1972
-002
.95A
ST.
41-010
-011
-013
40-014
28
-001
SEE 13-11-015