APPROVED
LORAIN CO.
MAP DEPT.
DATE 3-20-72

APR 5731

ENTD

SEE 11-00-099-B

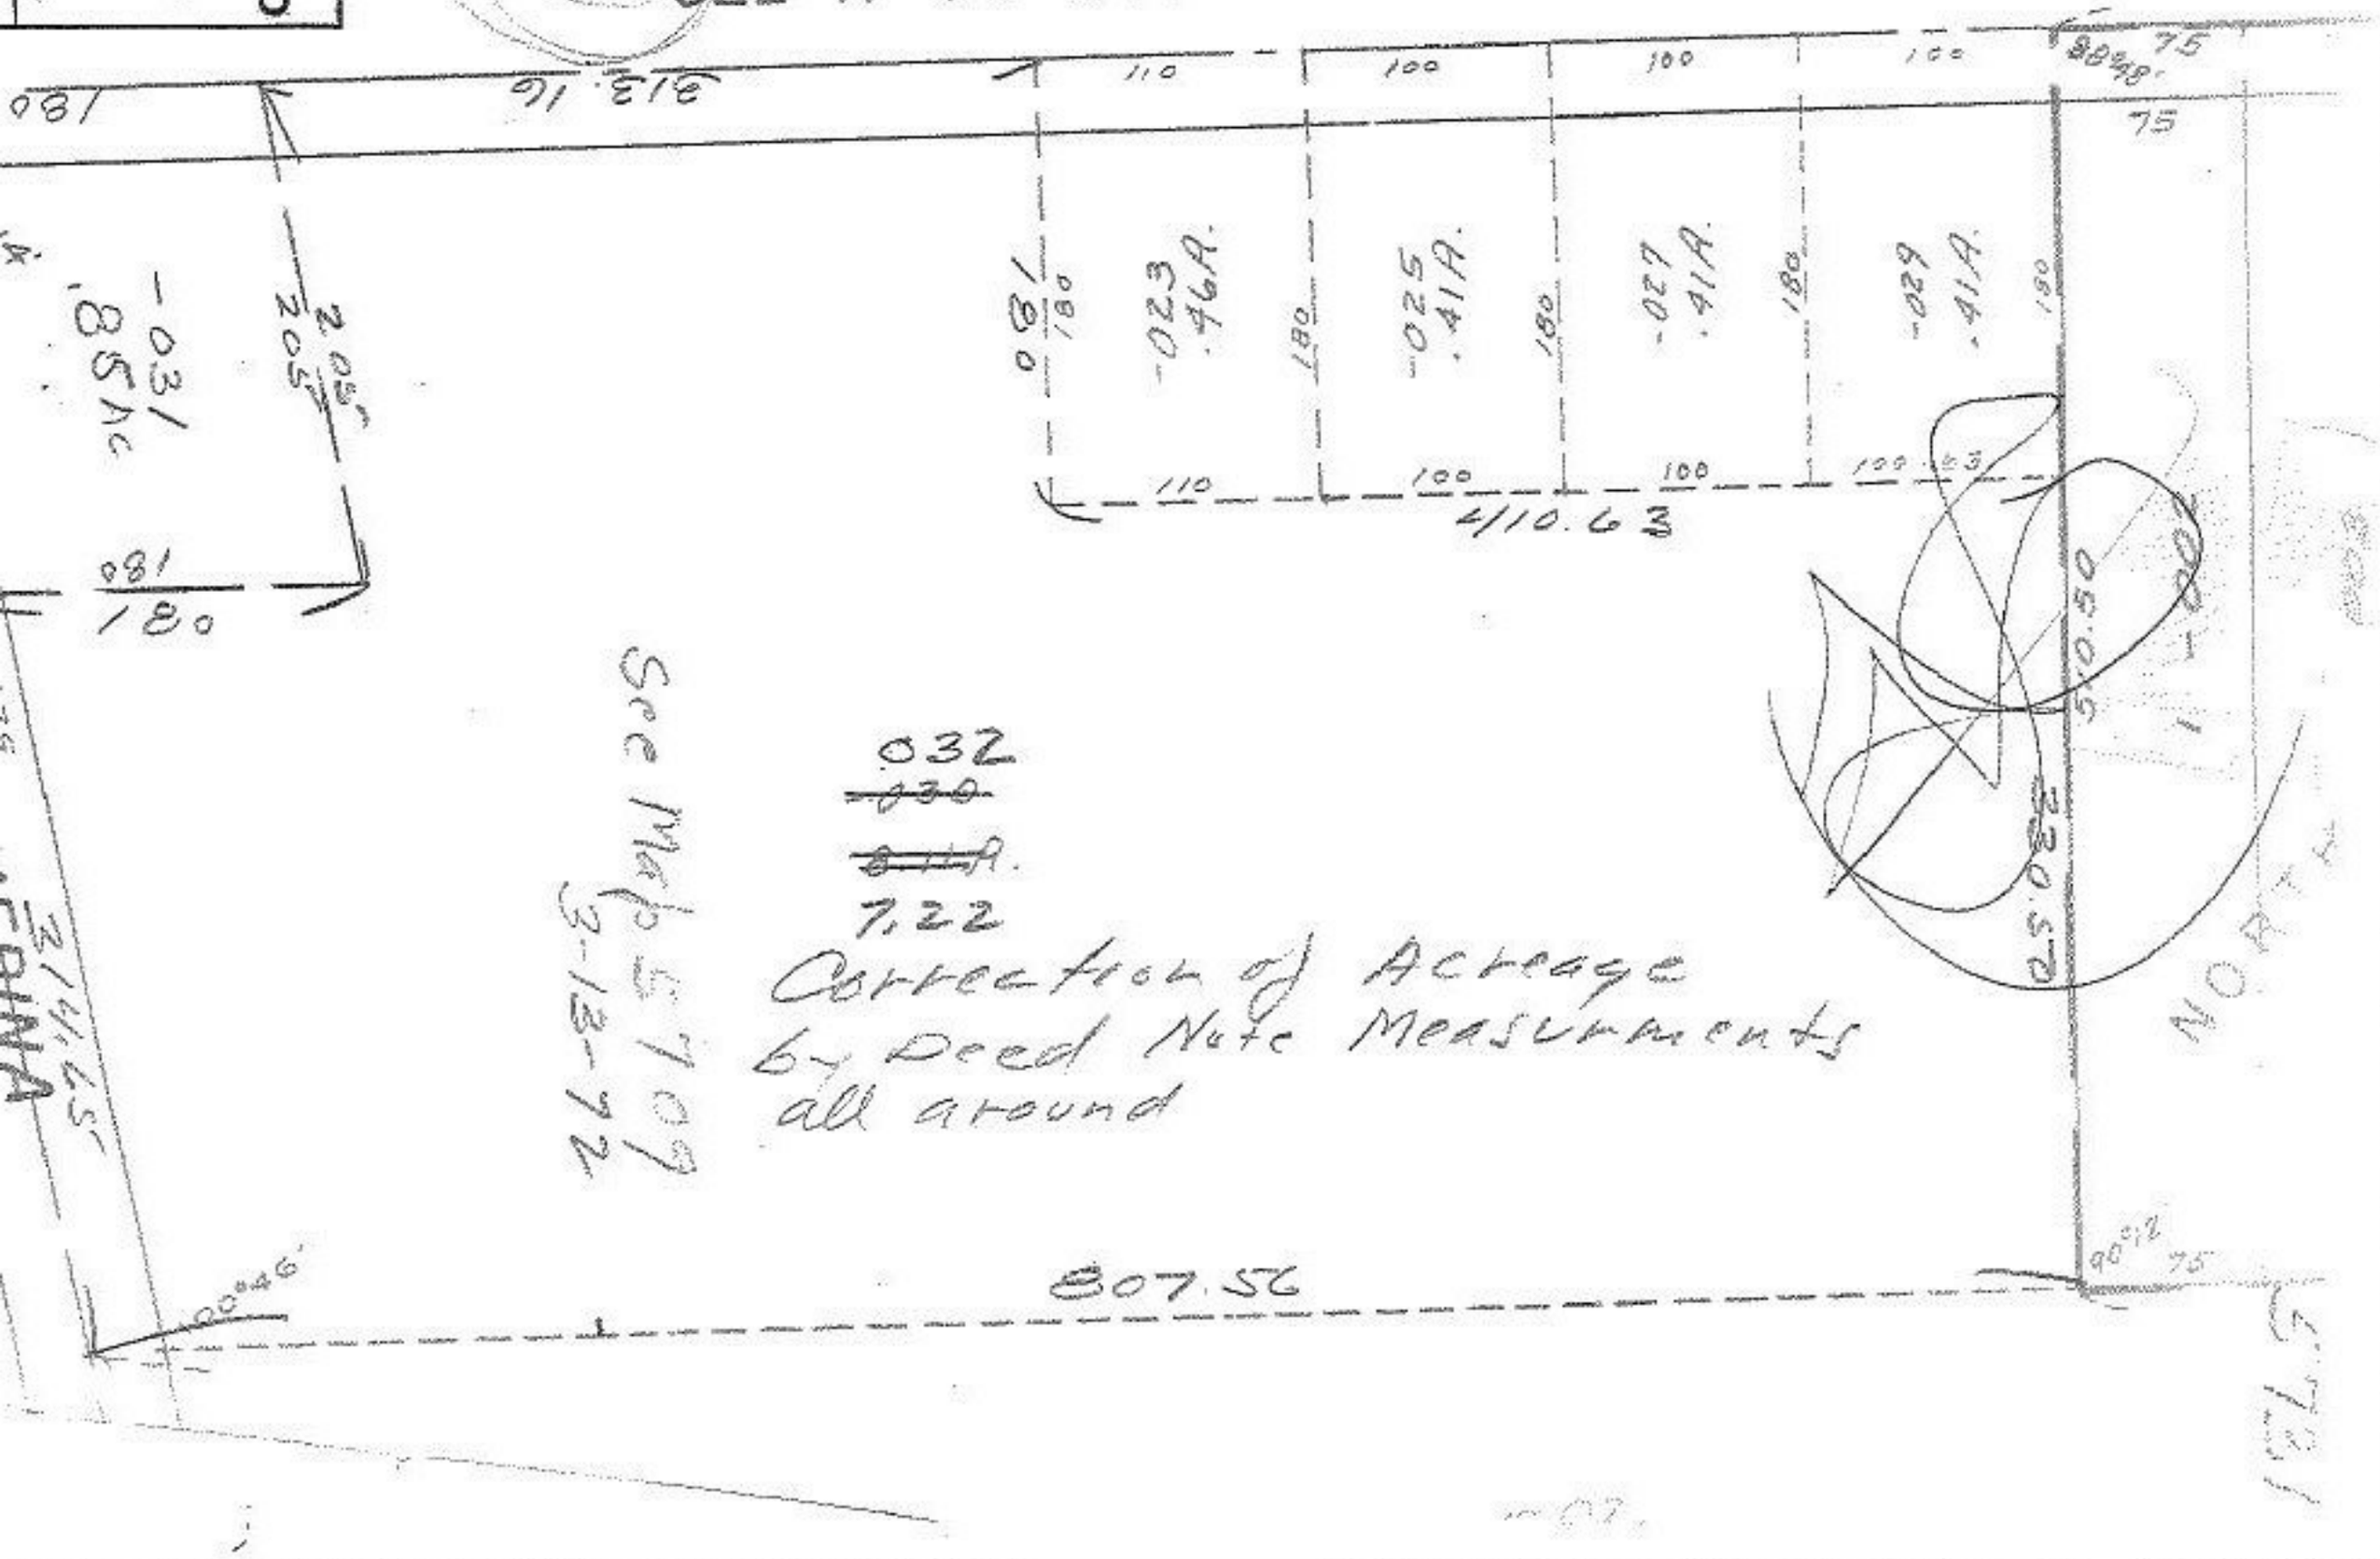

See Map 5709
3-13-72

032
~~030~~
~~8.11A.~~
7.22

Correction of Acreage
by Deed Note Measurments
all around