5736
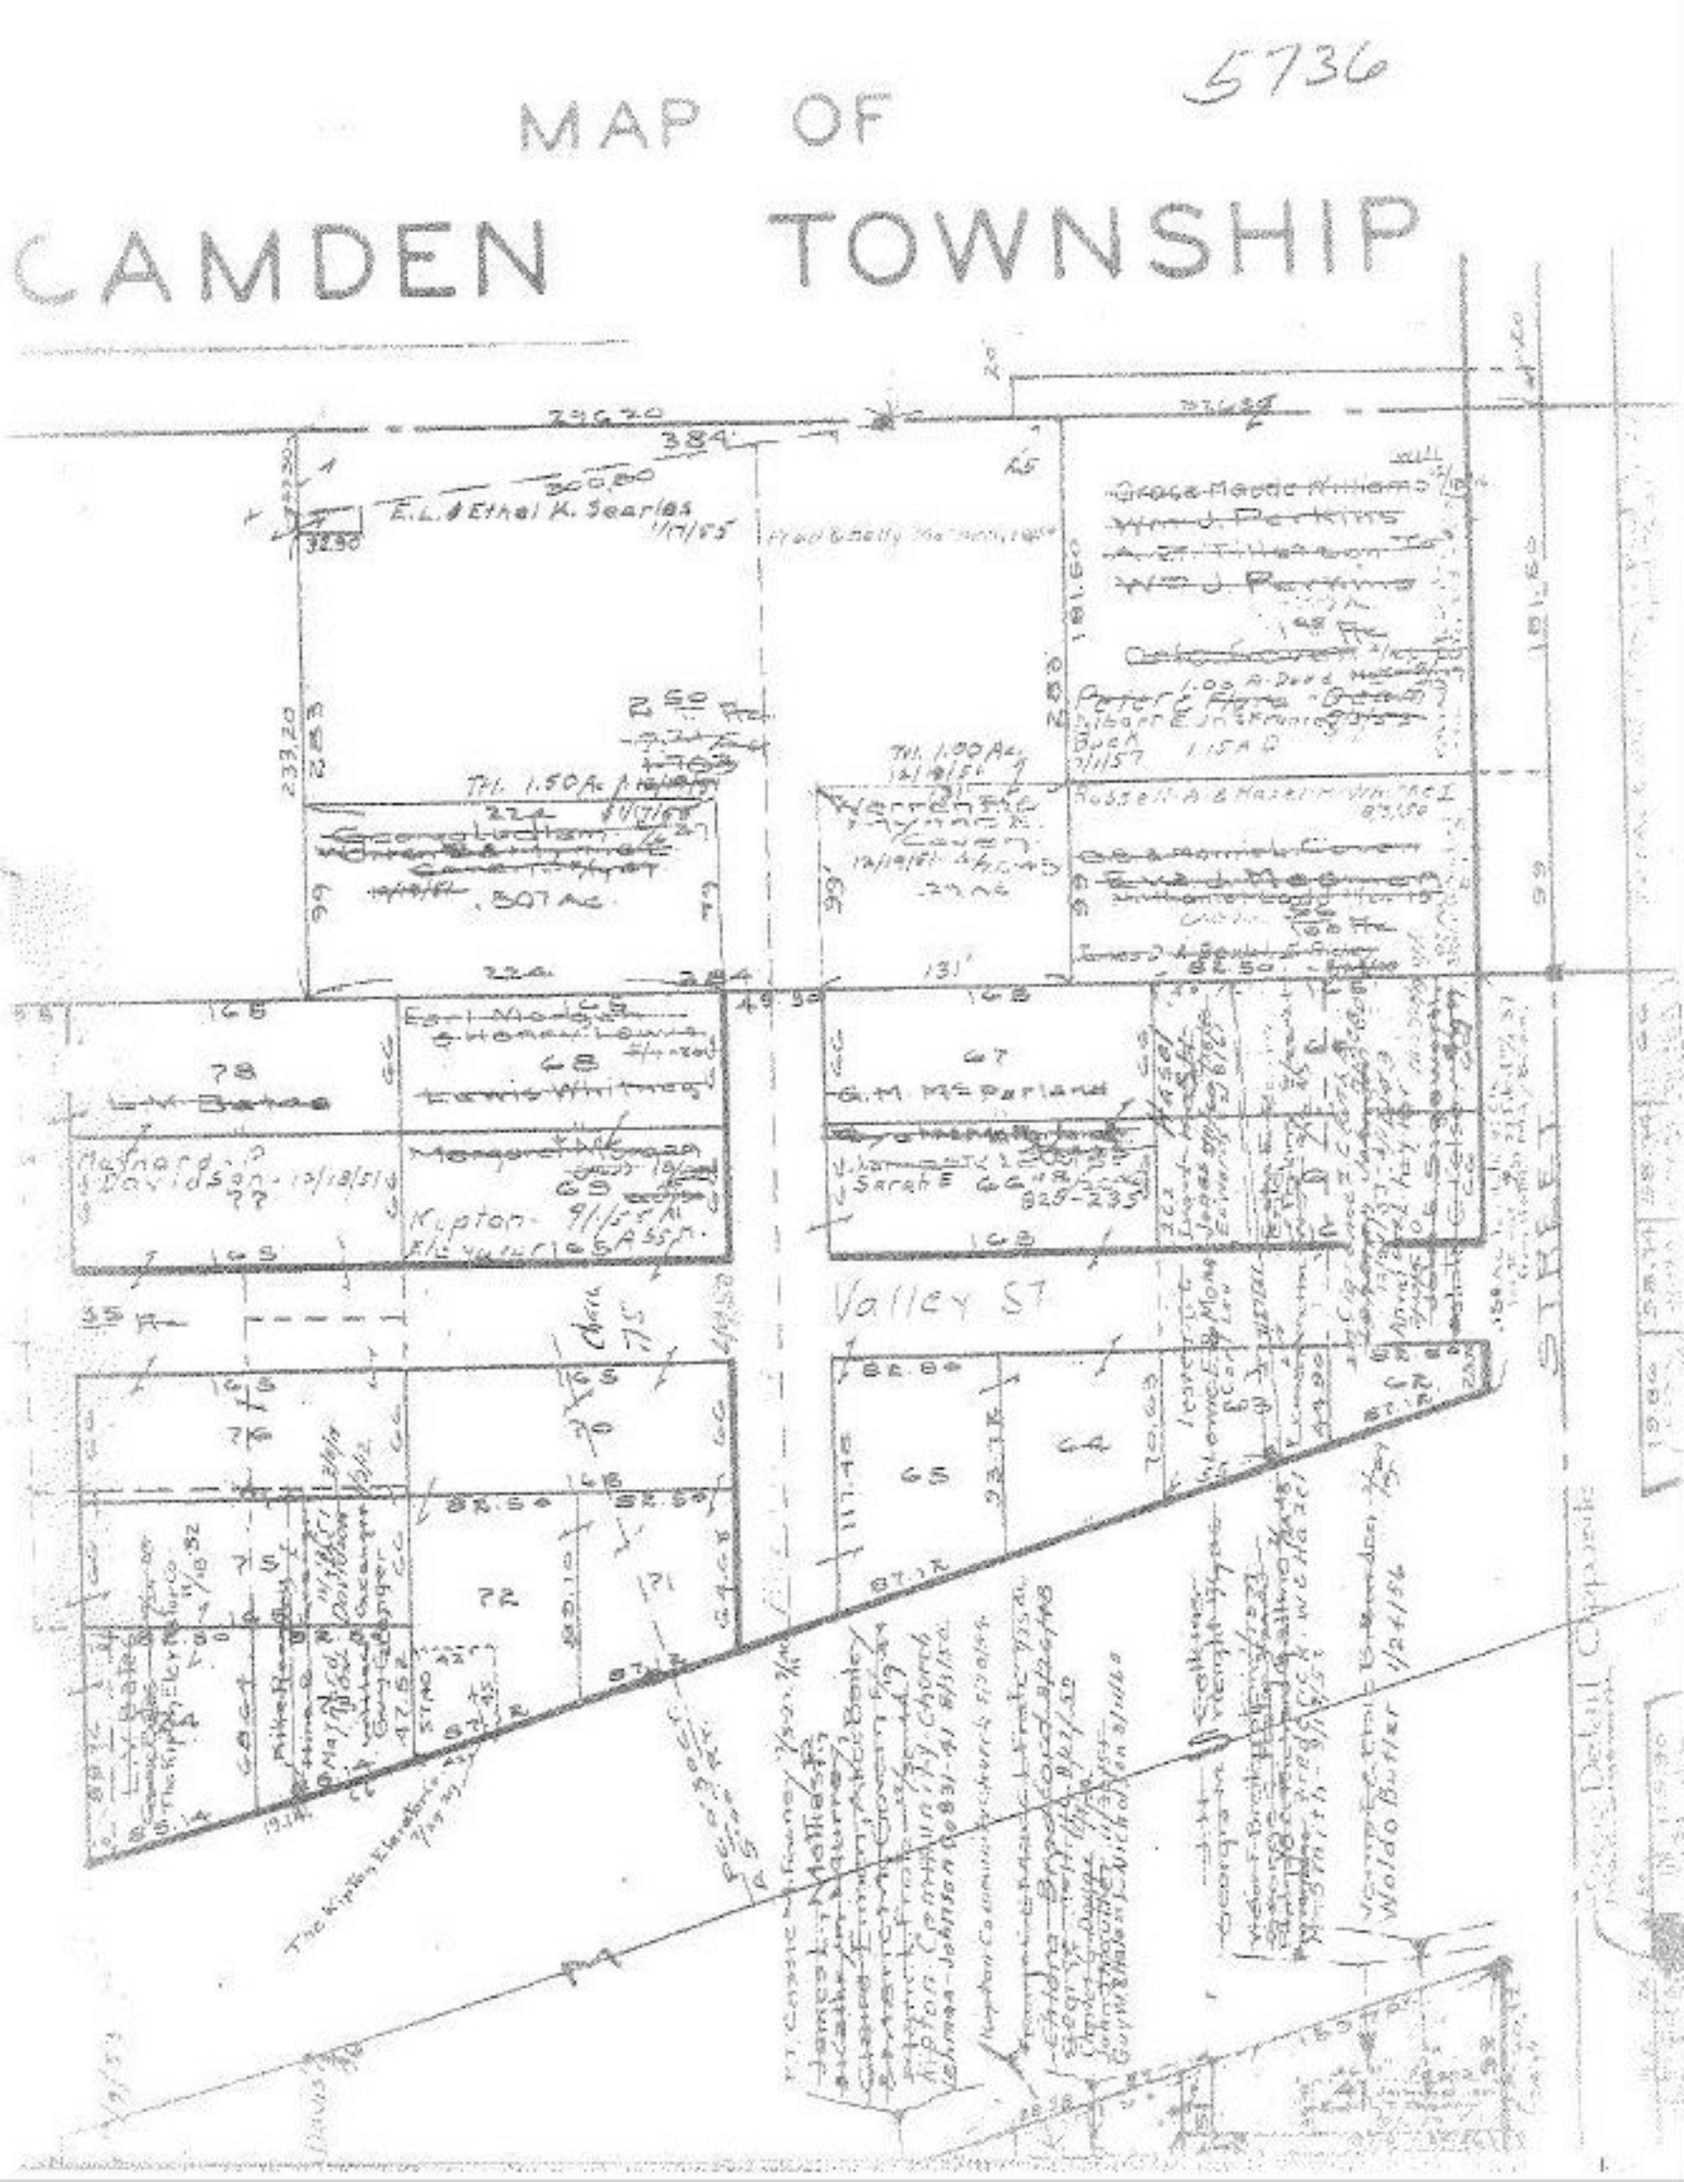
MAP OF CAMDEN TOWNSHIP