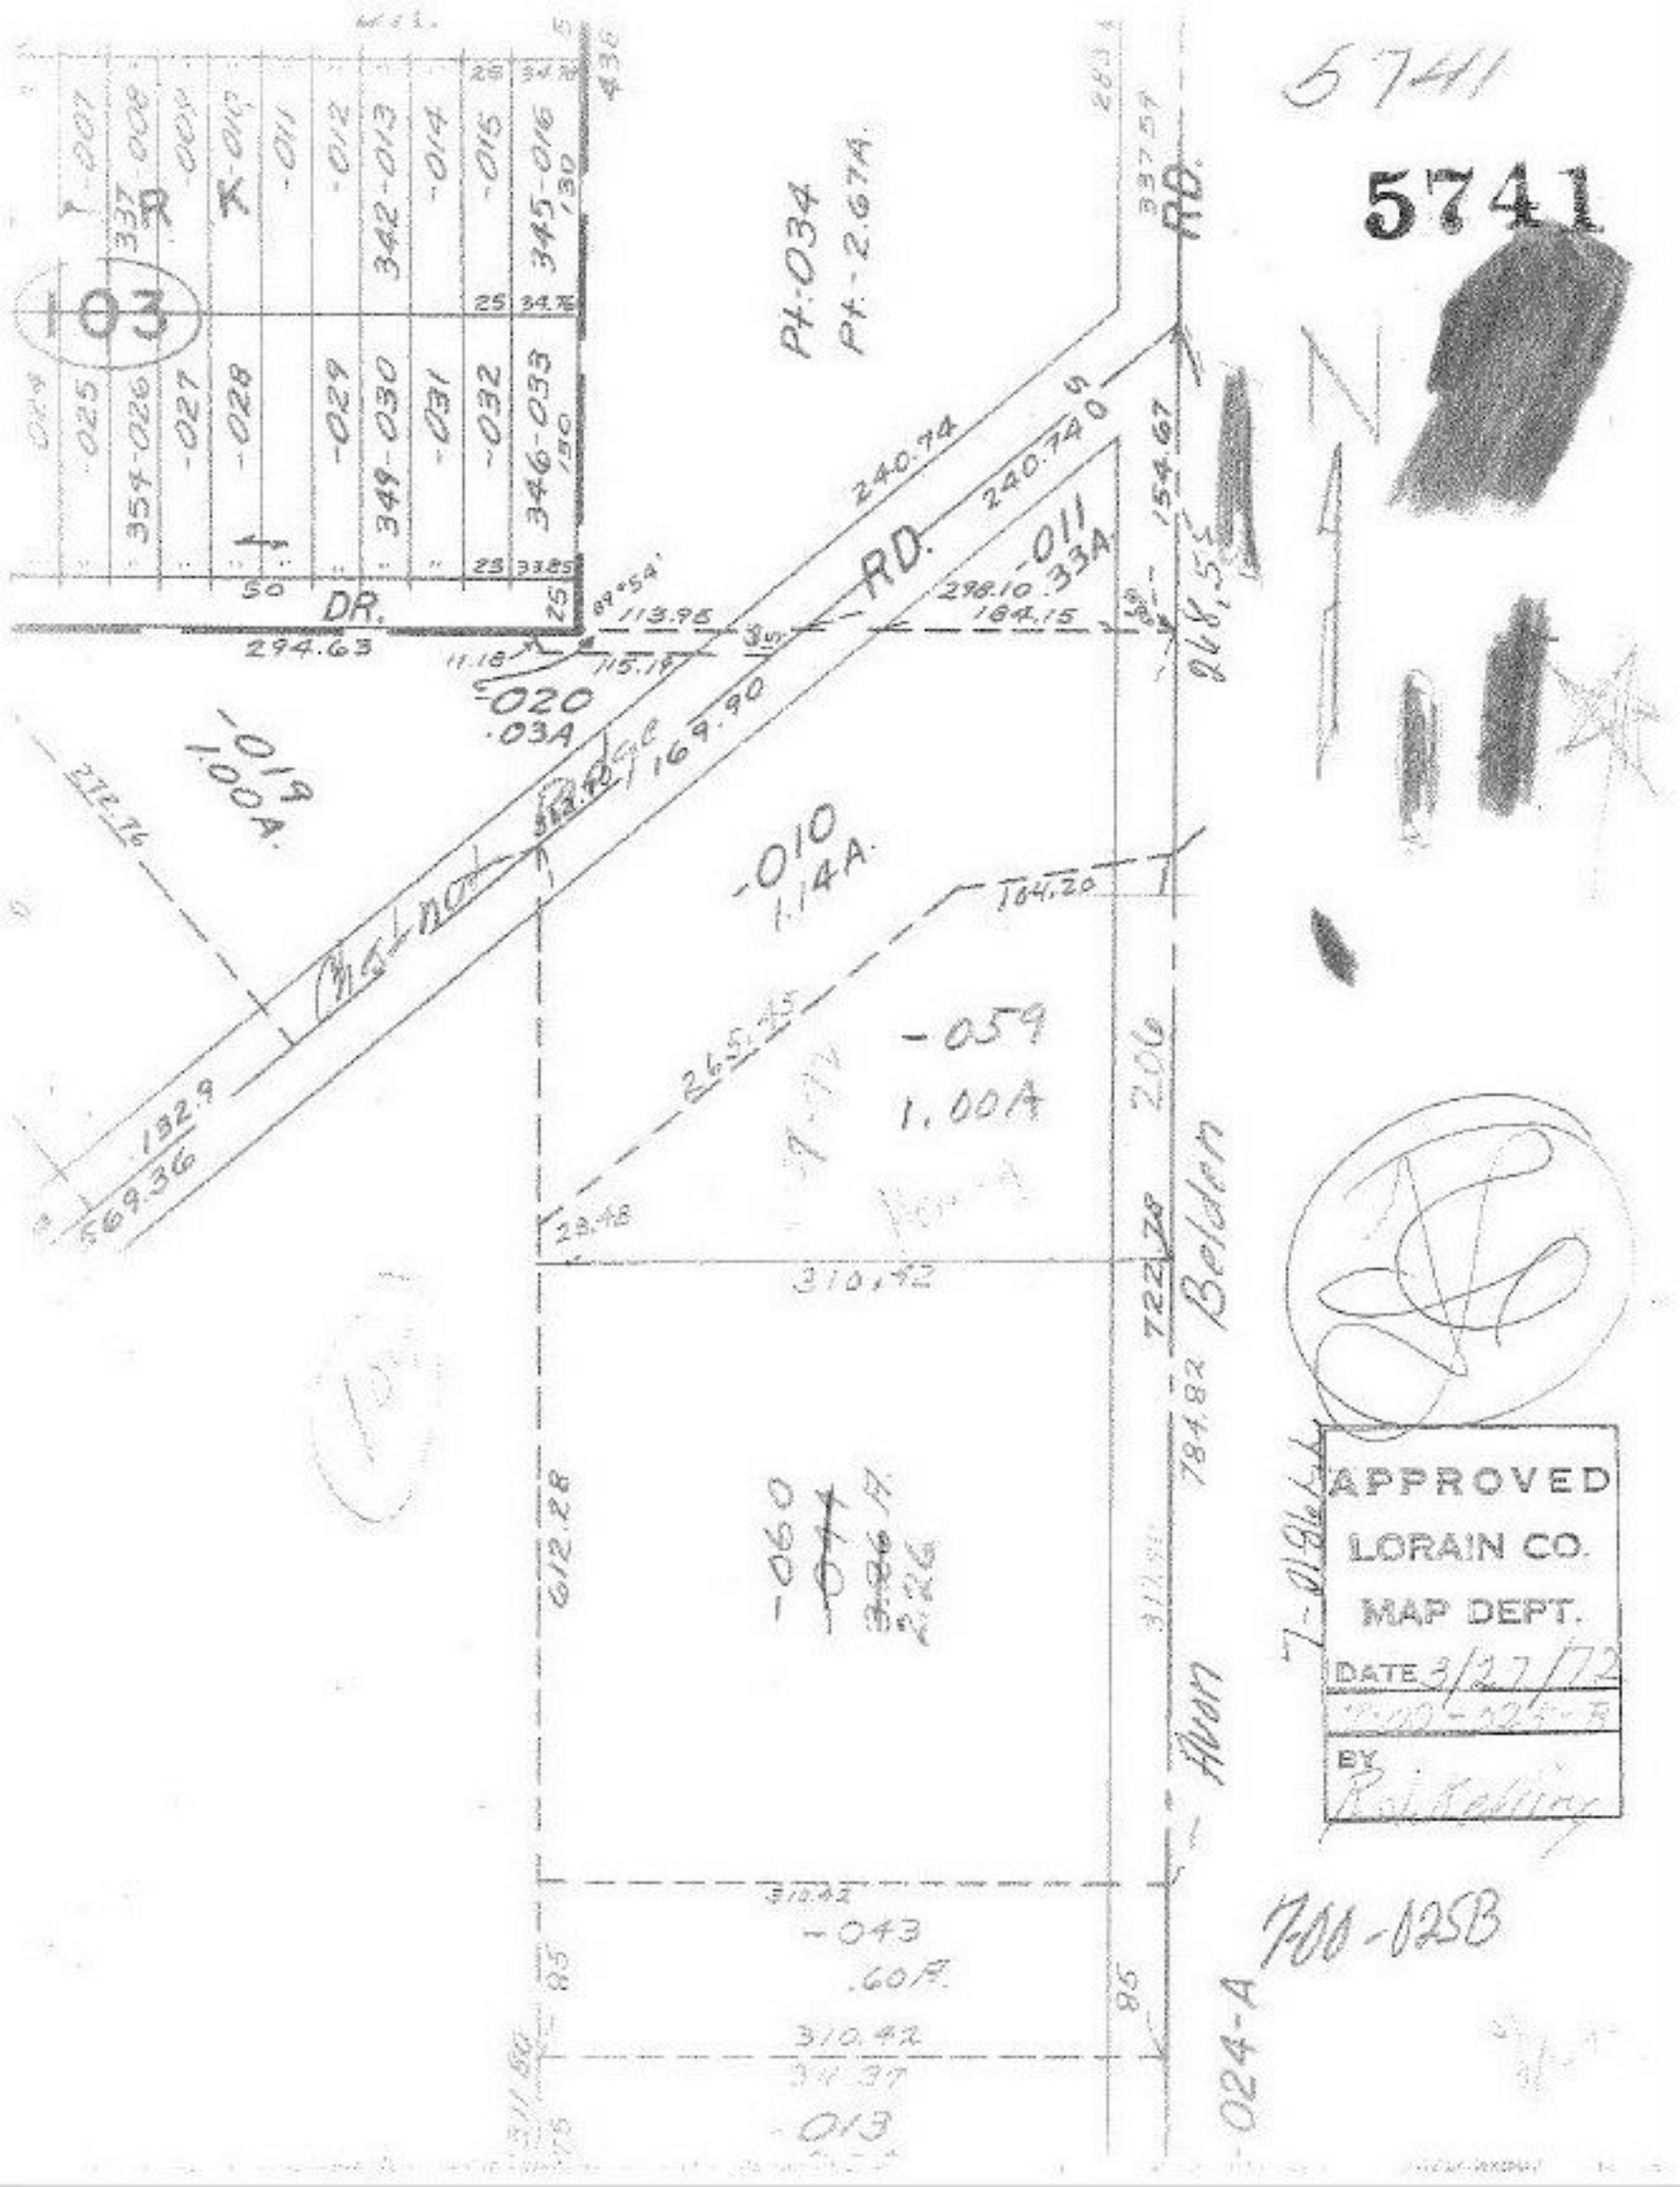
5741
5741
PT.034
PT.-2.67A.
RD.
240.74
240.74
-011
.33A
154.67
298.10
164.15
DR.
294.63
113.95
115.18
11.18
-020
.03A
-019
1.00A.
272.14
169.90
-010
1.14A.
164.20
-059
1.00A
265.45
182.9
569.36
28.48
310.42
722.20
206
784.82
612.28
-060
-043
.60A.
310.42
85
85
-013
024-A
Avon
APPROVED
LORAIN CO.
MAP DEPT.
DATE 3/27/72
BY
7-01B
7-01-25B