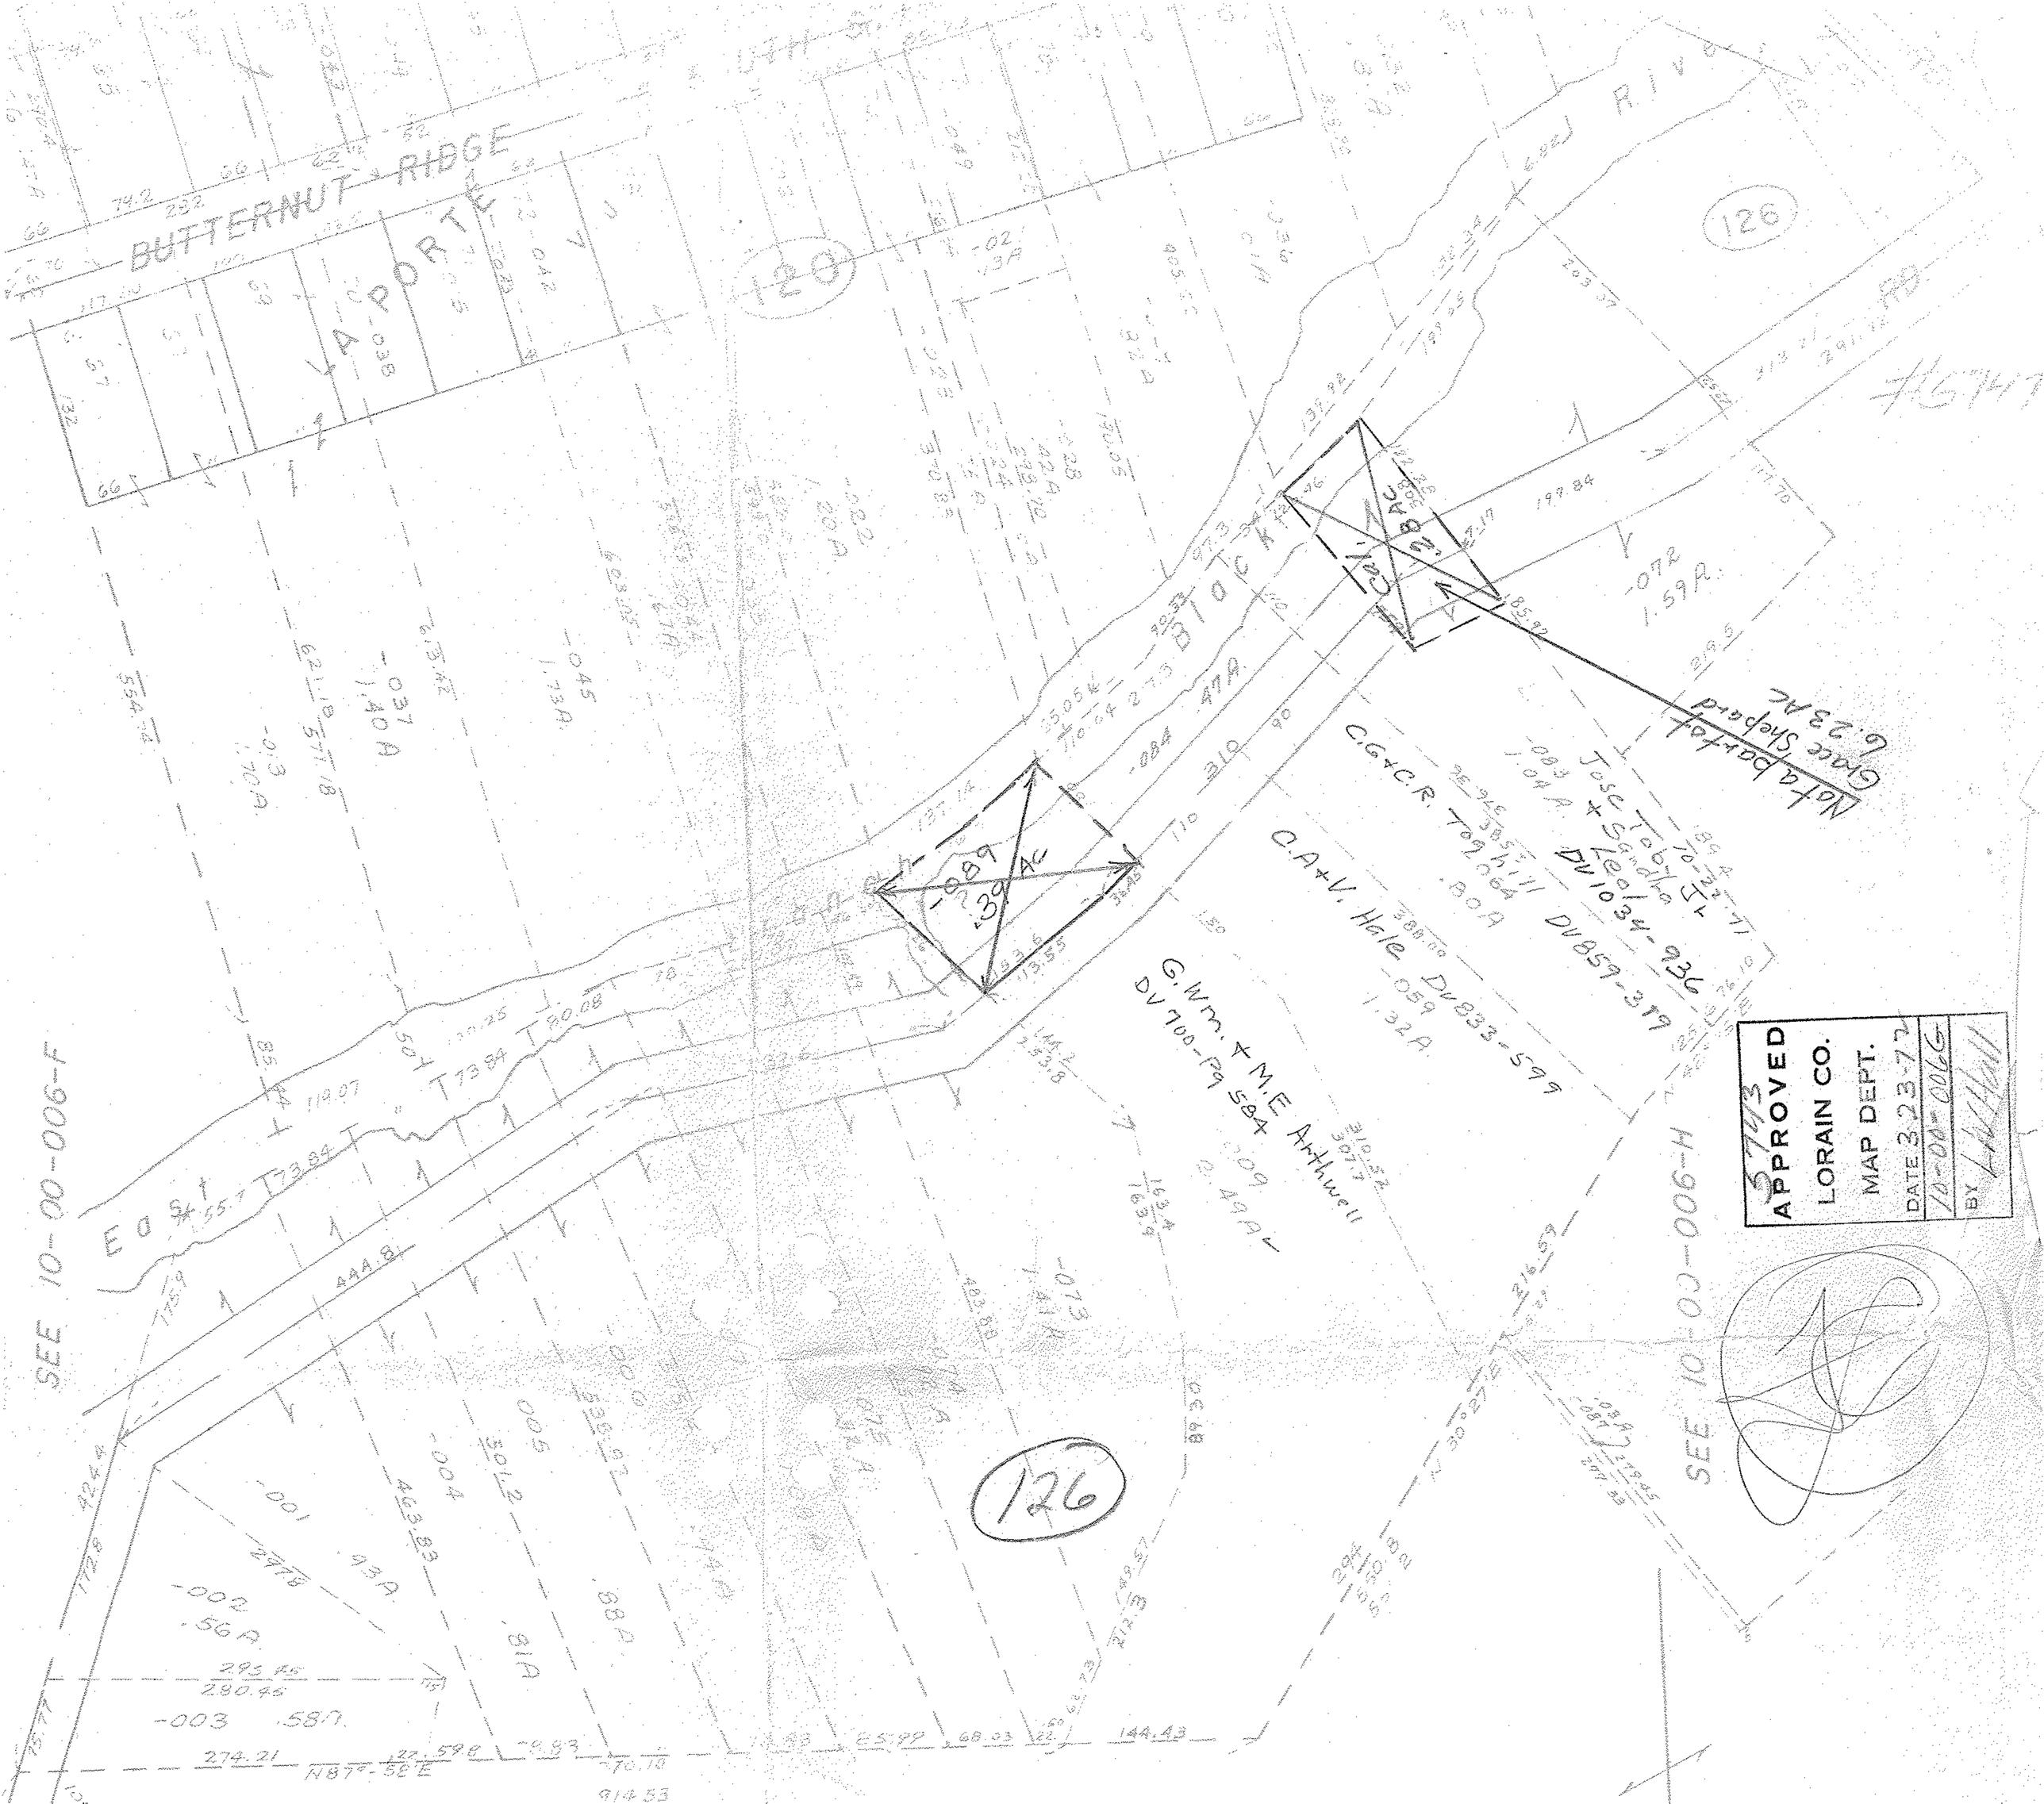

BUTTERNUT RIDGE
LA PORTE
120
126
Black
Cal. 2.8 AC
Nata Bartot
Grace Shepard
6.23 AC
Jose Tobyl Jr
+ Sandra
Leal
DV 1034-936
DV 859-319
C.G+C.R. Toq
C.A+V. Hale
DV 833-599
G.Wm. + M.E Arthwell
DV 700-Pg 584
East
SEE 10-00-006-F
SEE 10-00-006-H
APPROVED
LORAIN CO.
MAP DEPT.
DATE 3-23-72
10-00-006G
BY