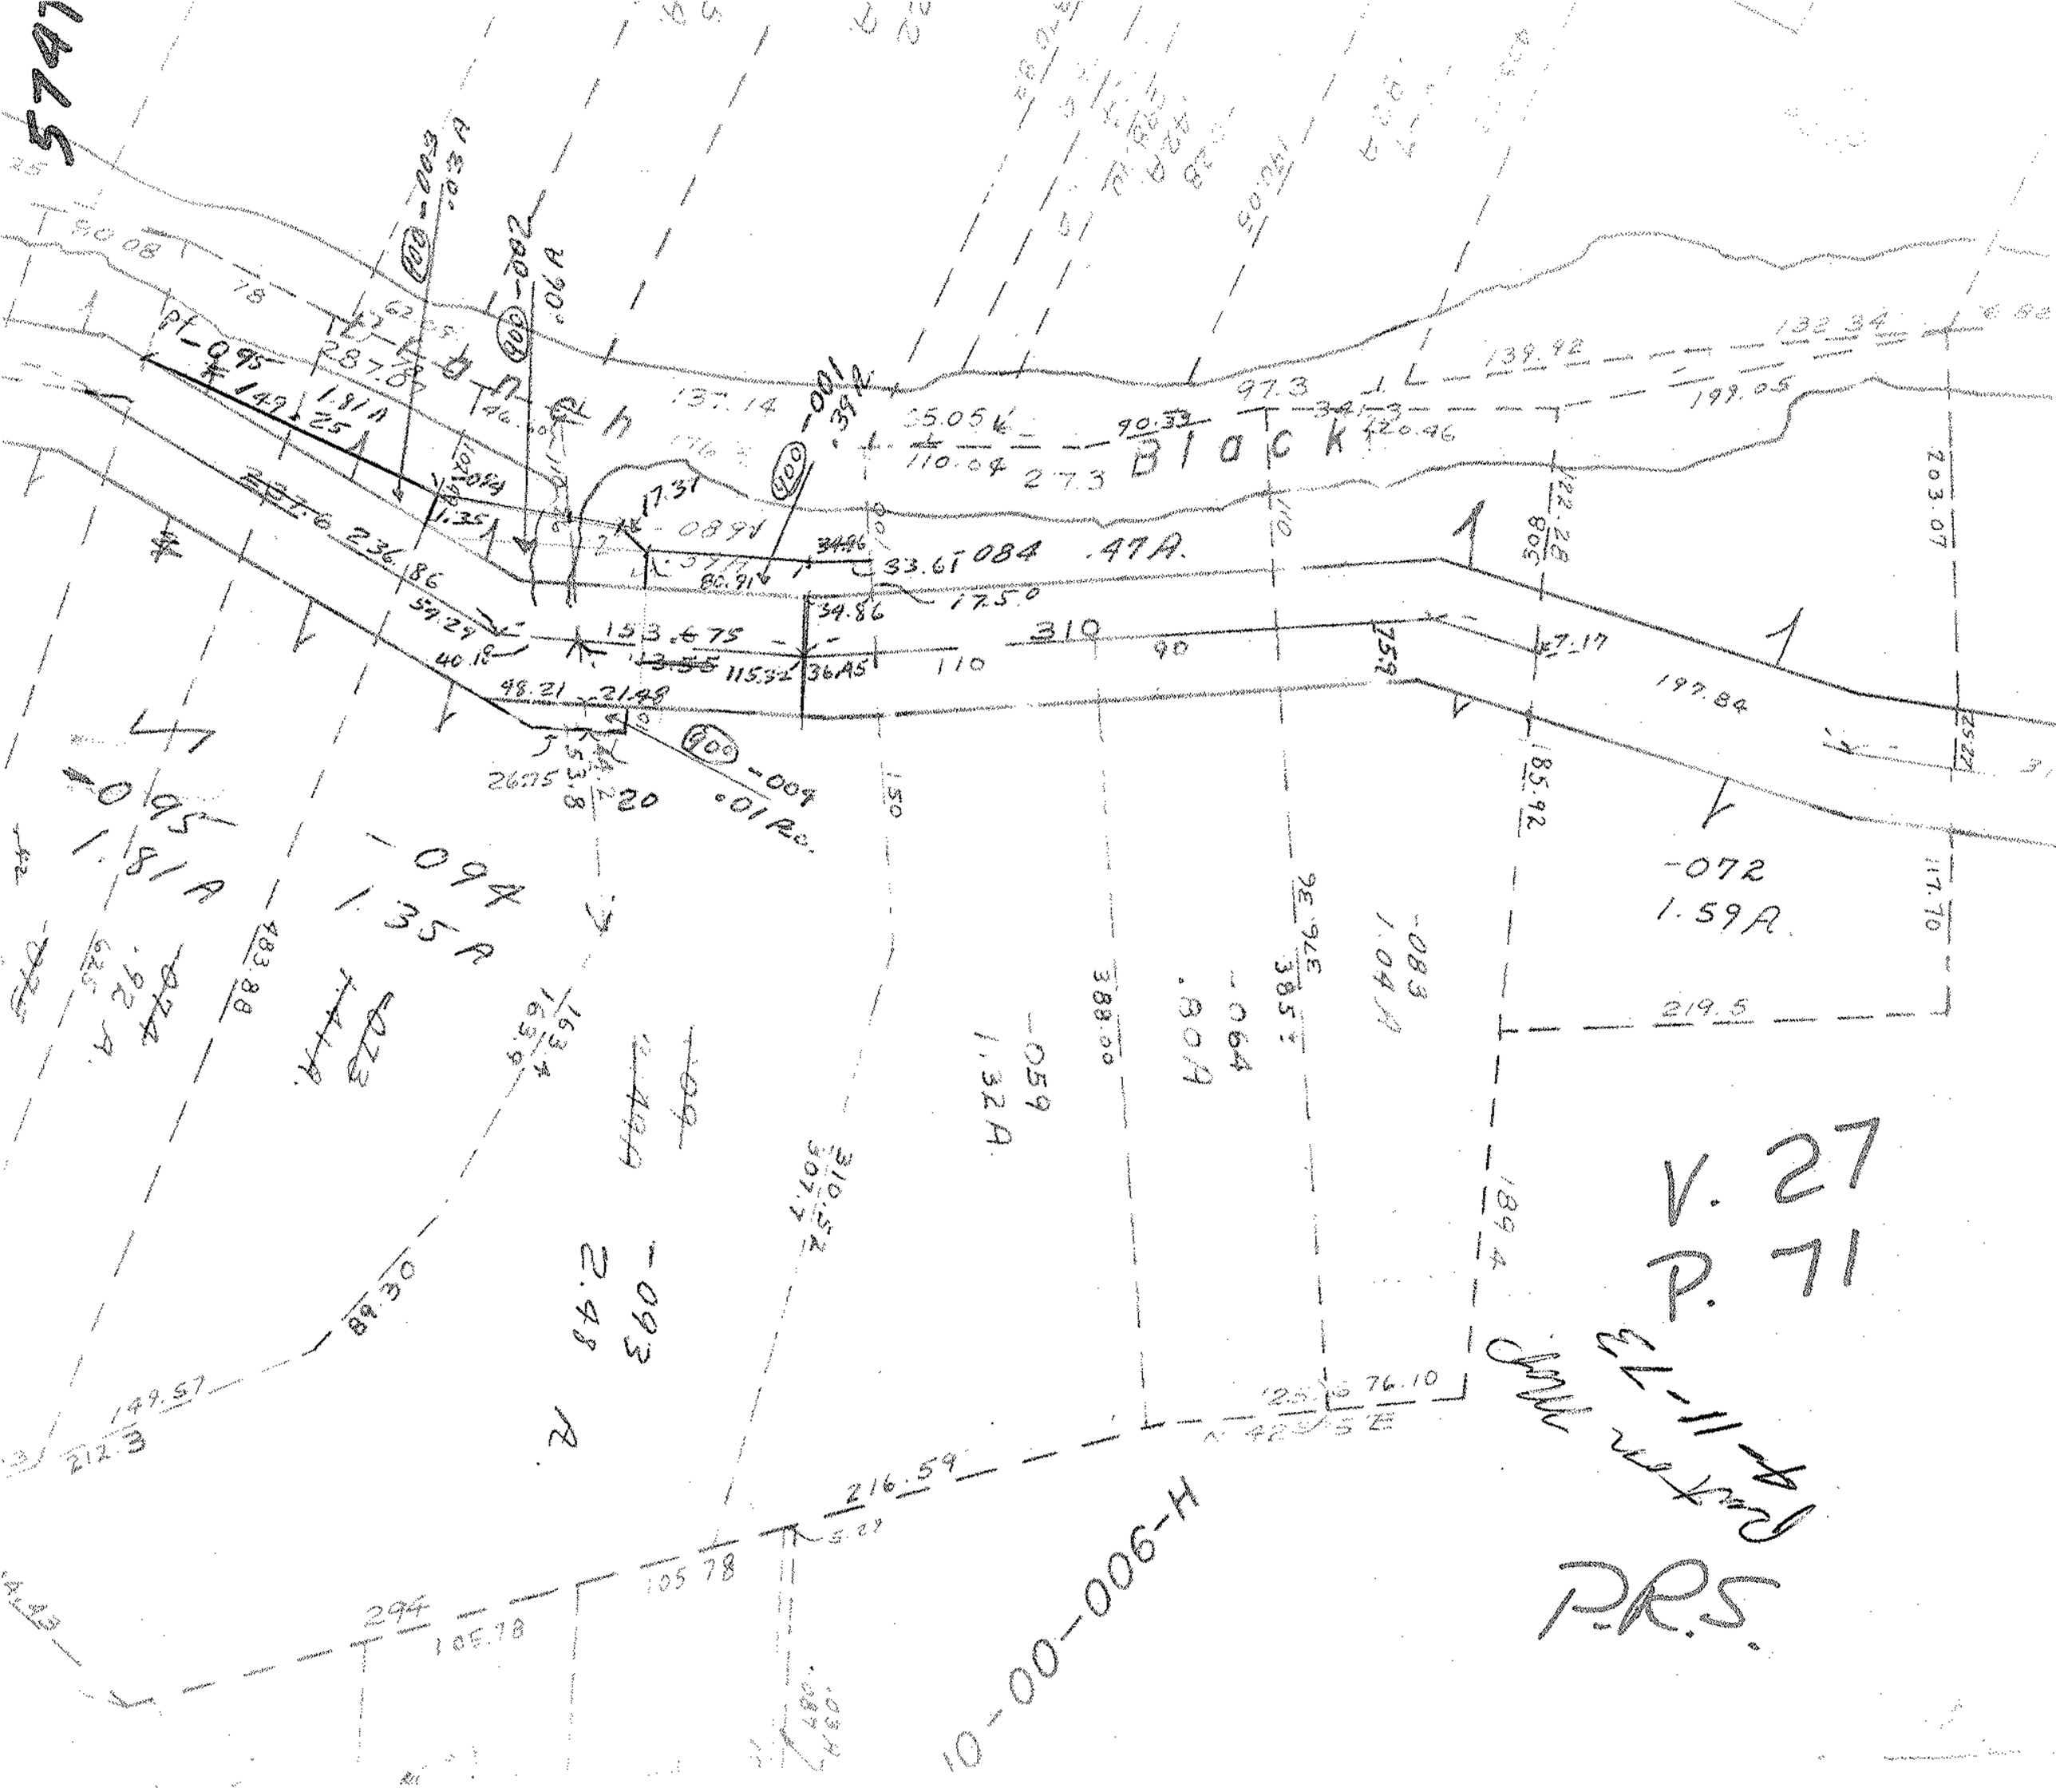

5741
Branch
Block
V. 27
P. 71
P.R.S.
10-00-006-H
-072
1.59A
-094
1.35A
-095
1.81A
-093
2.48 A
-059
1.32A
-064
.80A
-083
1.04A
-084
.47A.
-001
.39A
-002
.06A
-003
.03A
-009
.01Ac.