


5-00-33-B

675.00  
1866.20  
1510


R.D.

752.60

611  
120

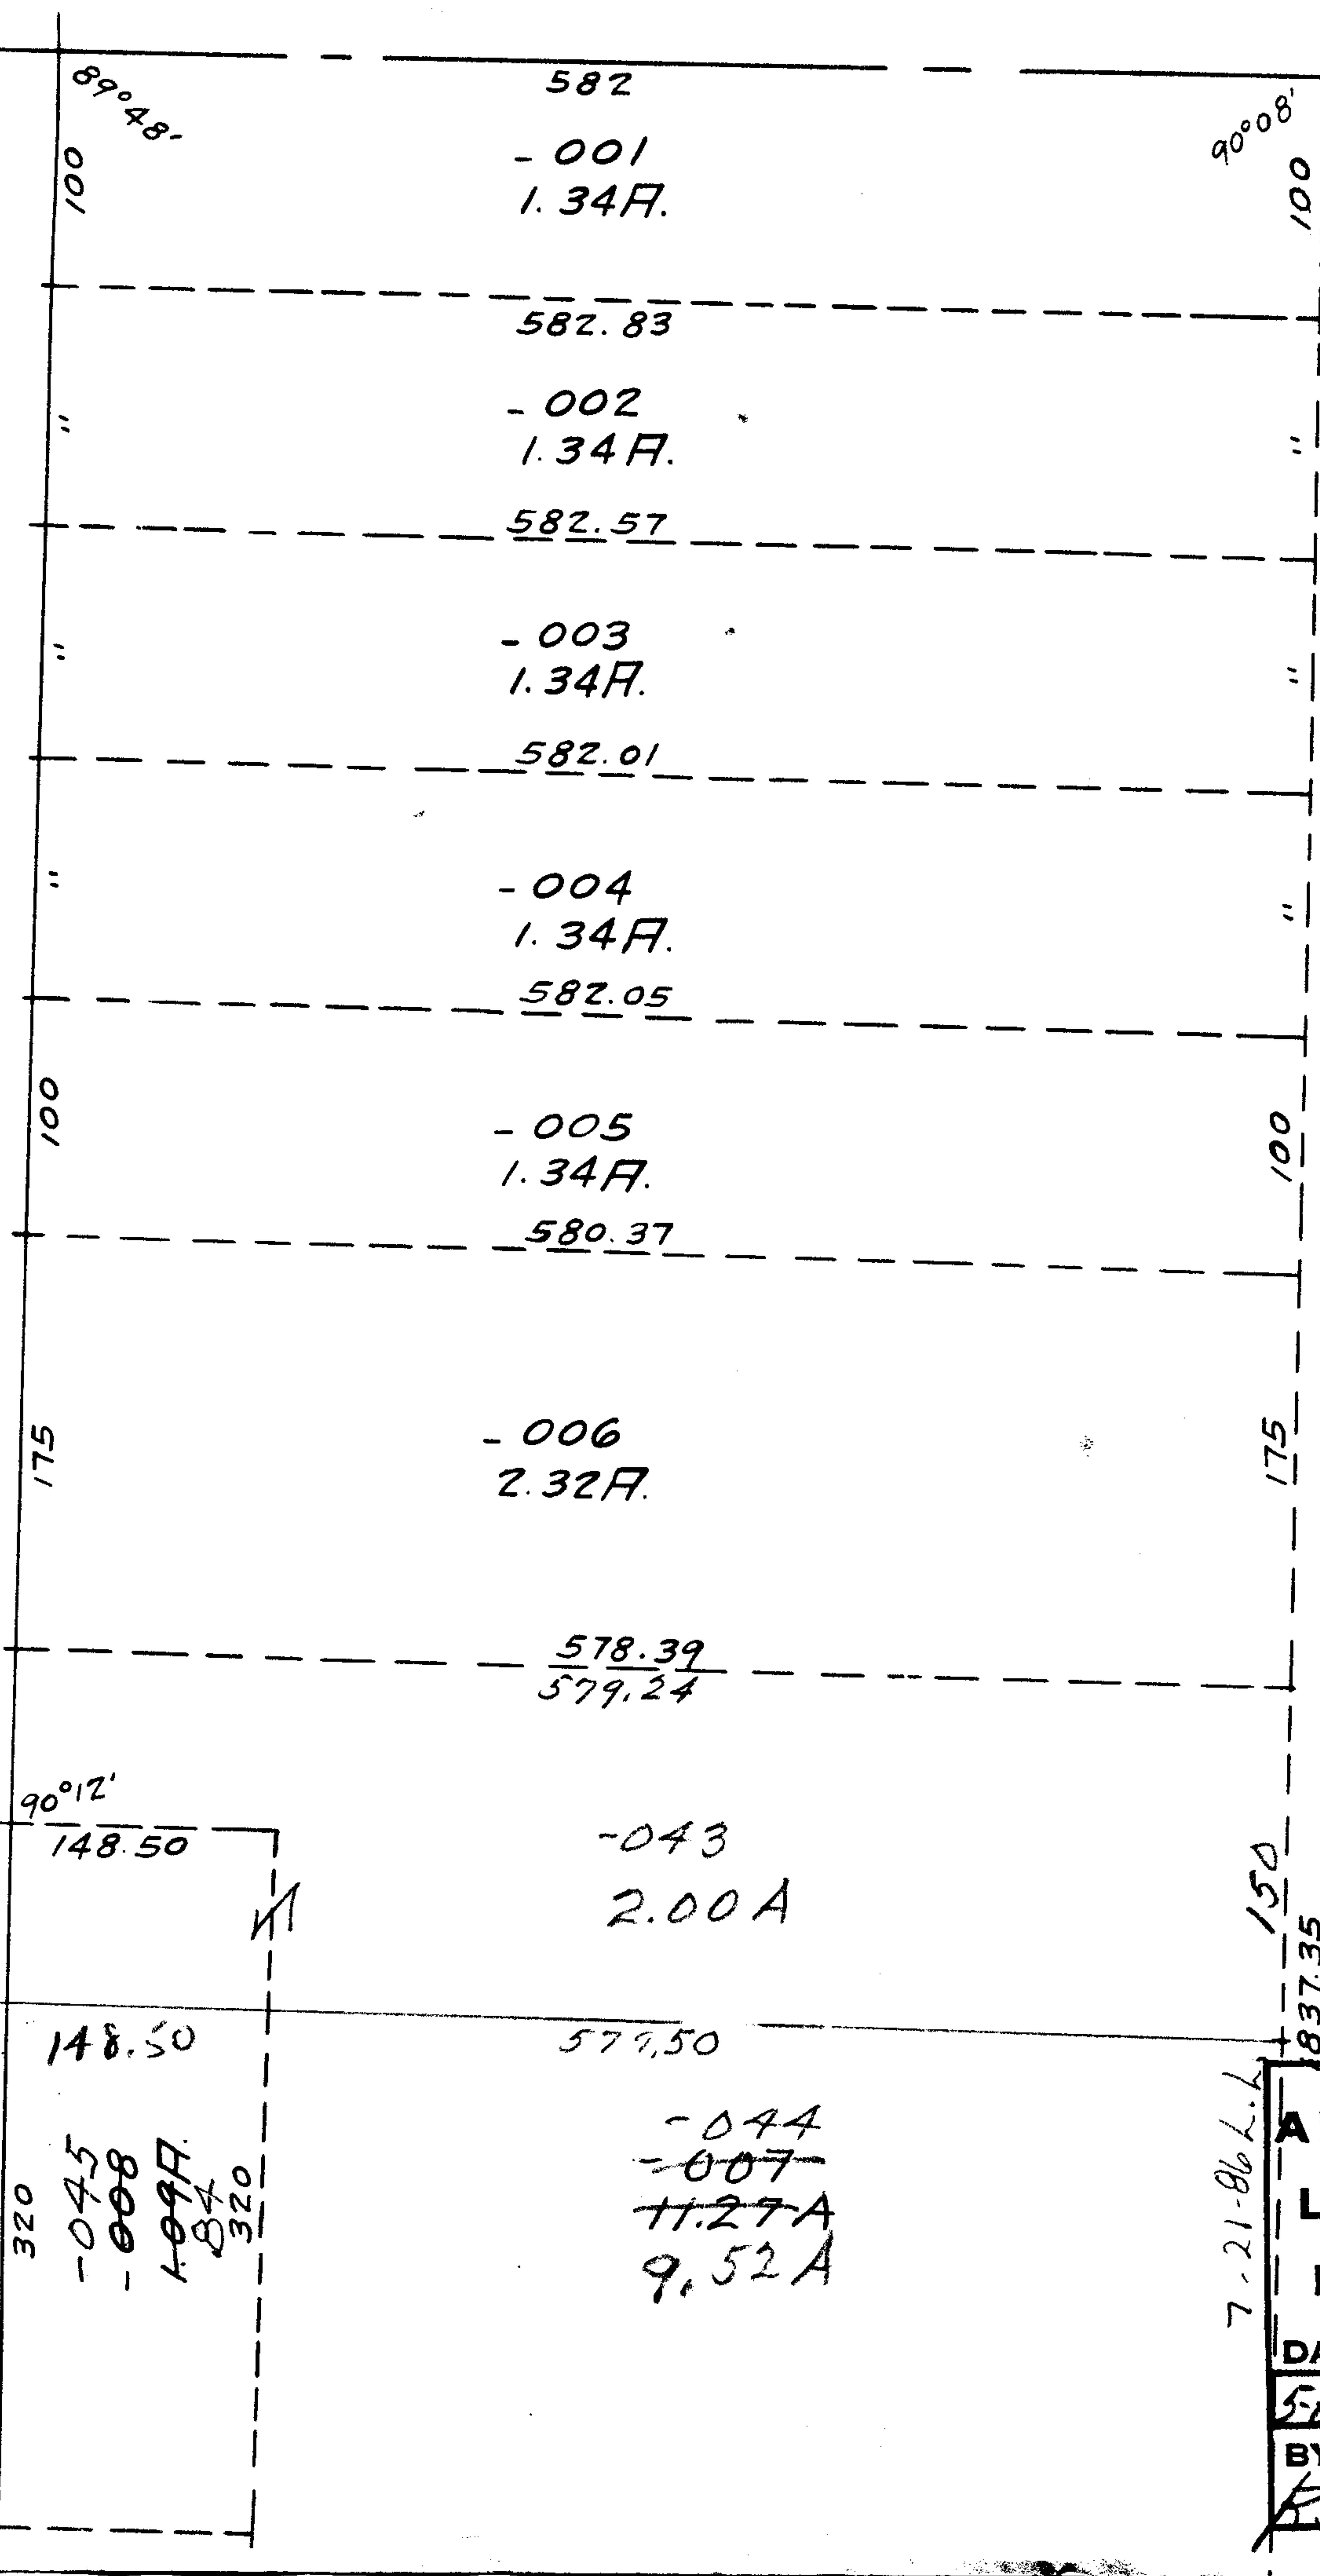


5748

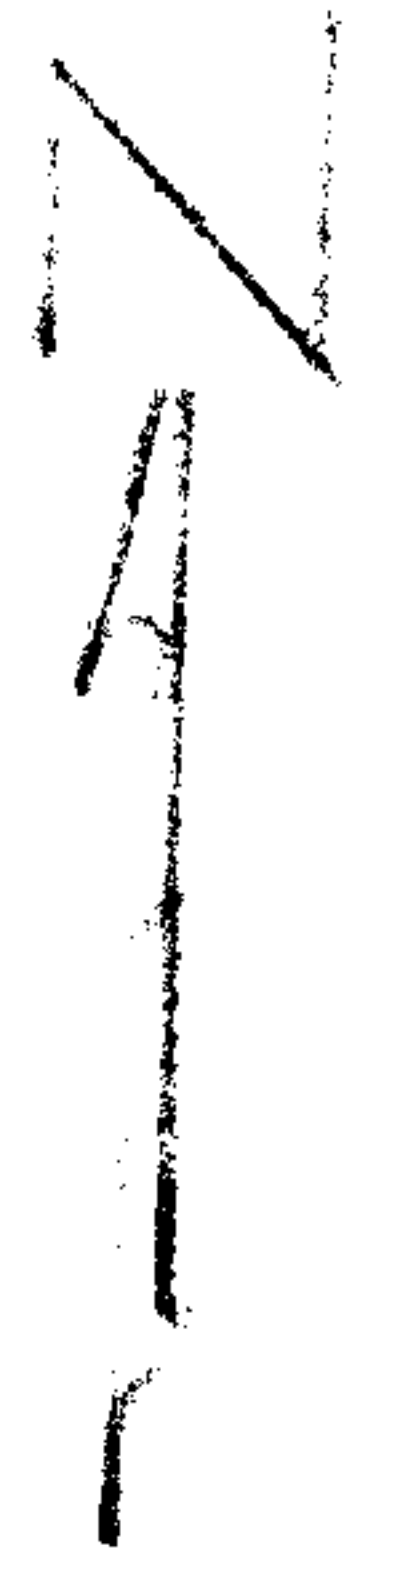

752.60  
675  
77.60

320

JUN 16 ENT'D

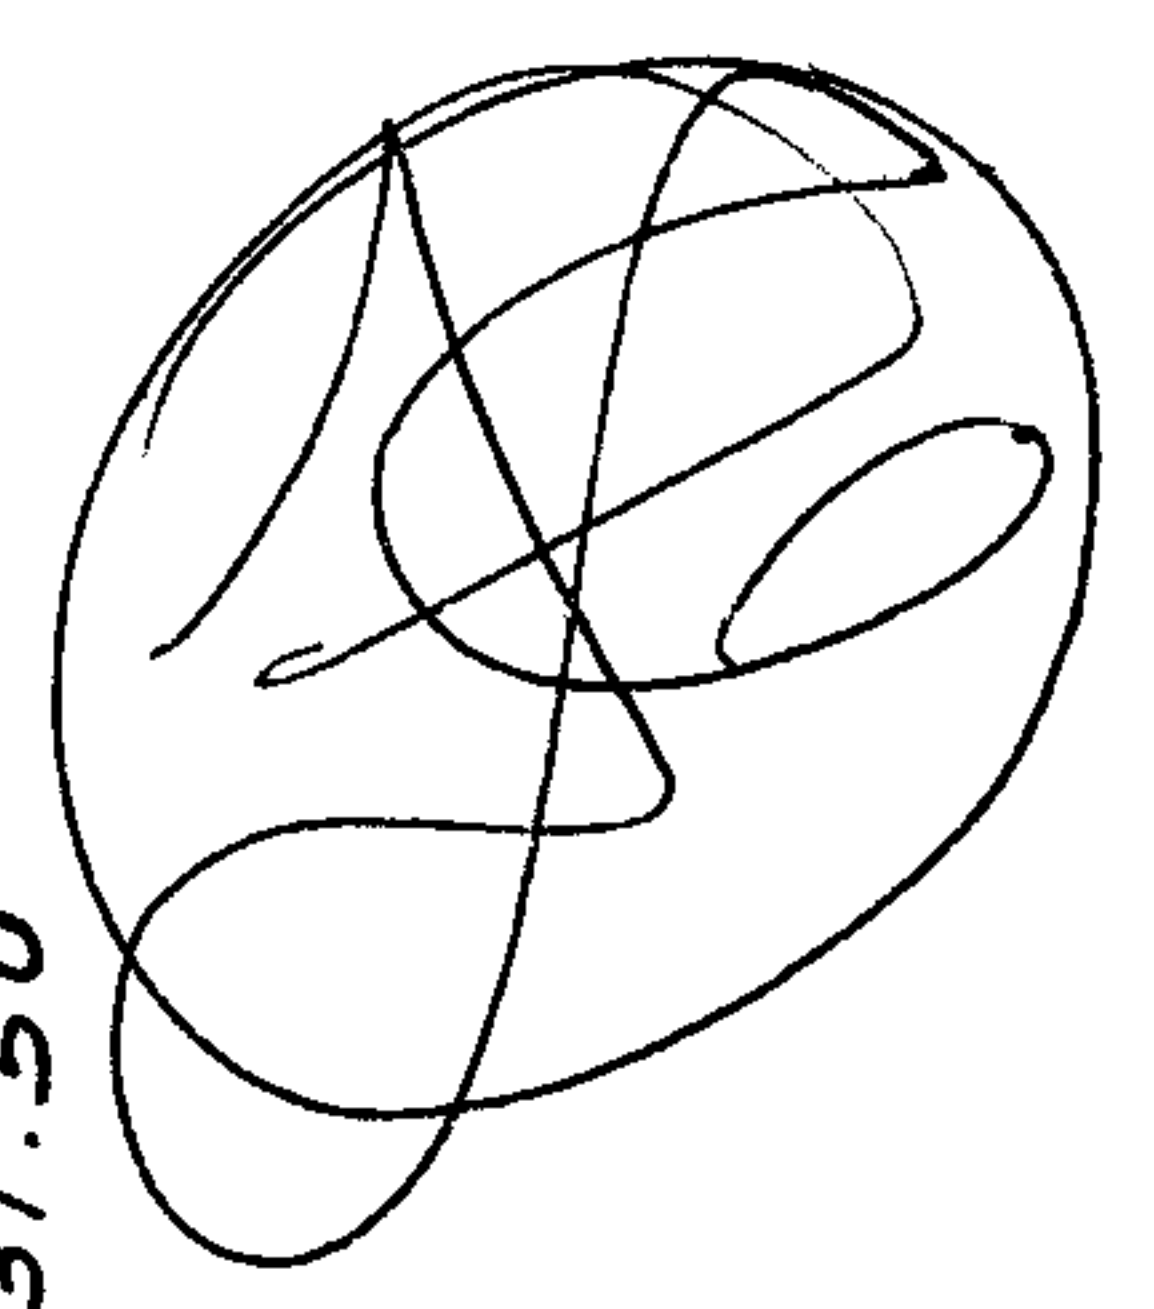

7-21-86 L.L.K.

<b>APPROVED</b>
<b>LORAIN CO.</b>
<b>MAP DEPT.</b>
DATE 3/24/72
500-048-A
BY R.L. Kelling