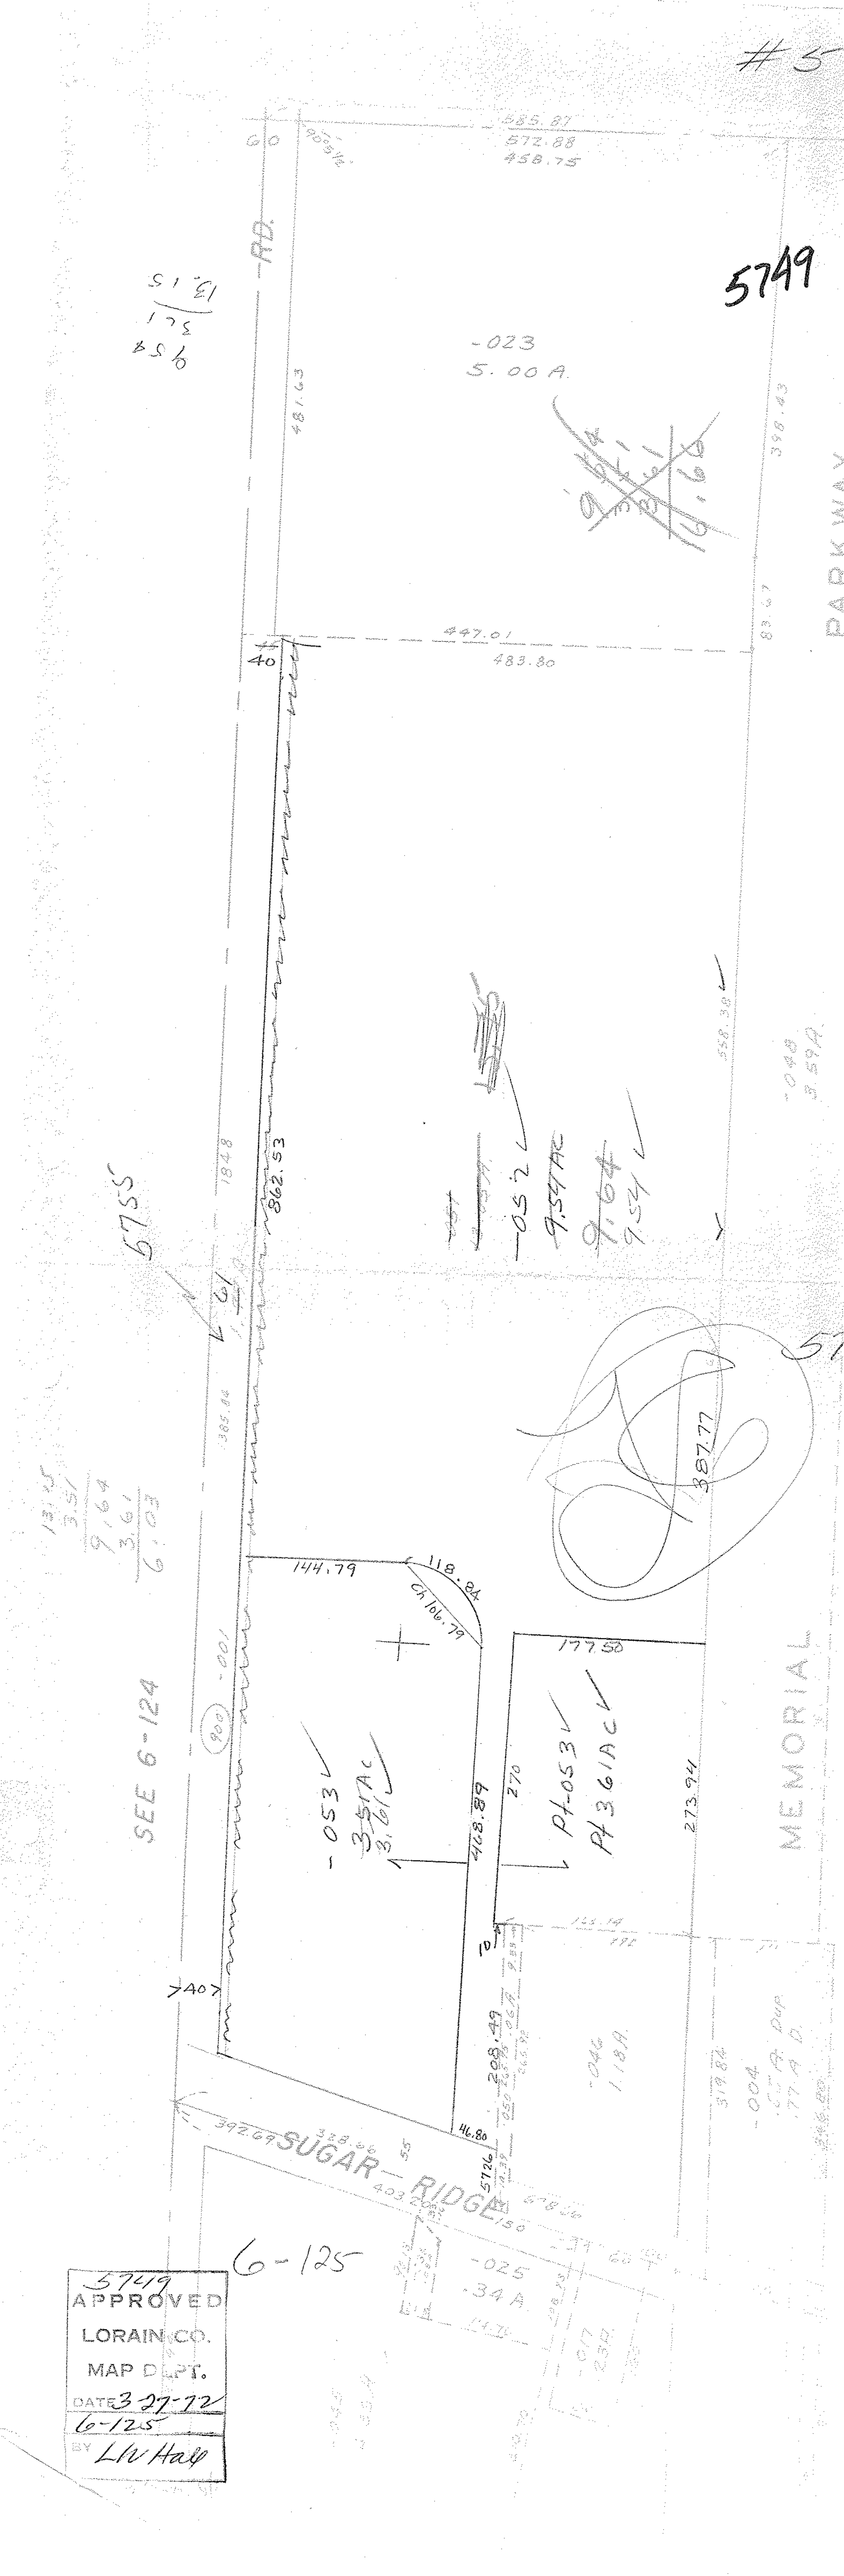
#5
5749
-023
5.00 A.
PARKWAY
MEMORIAL
SUGAR RIDGE
SEE 6-124
6-125
5749
APPROVED
LORAIN CO.
MAP DEPT.
DATE 3-27-72
6-125
BY LW Hall