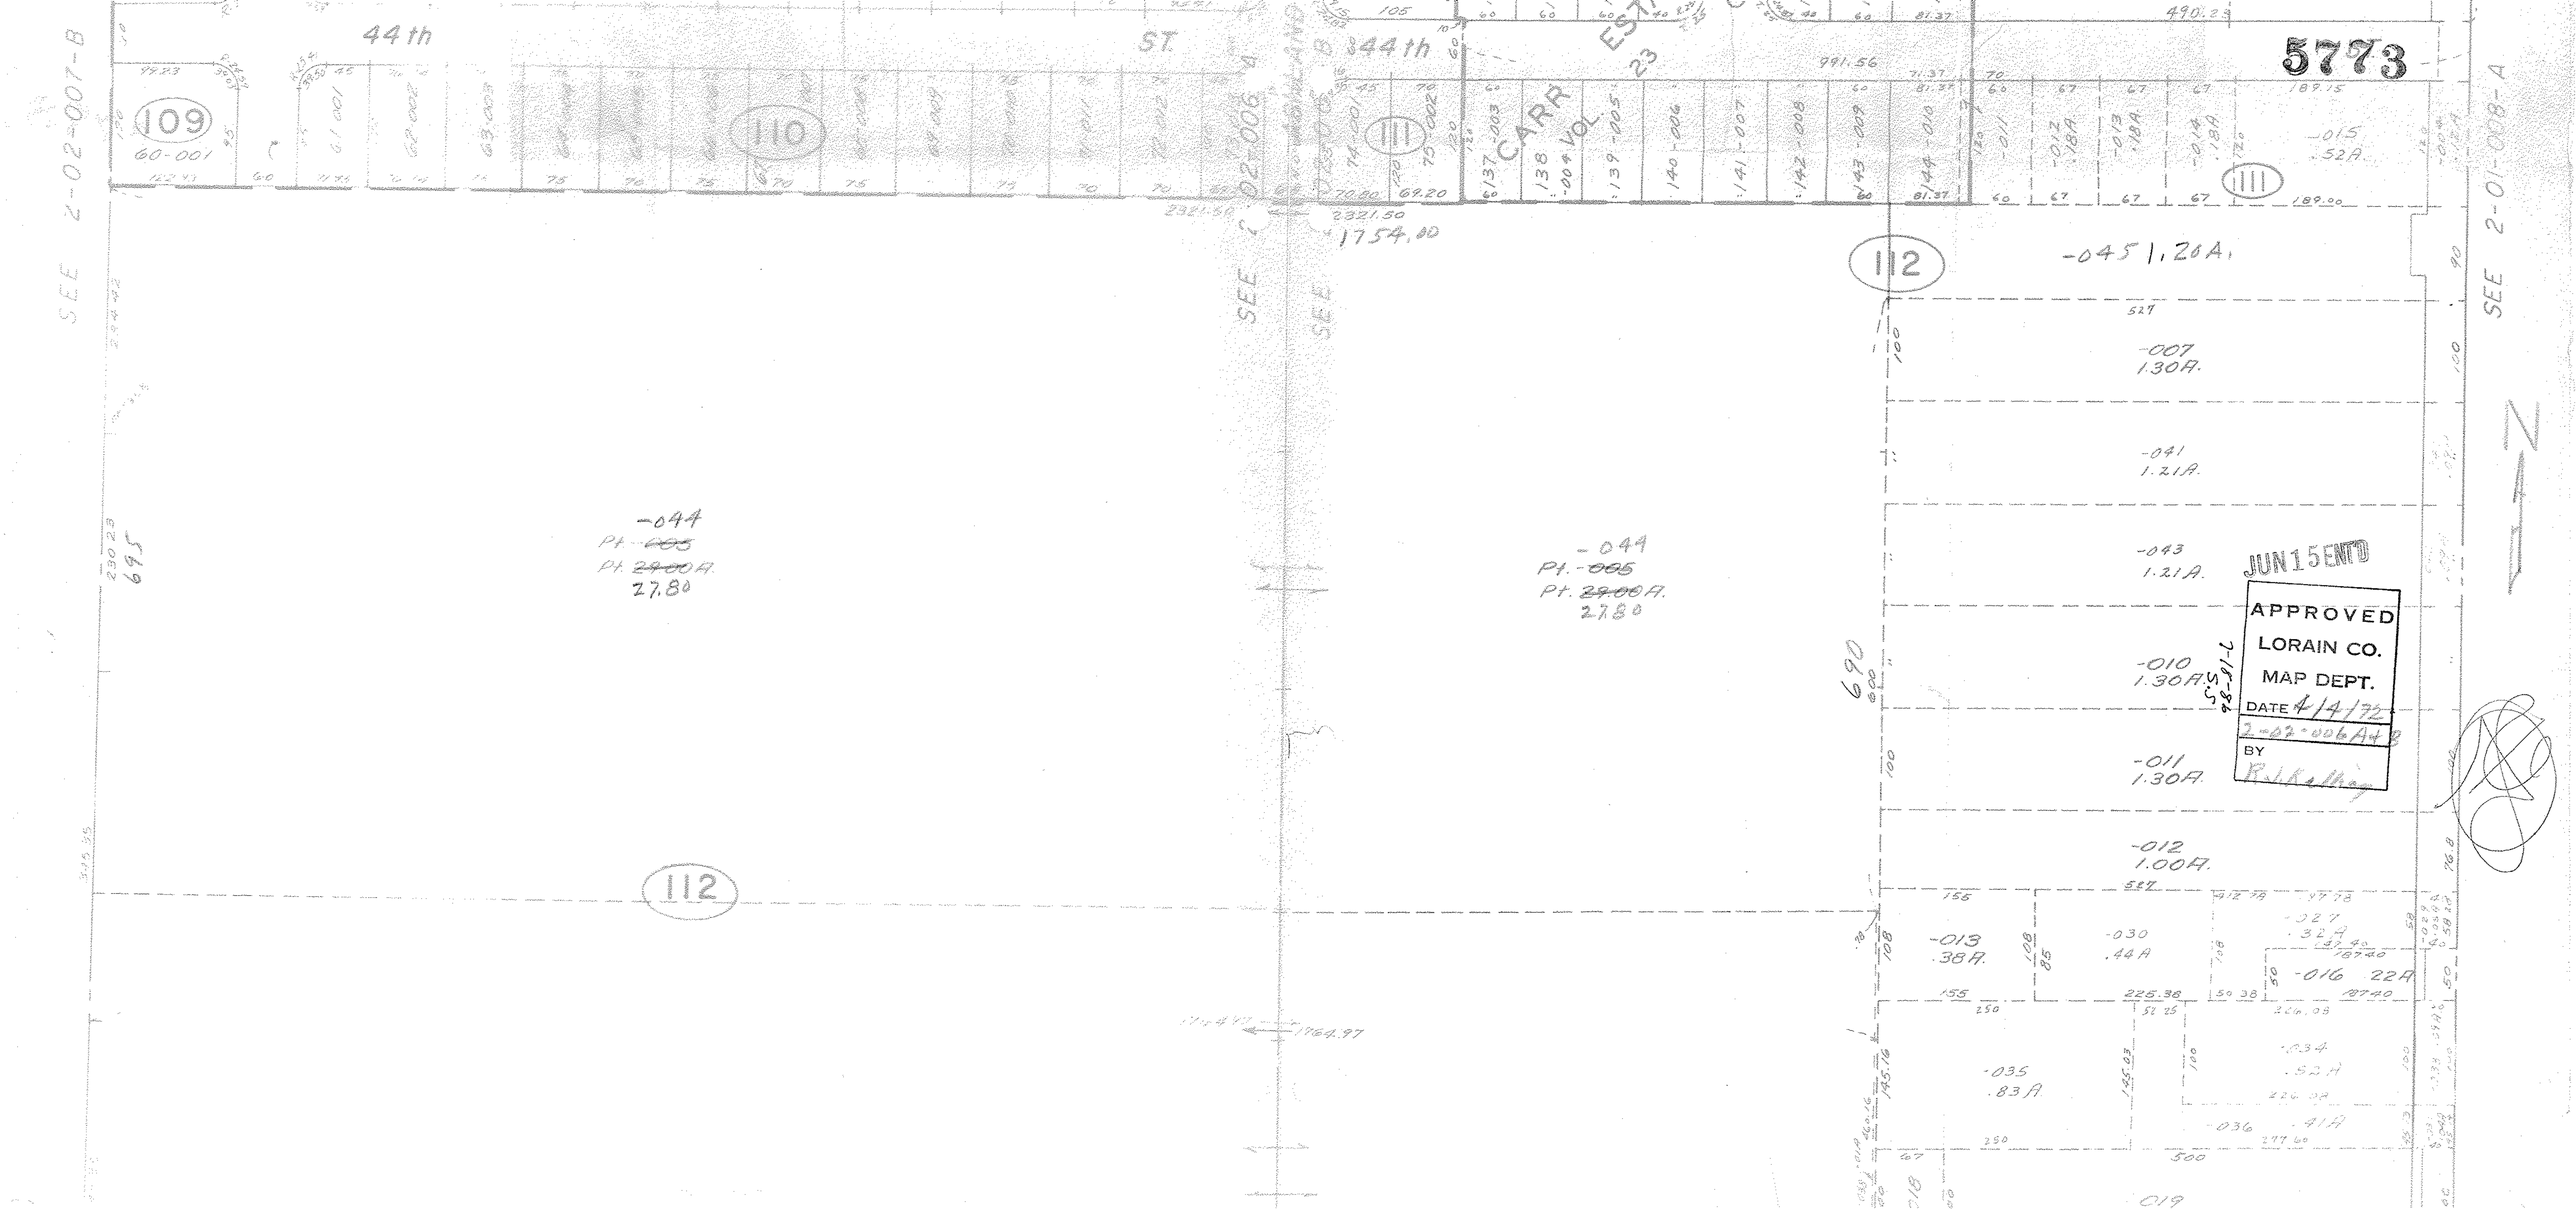
44th ST.
844th
5773
109
60-001
110
111
112
CARR
VOL. 23
SEE 2-02-007-B
SEE 2-01-008-A
-045 1.26A.
-007 1.30A.
-041 1.21A.
-043 1.21A.
-010 1.30A.
-011 1.30A.
-012 1.00A.
-013 .38A.
-030 .44A
-016 .22A
-035 .83A.
-036 .41A
-015 .52A.
-044
Pt. ~~-005~~
Pt. ~~29.00~~A.
27.80
JUN 15 ENTD
APPROVED
LORAIN CO.
MAP DEPT.
DATE 4/4/72
2-02-006A4B
BY
R.K. Kelley