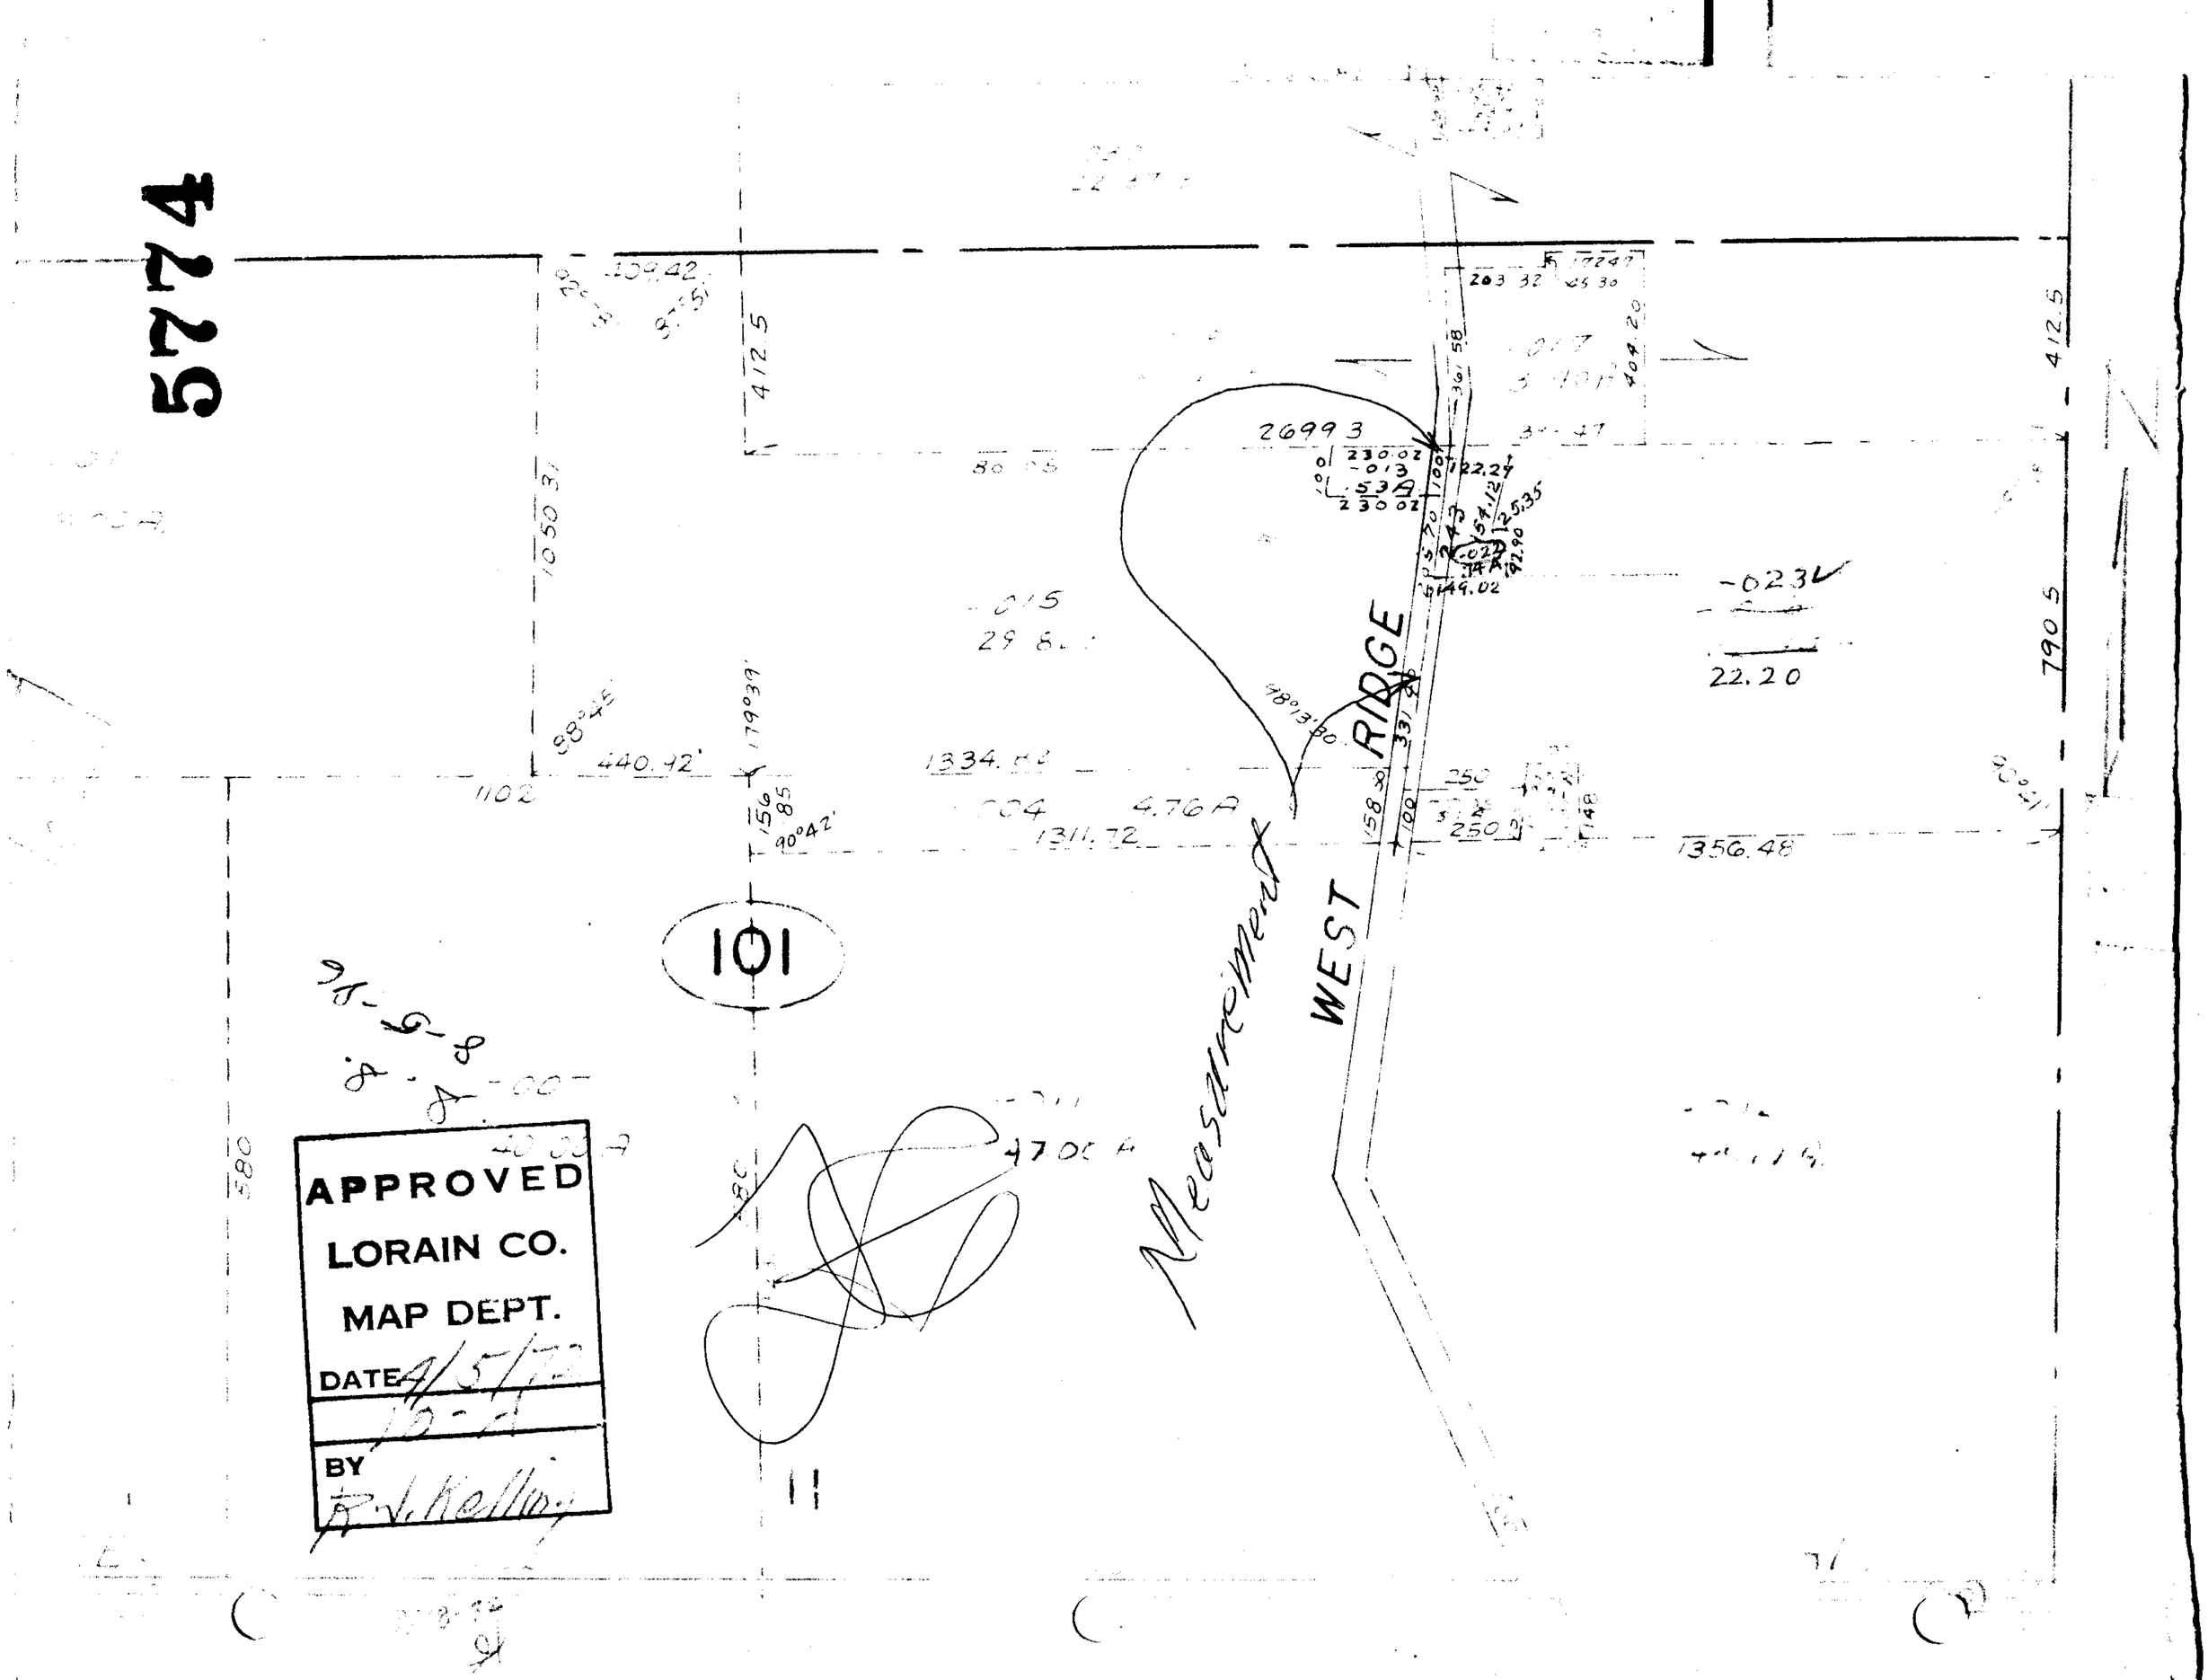
5774
101
WEST RIDGE
Measurement
26993
230.02
-013
.53A
230.02
122.27
25.35
149.02
-023
22.20
1334.82
1311.72
4.76A
1356.48
440.42'
1102
412.5
790.5
580
47.00 A
APPROVED
LORAIN CO.
MAP DEPT.
DATE 4/5/72
BY
R. J. Kelling