


6-79  
06-24 16-103016  
017

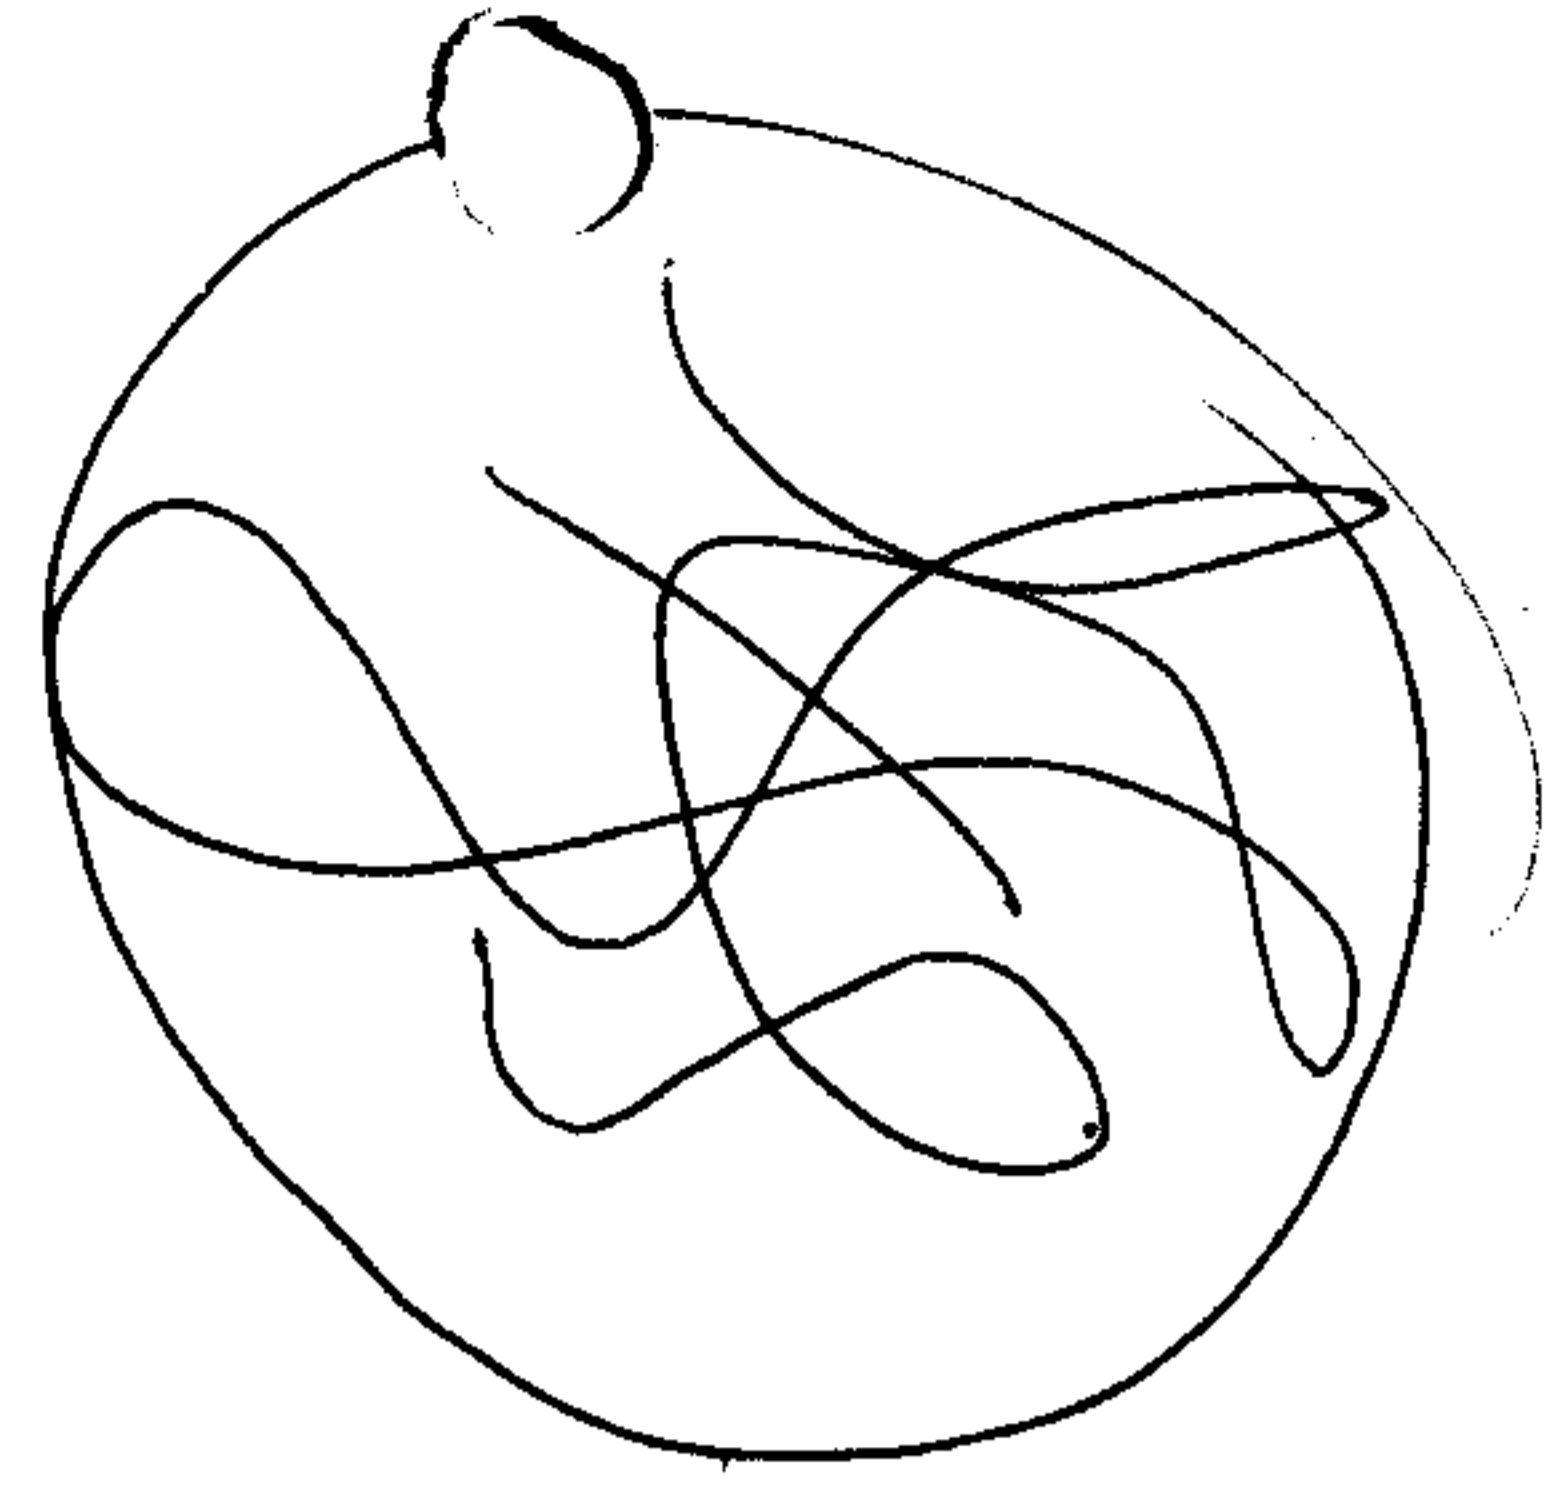


APPROVED  
LORAIN CO.  
MAP DEPT.  
DATE 4-6-72  
6-79  
BY *Hollert*

9/18-72  
*J*

5775

SEE 6-61

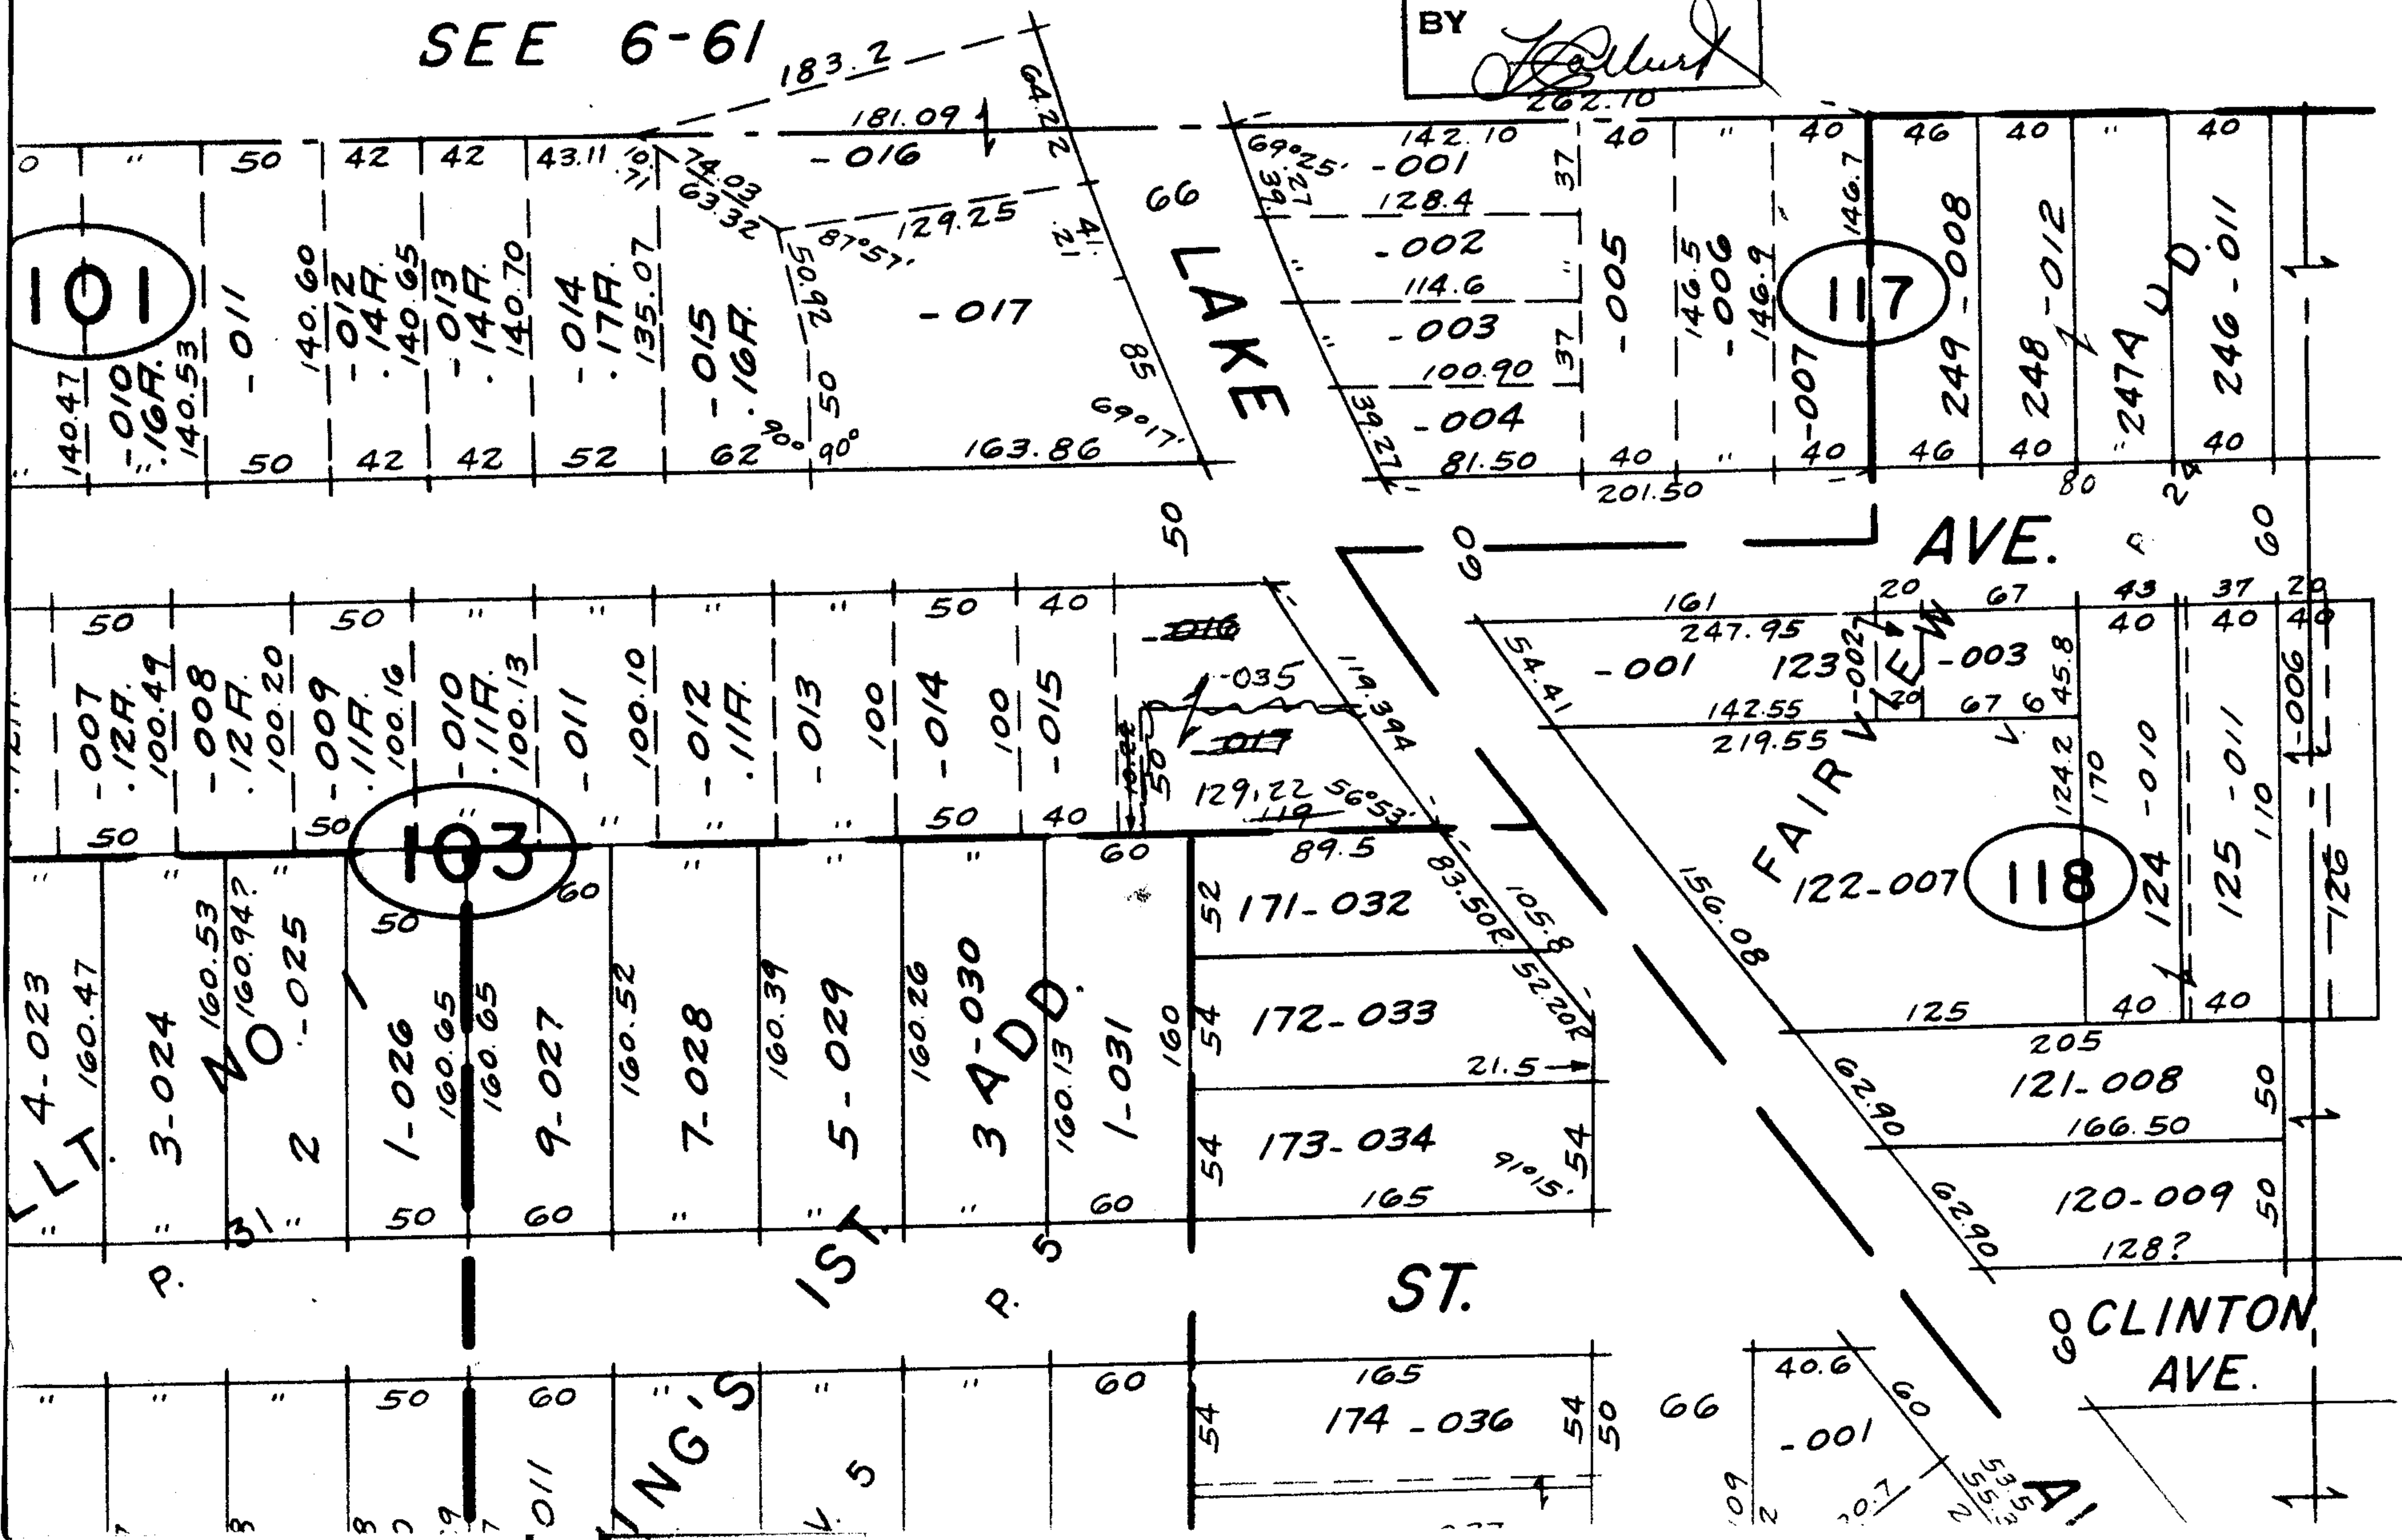

119  
10.22  
129.22