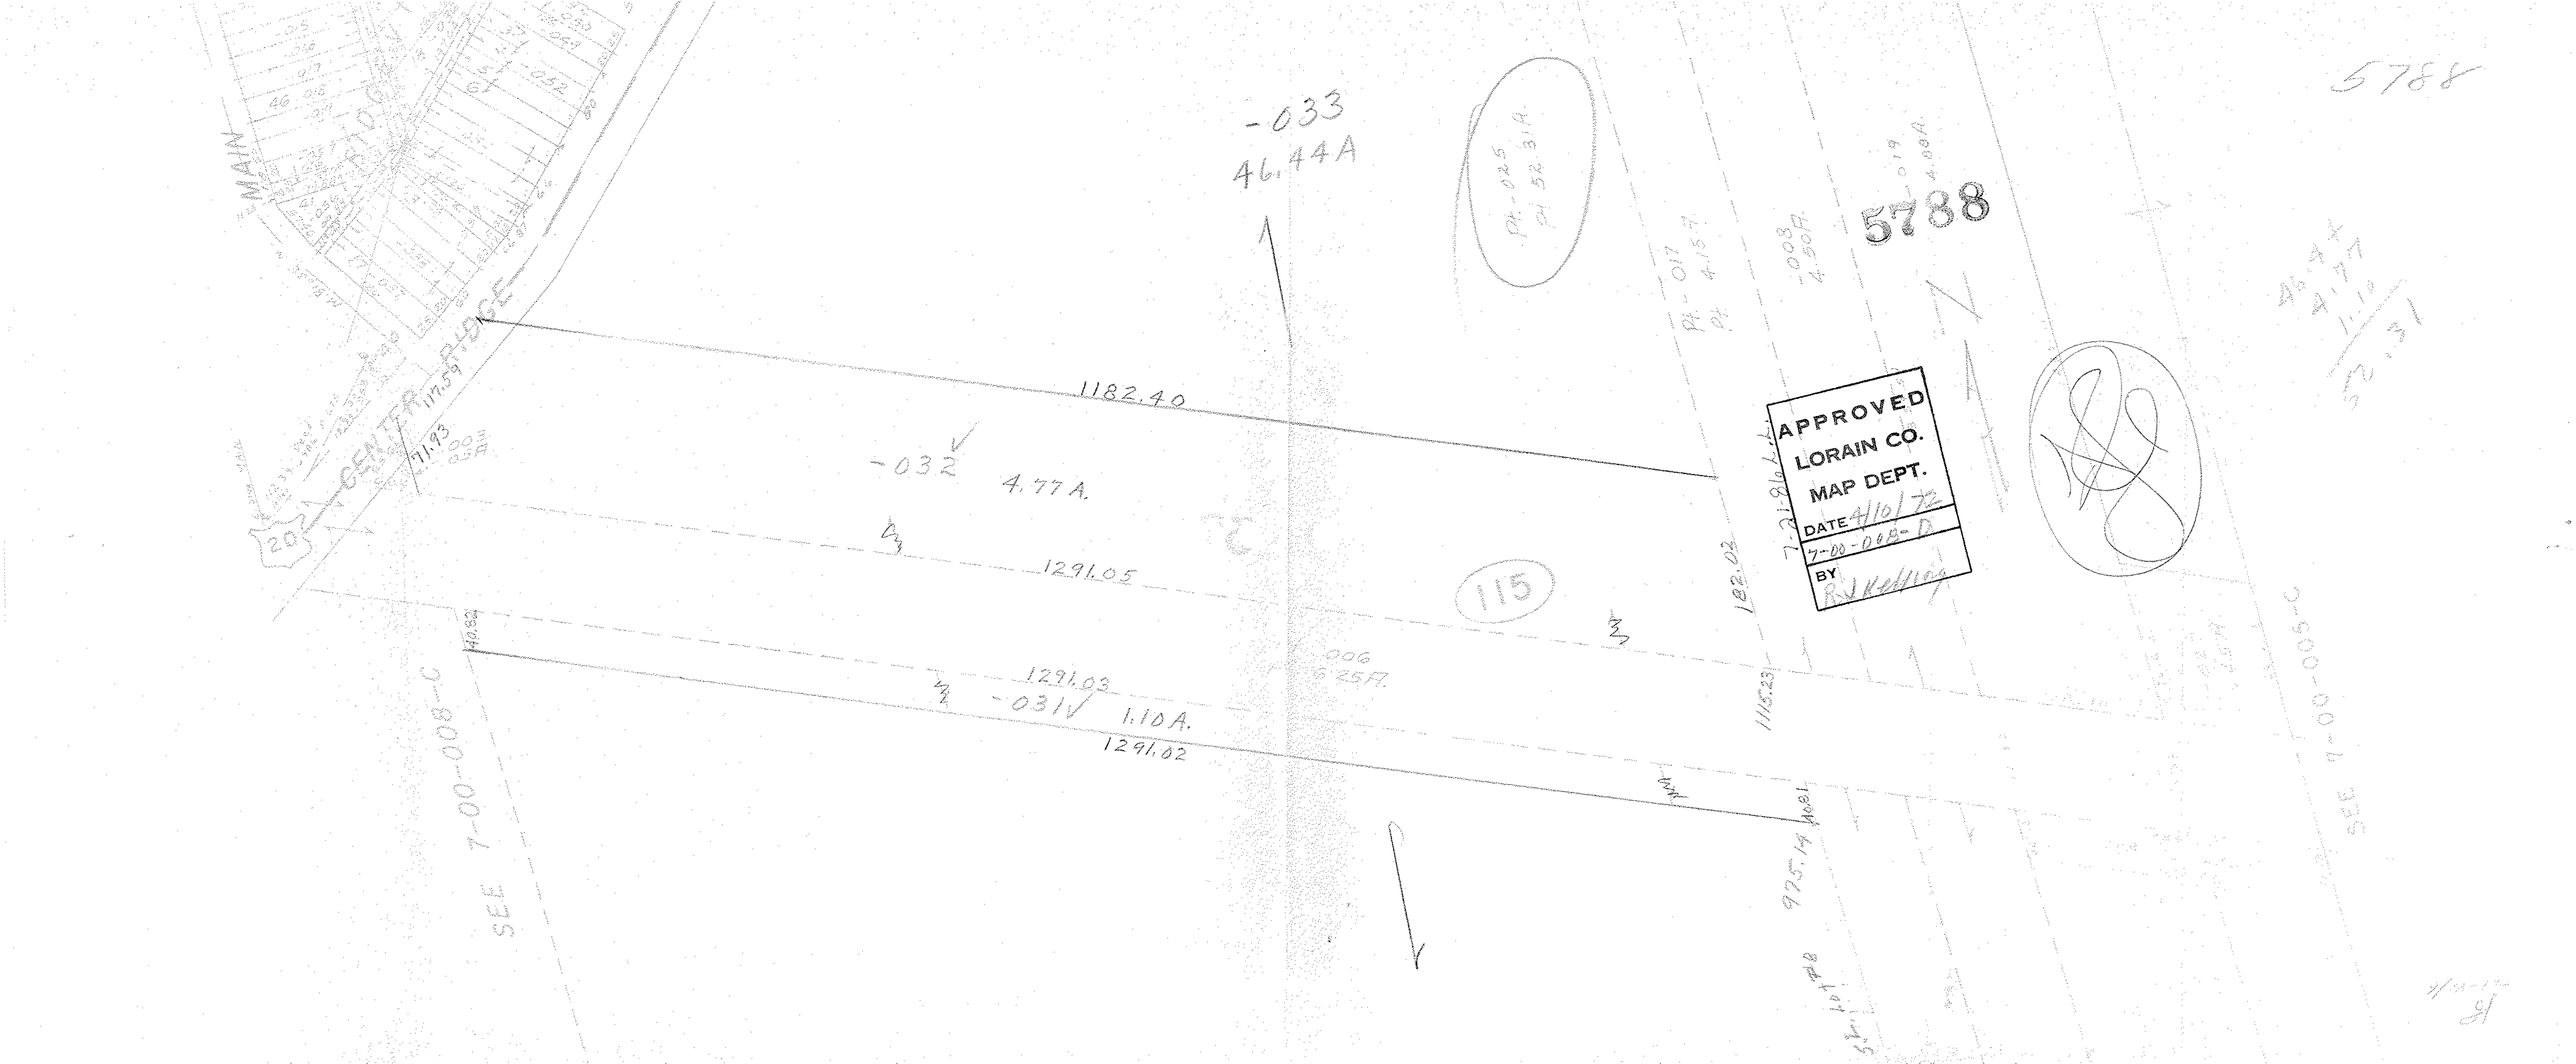
5788
-033
46.44A
5788
1182.40
-032
4.77A.
1291.05
1291.03
-031
1.10A.
1291.02
115
APPROVED
LORAIN CO.
MAP DEPT.
DATE 4/10/72
7-00-008-D
BY
MAIN
CENTER RIDGE
SEE 7-00-008-C
SEE 7-00-005-C