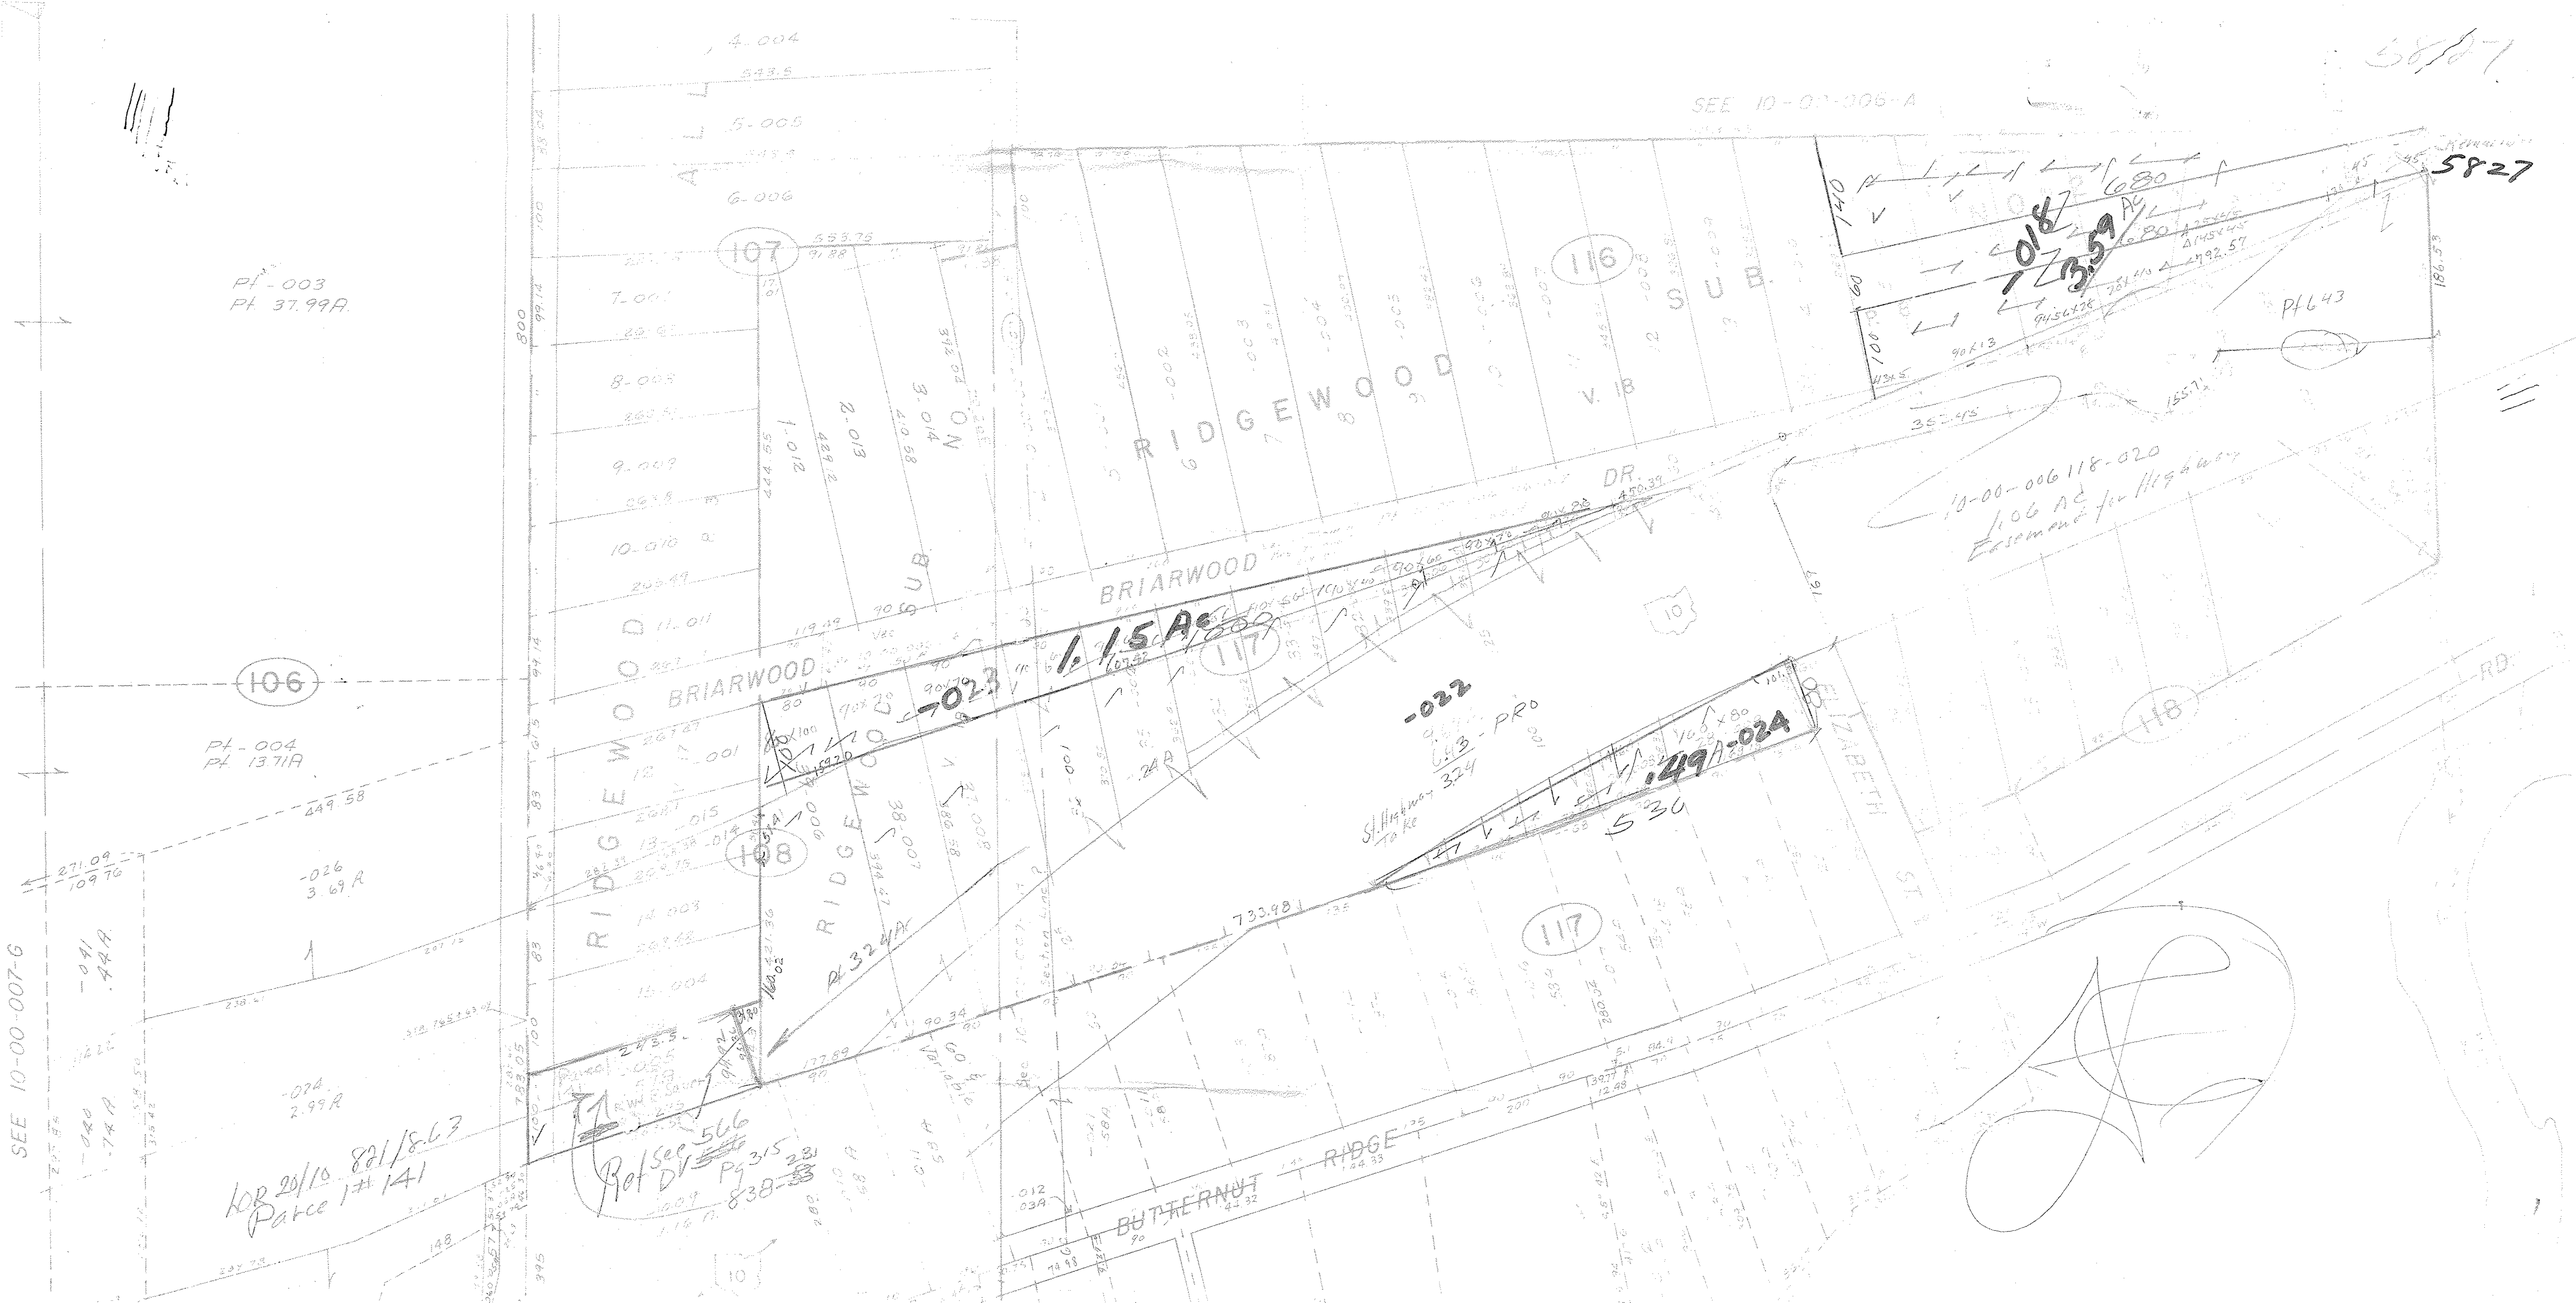
5827
SEE 10-00-006-A
SEE 10-00-007-6
RIDGEWOOD
BRIARWOOD
DR
RIDGE
BUTTERNUT
ELIZABETH
ST
RD
107
106
108
116
117
118
10
Pt-003
Pt 37.99A
Pt-004
Pt 13.71A
-026
3.69 R
-041
4.44
-024
2.99 R
-042
1.74 R
-023
1.15 Ac
-022
-024
.49
.018
1.39 Ac
Pt 643
10-00-006 118-020
.06 Ac
Easement for Highway
Pt 324 A
LOR 20/10 821/863
Parcel #141
Ref Sec 566
DV Pg 315
838-281