


5833

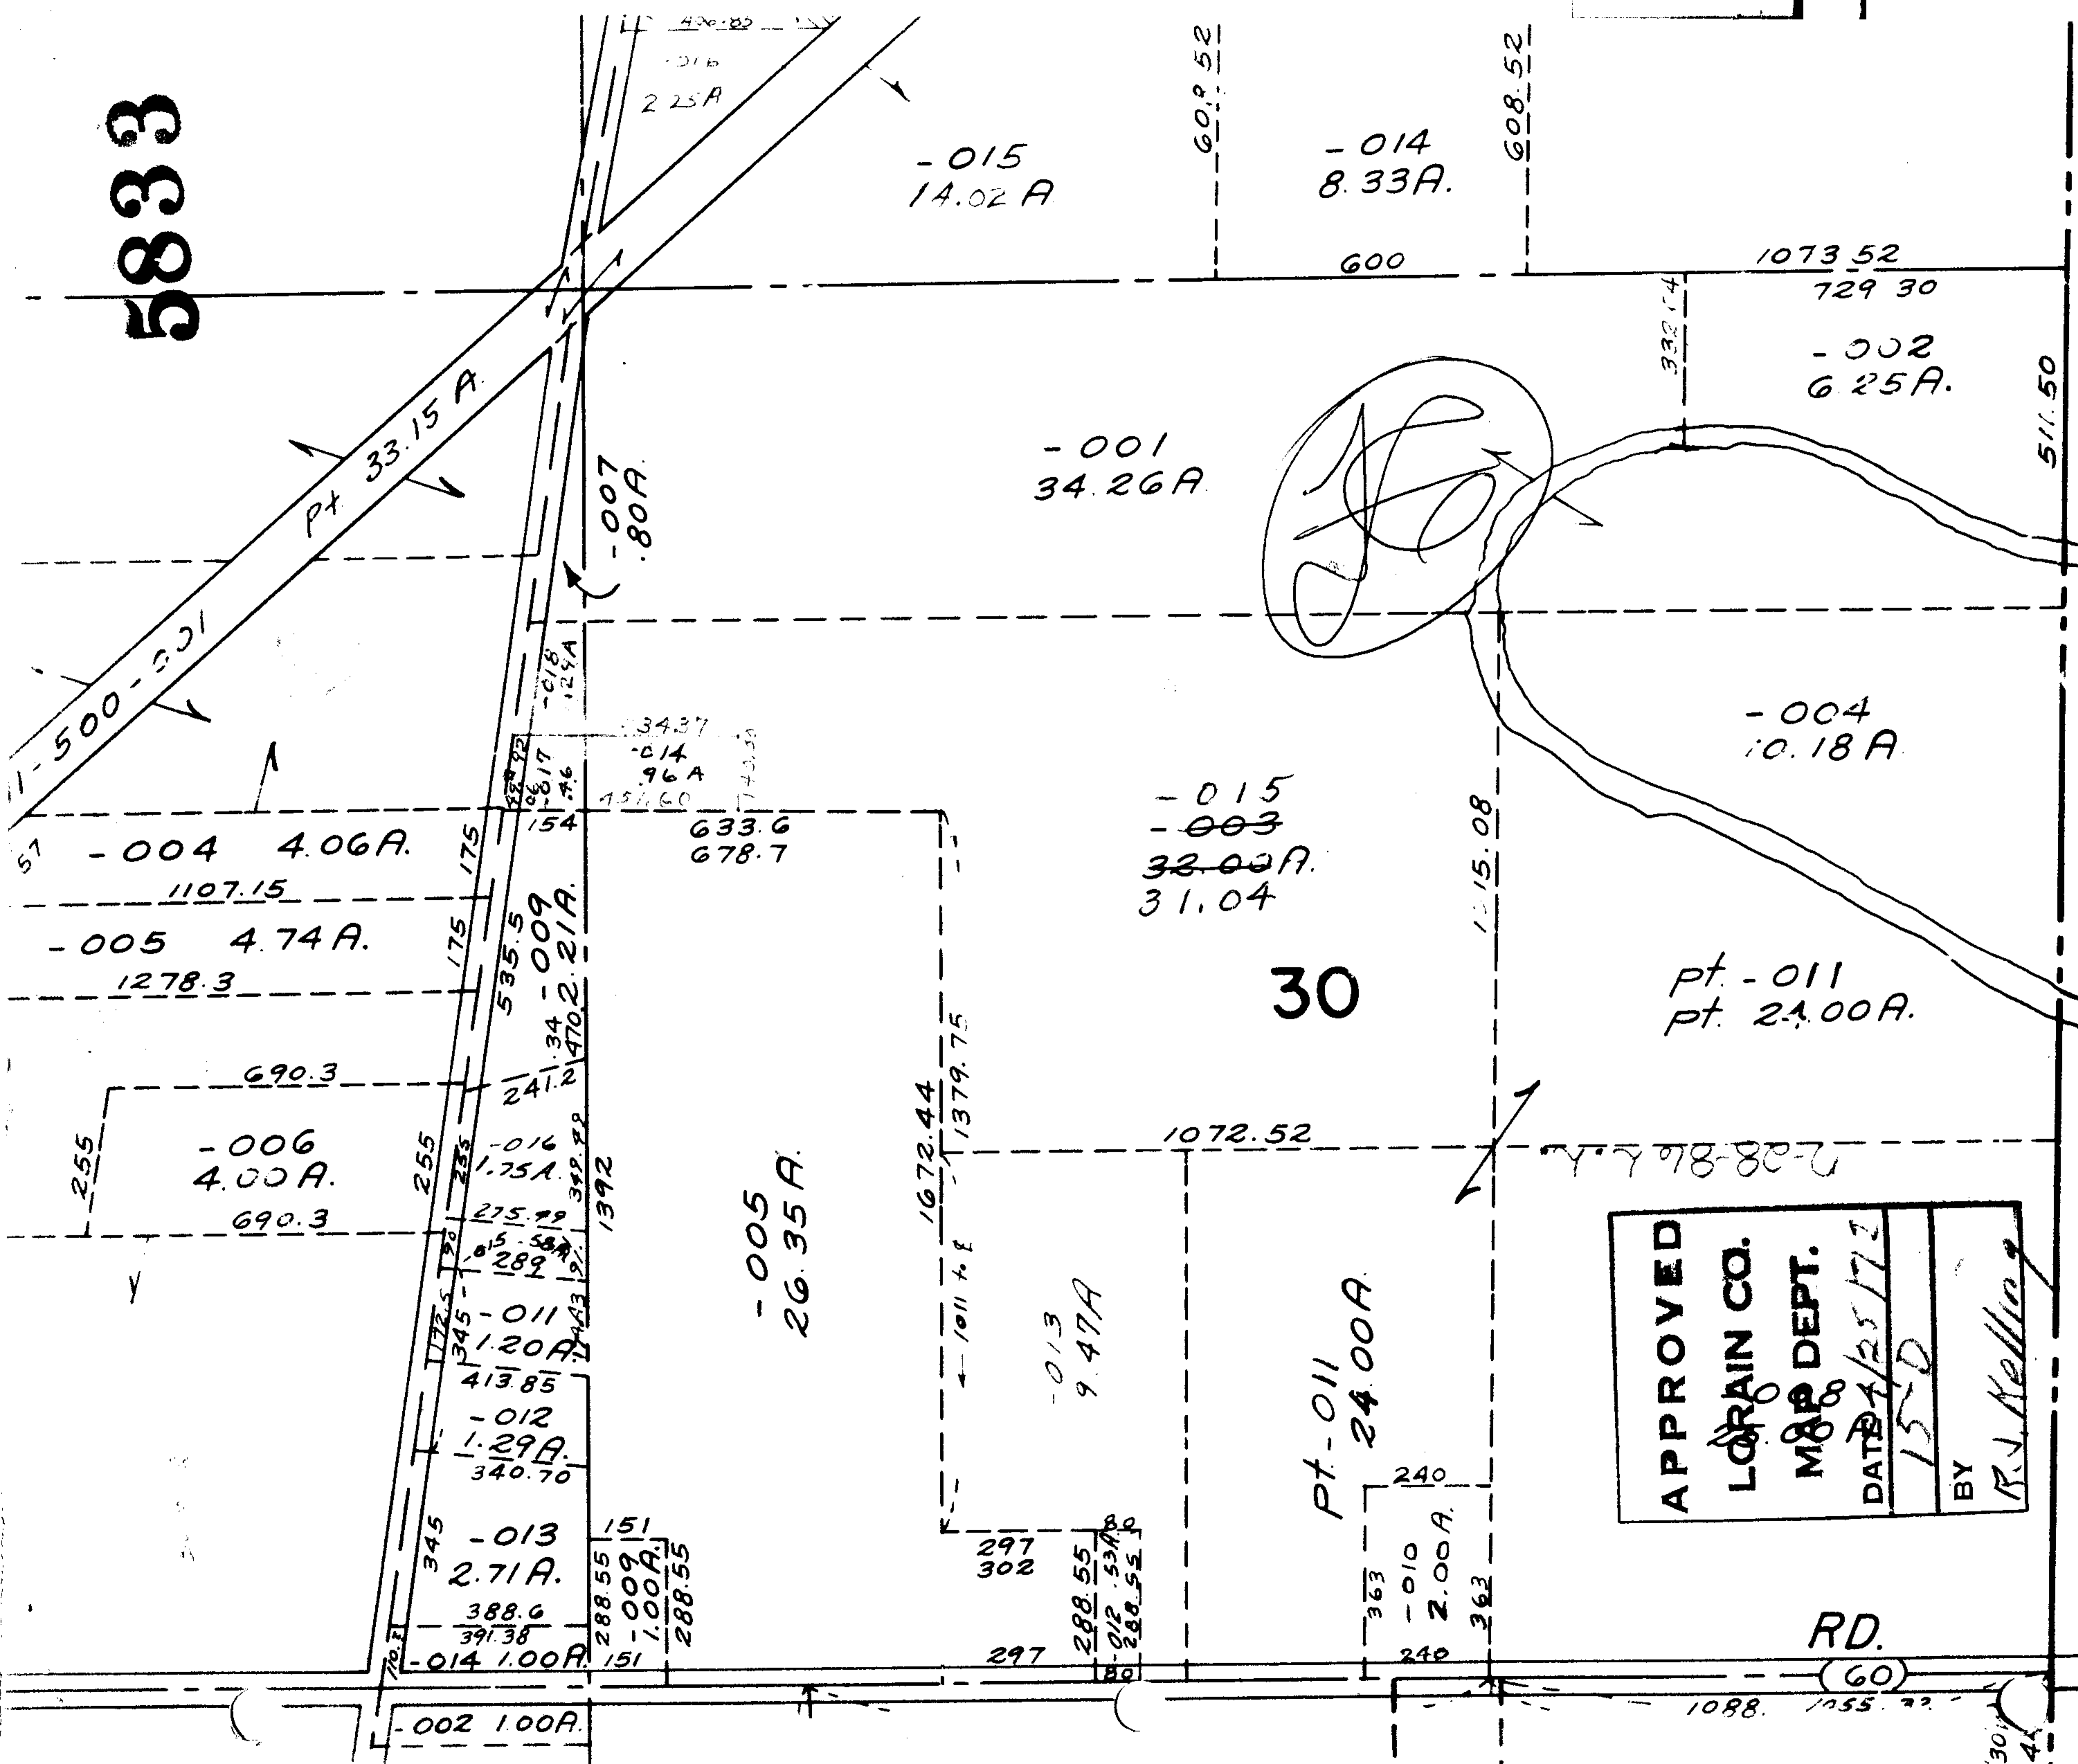

APPROVED  
 LORAIN CO.  
 MAP DEPT.  
 DATE 4/25/72  
 BY R.J. Nelling

RD.

(60)

30



30  
4