

SEE 2-

766.98

106

STREET DEDICATION PLAT  
VOL. 25 PG. 17  
181A

BOULEVA

TOWER

753.77  
152.68 285.84

Pt. -093

-105  
75A

02-01-008


5842 4.50  
5844 7-18-86  
SS

APPROX  
LORAIN CO.  
MAP DEPT.  
DATE 5-1-72  
02-01-008H  
BY

5844

5842

5780

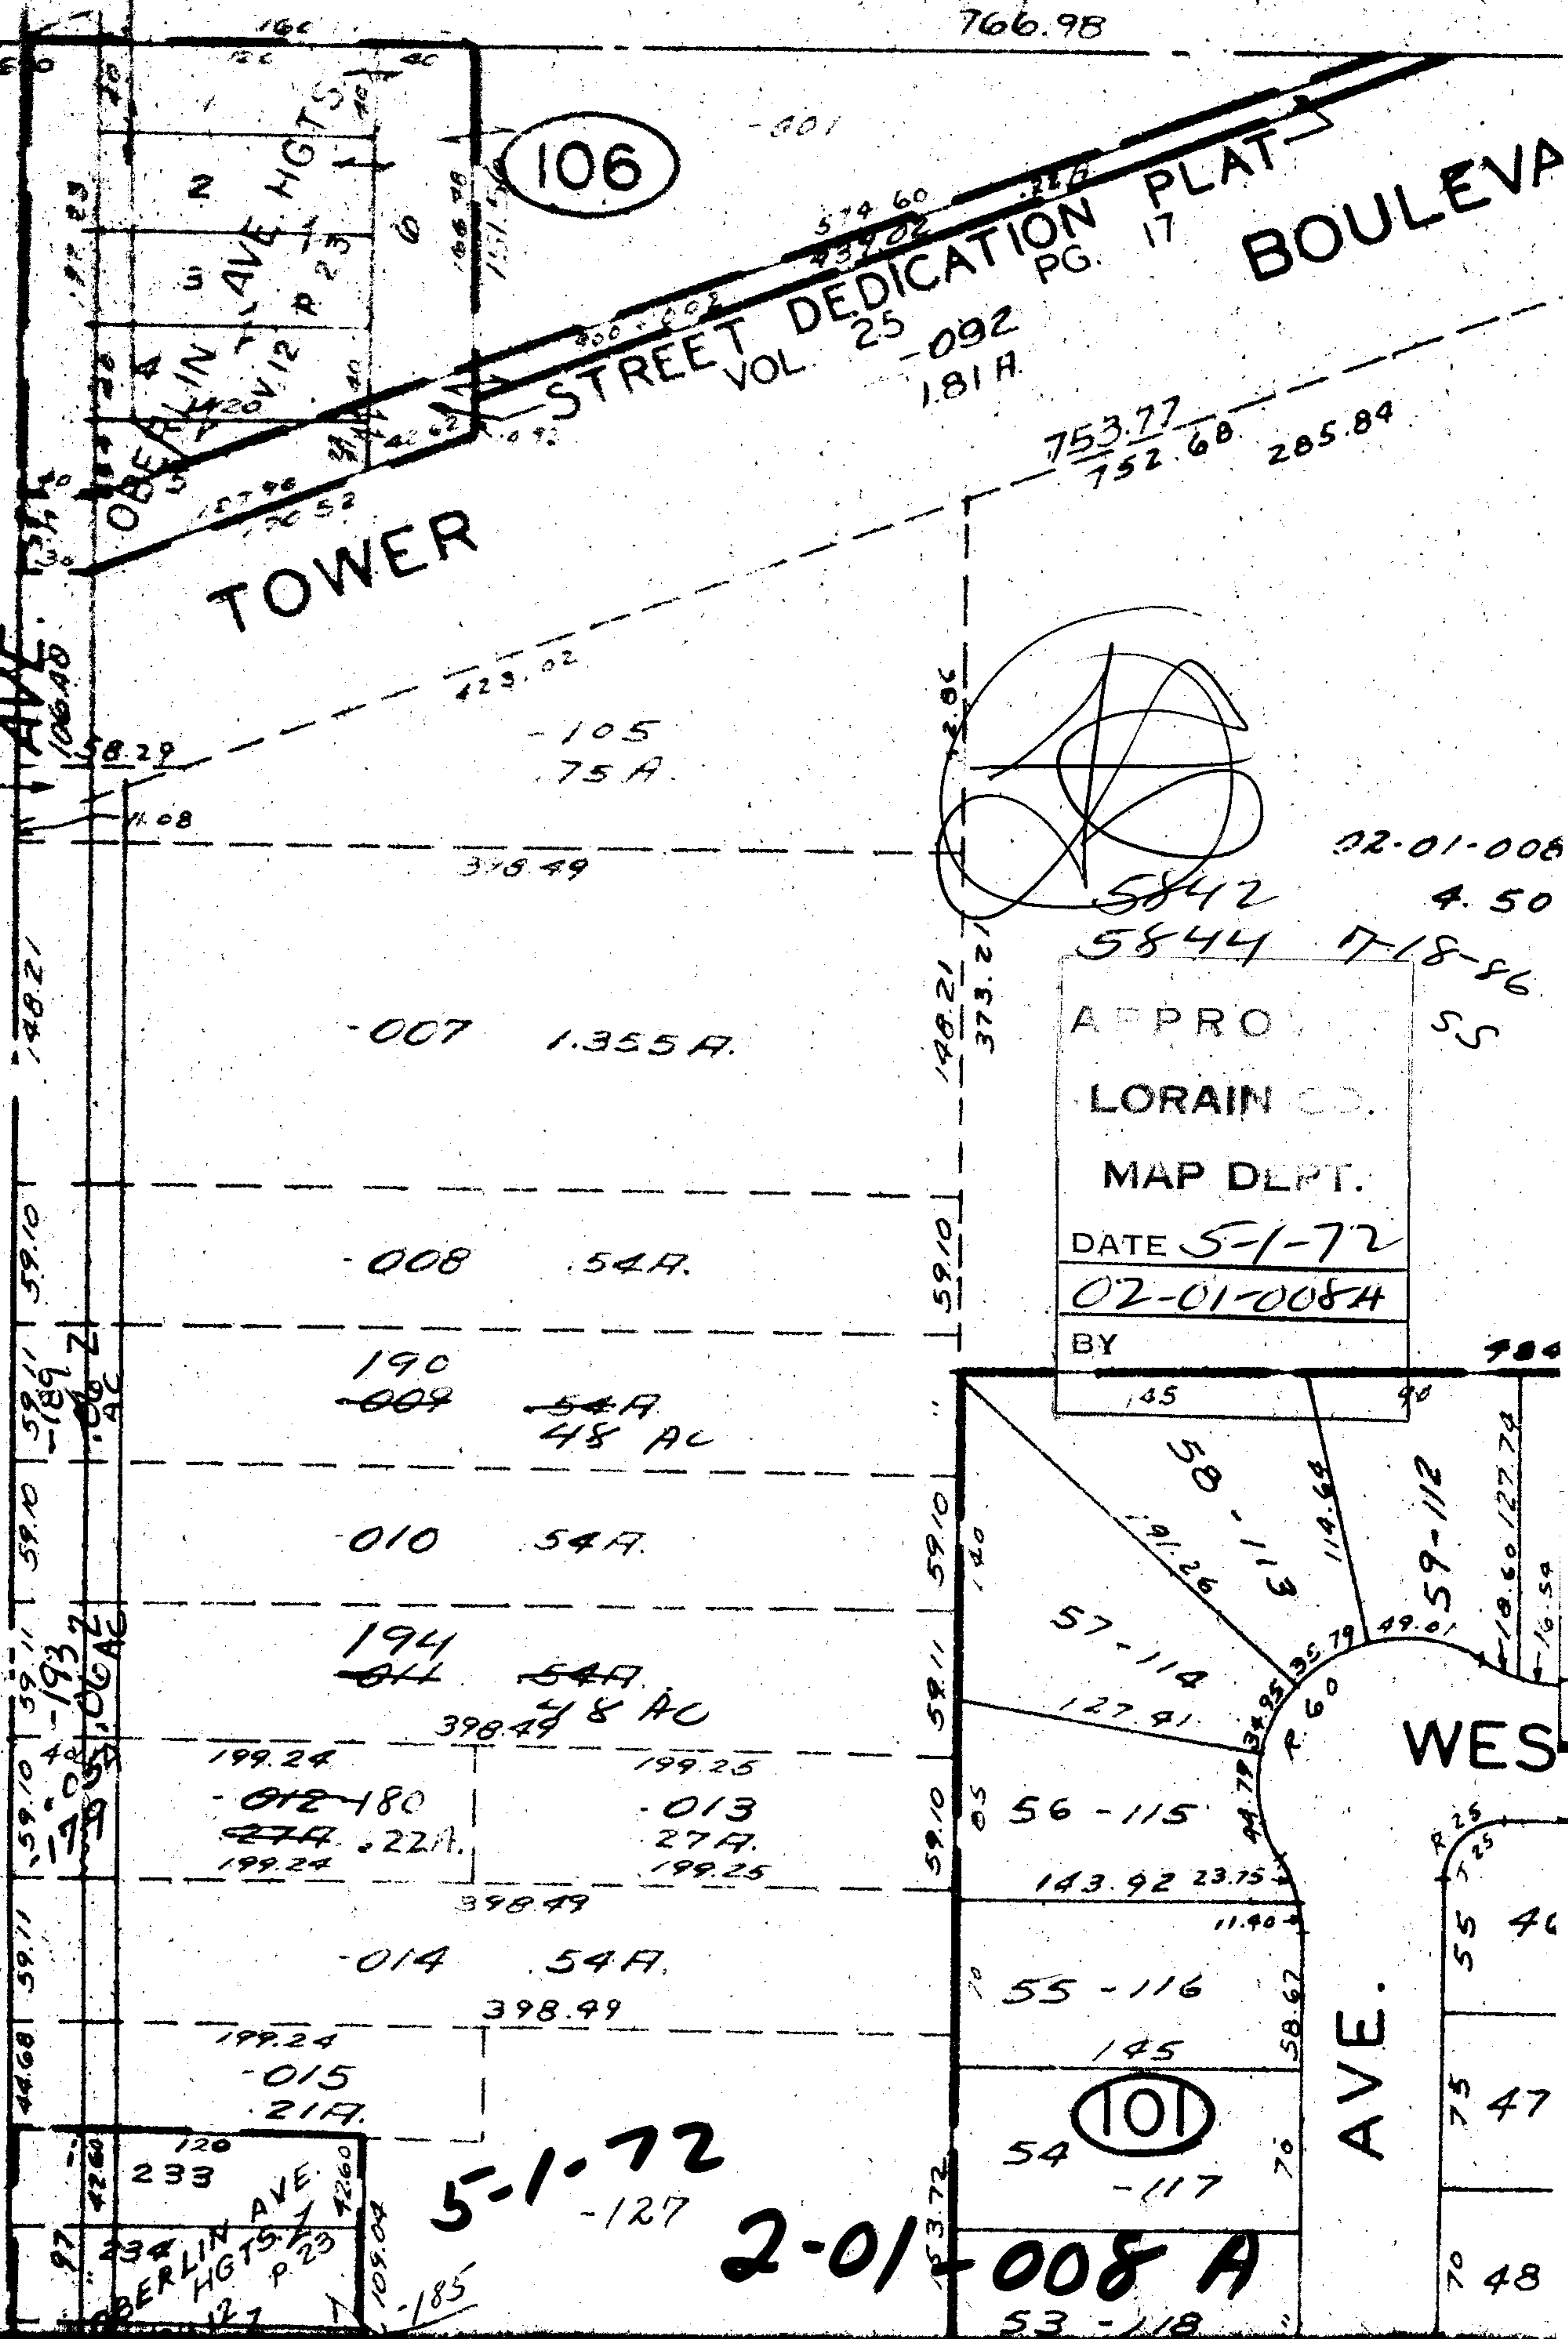

5-1-72  
-127

2-01-008A

WES

AVE.

101

