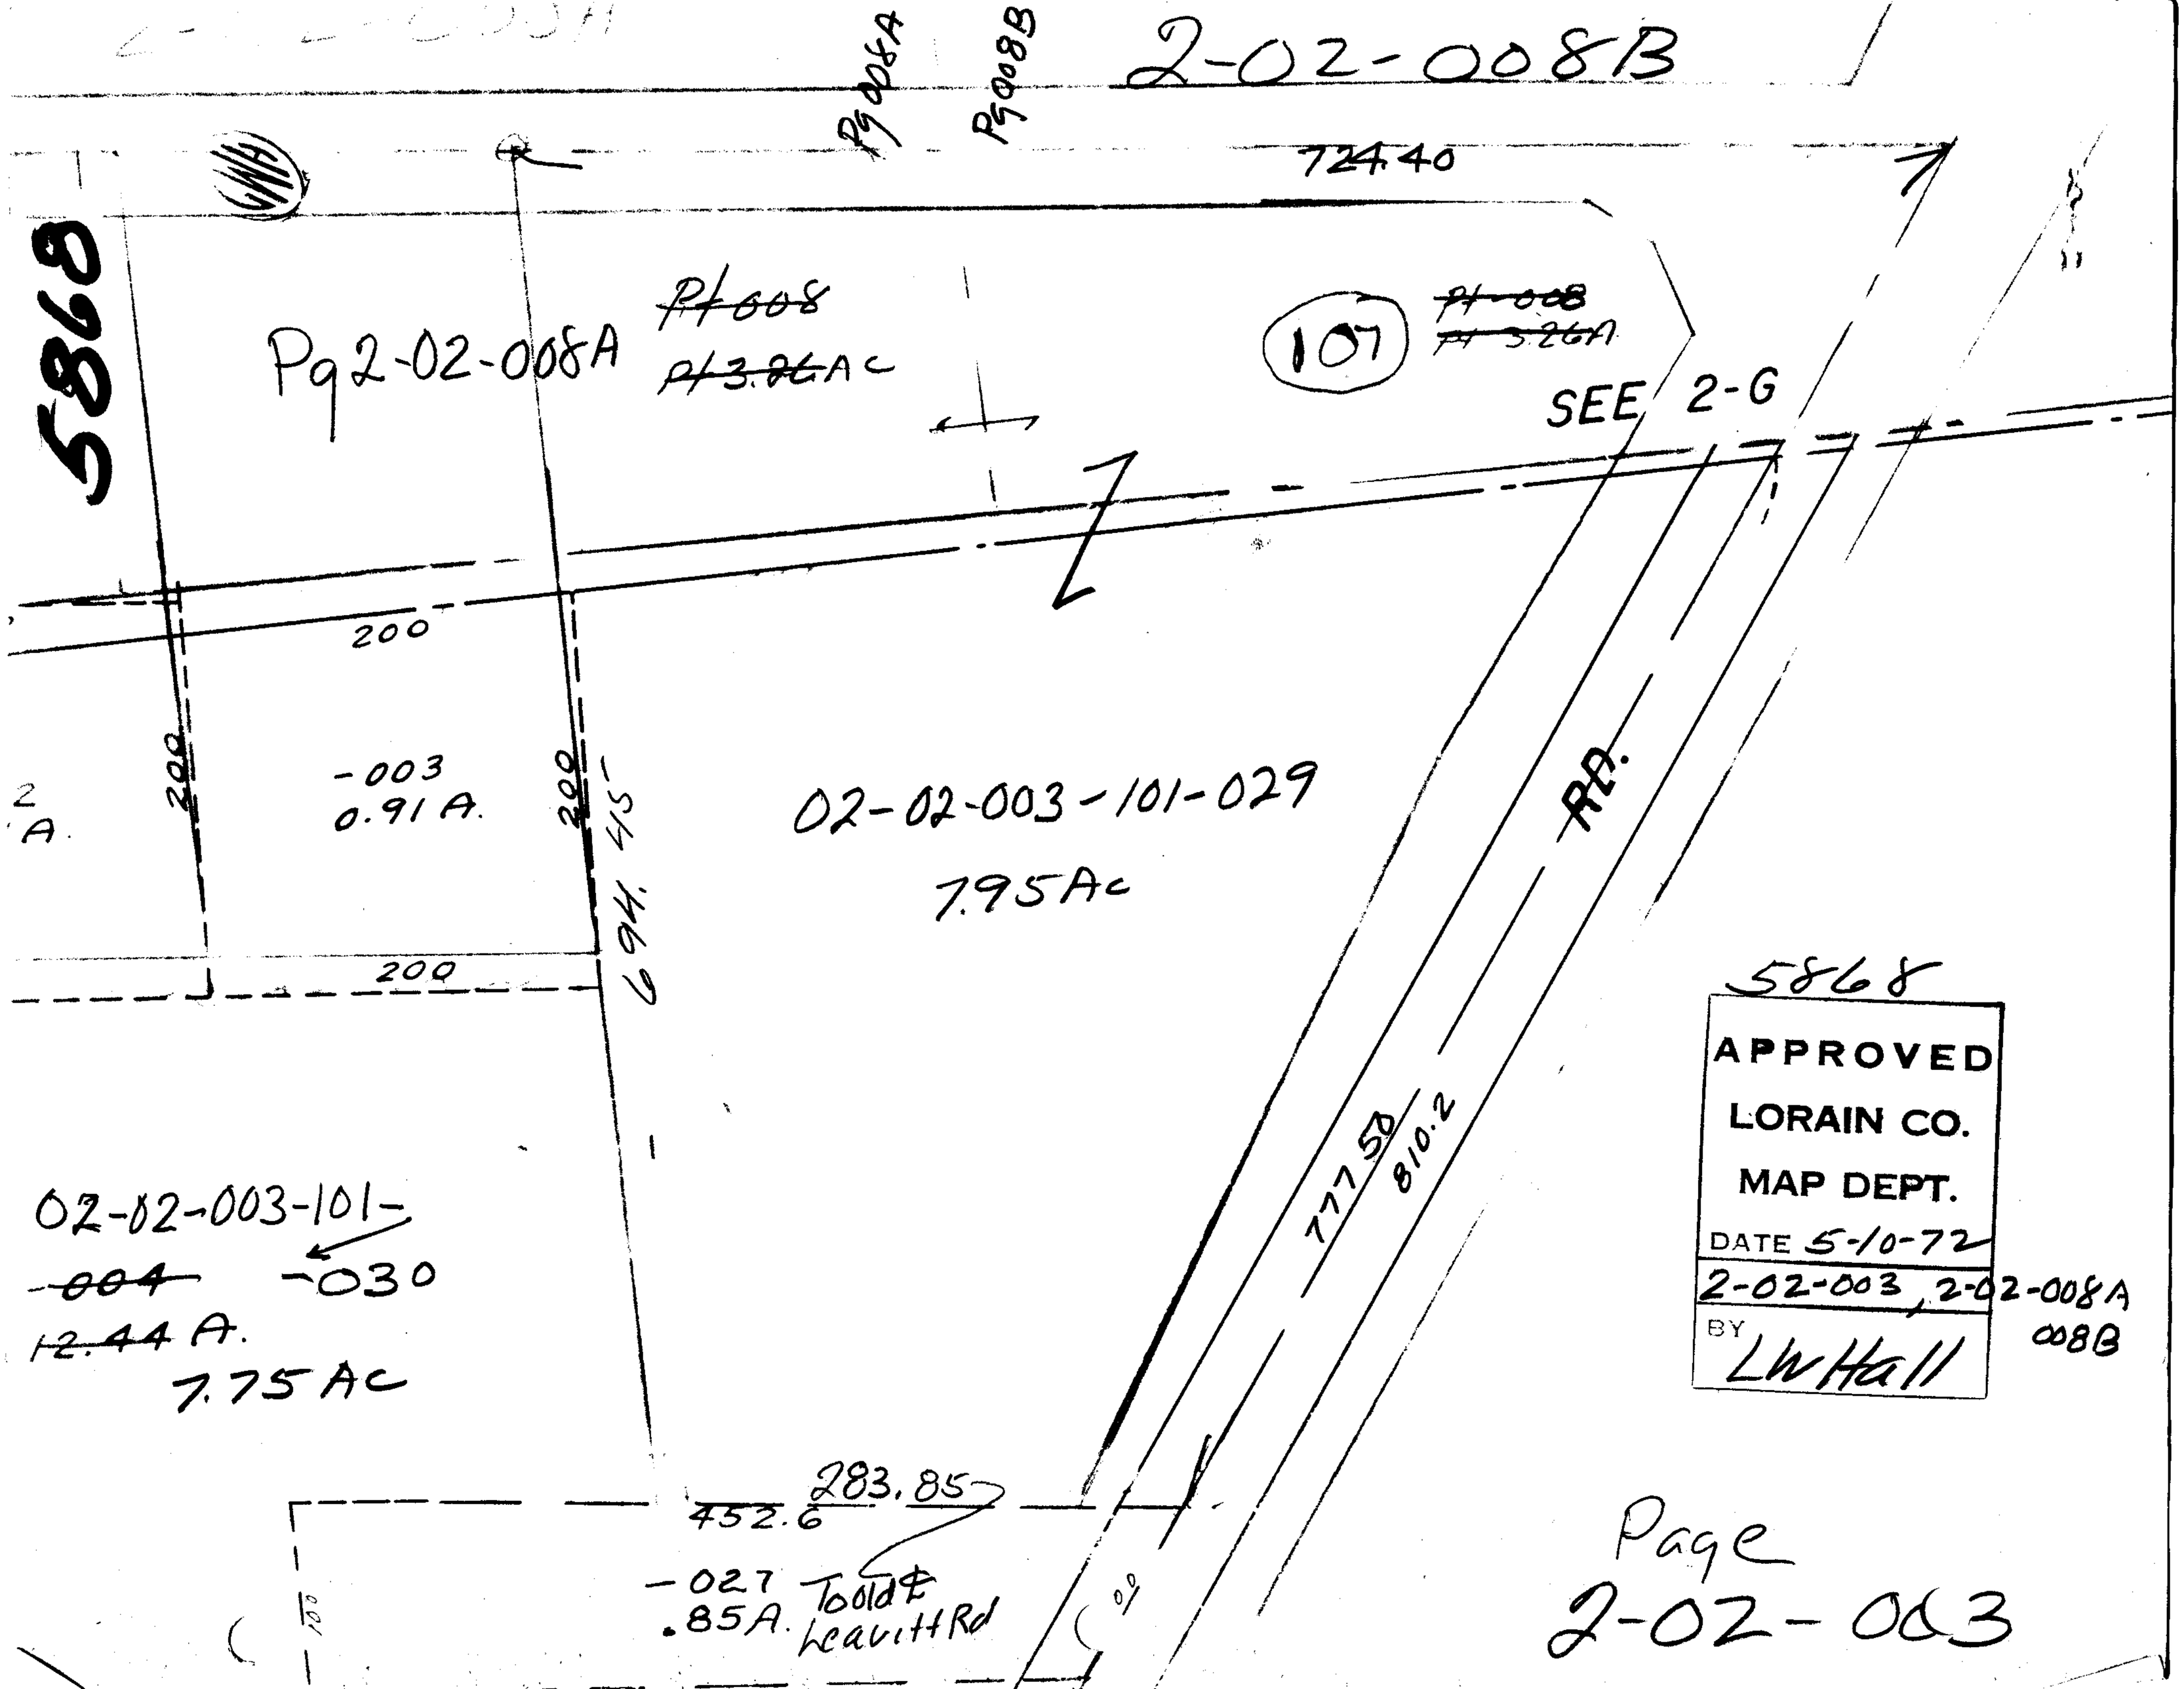
2-02-008B
Pg008A
Pg008B
724.40
5868
Pg2-02-008A
~~Pl 008~~
~~Pl 3.26~~ AC
107
~~Pl 008~~
~~Pl 3.26A~~
SEE 2-G
200
-003
0.91 A.
200
694.45
02-02-003-101-029
7.95 Ac
RD.
777.50
810.2
5868
APPROVED
LORAIN CO.
MAP DEPT.
DATE 5-10-72
2-02-003, 2-02-008A
008B
BY LW Hall
02-02-003-101-
~~004~~ -030
~~12.44~~ A.
7.75 AC
283.85
452.6
-027
.85A.
Toold & Leavitt Rd
Page
2-02-003