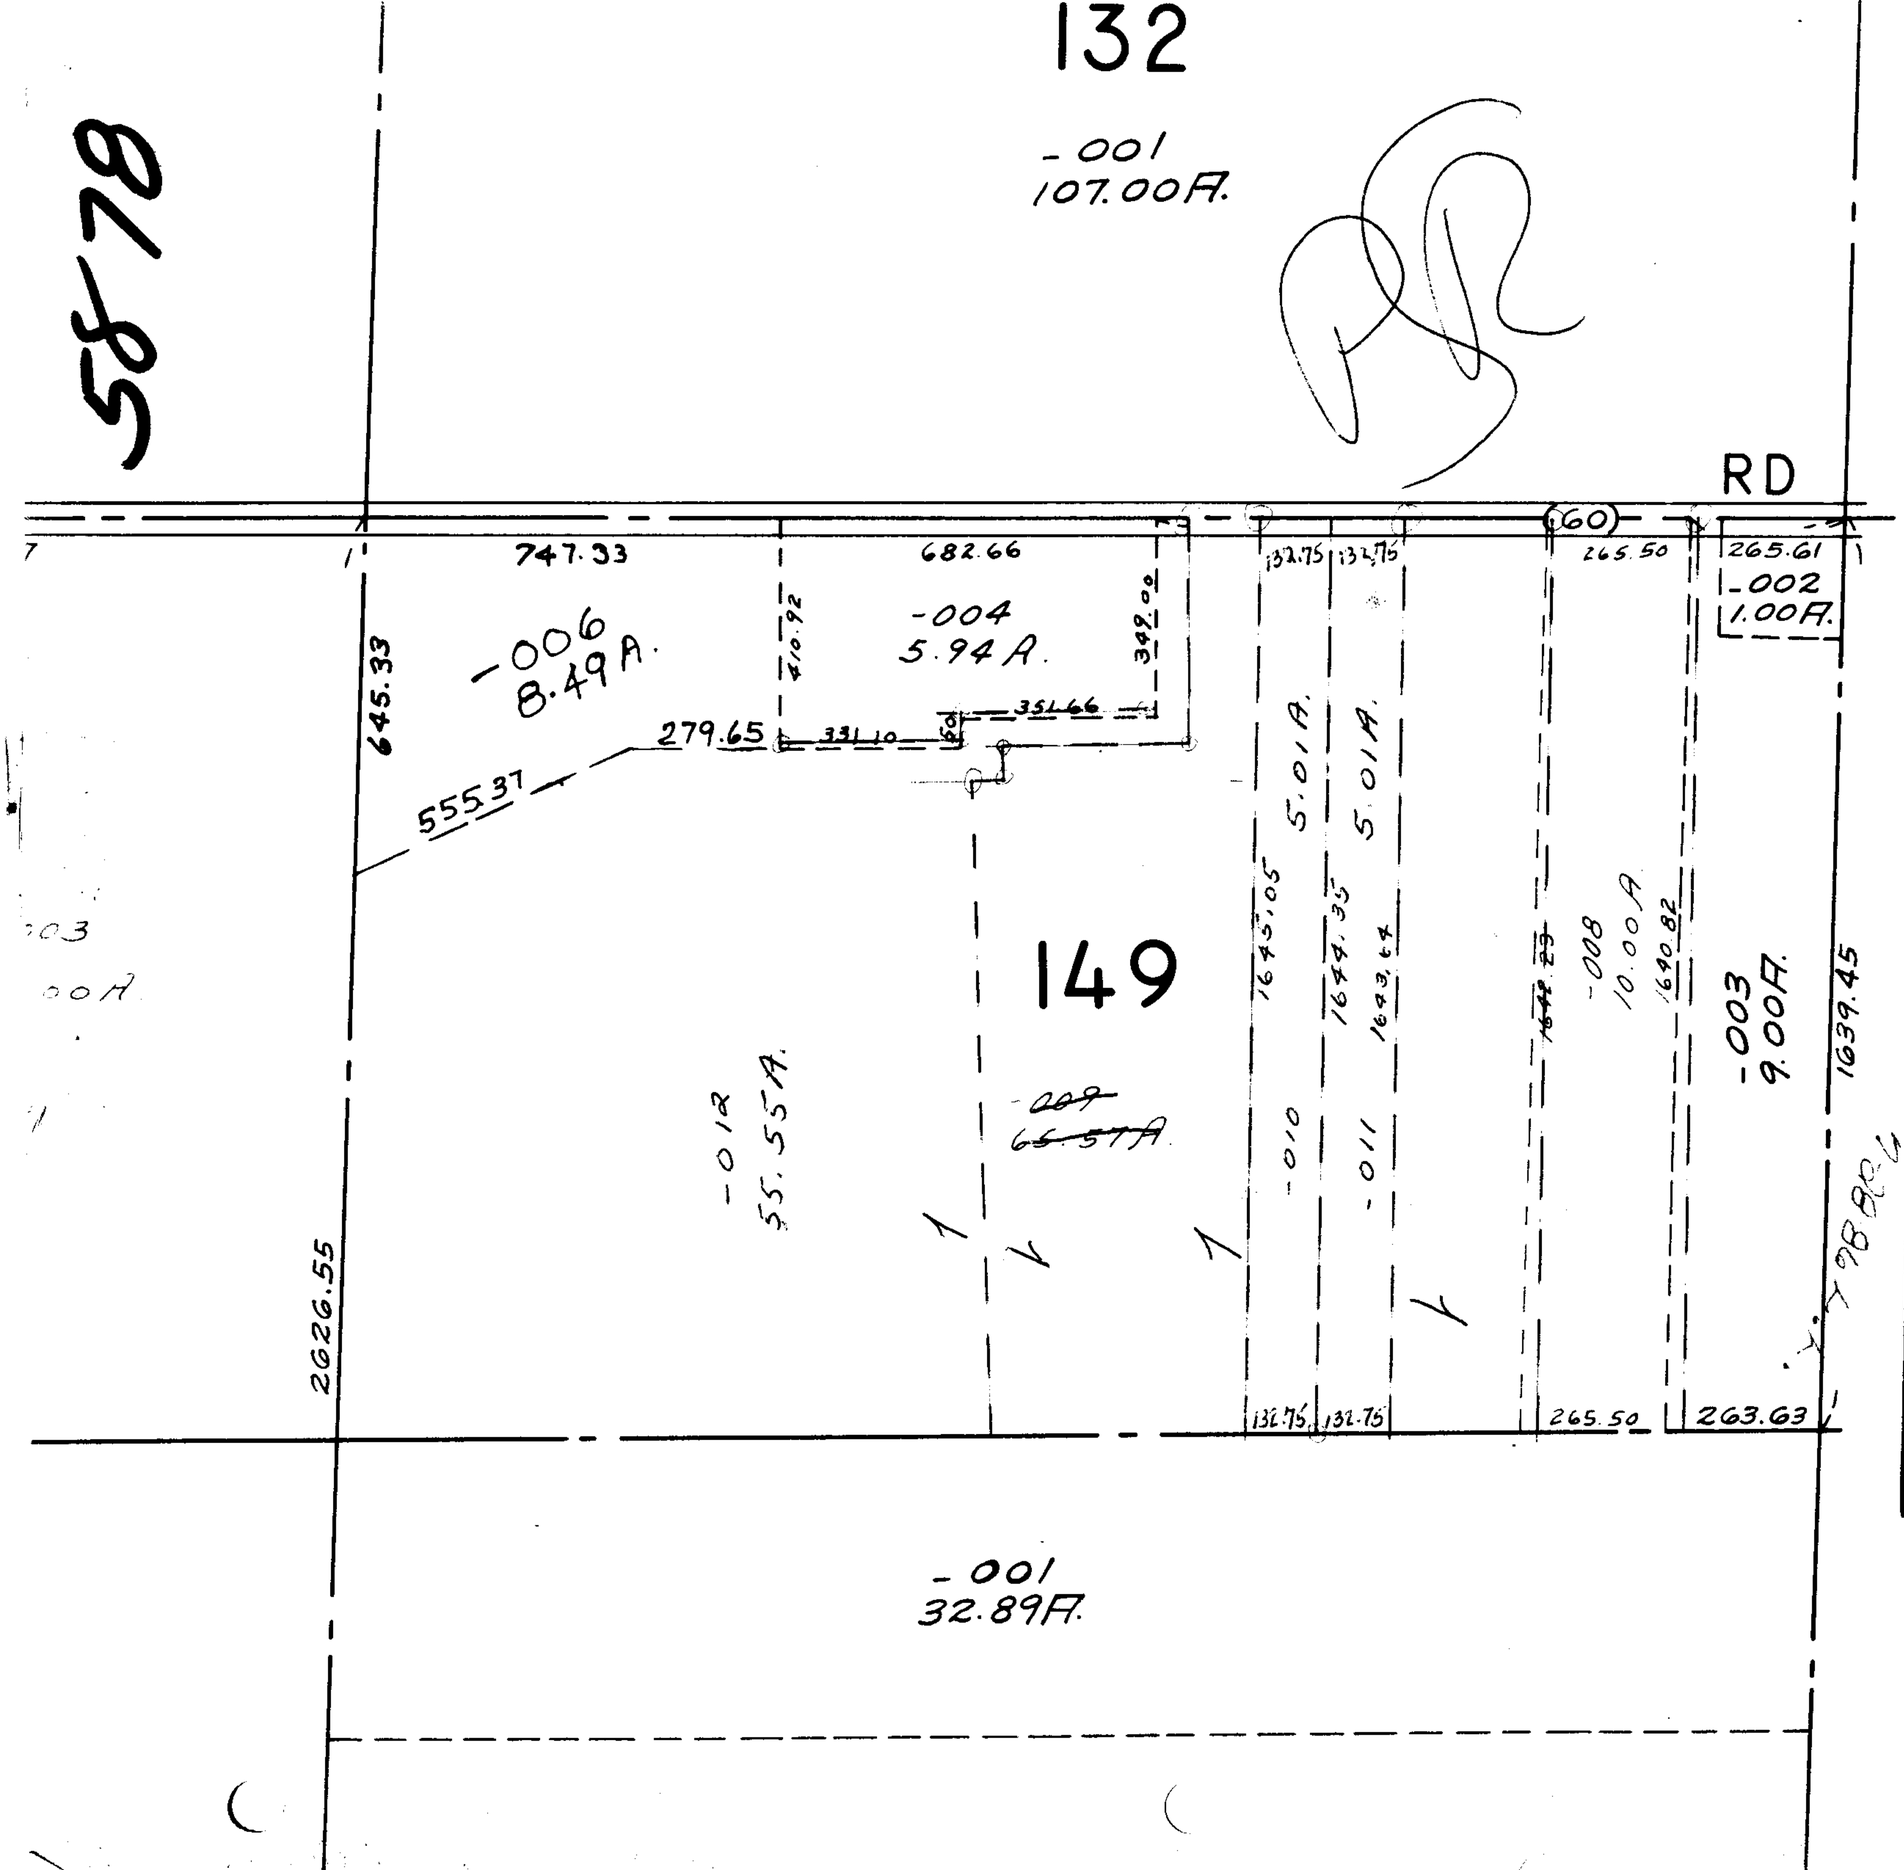

5878

APPROVED
LORAIN CO.
MAP DEPT.
DATE 5-9-72
14-E
BY