


5881

Reference To # 5881
Combination

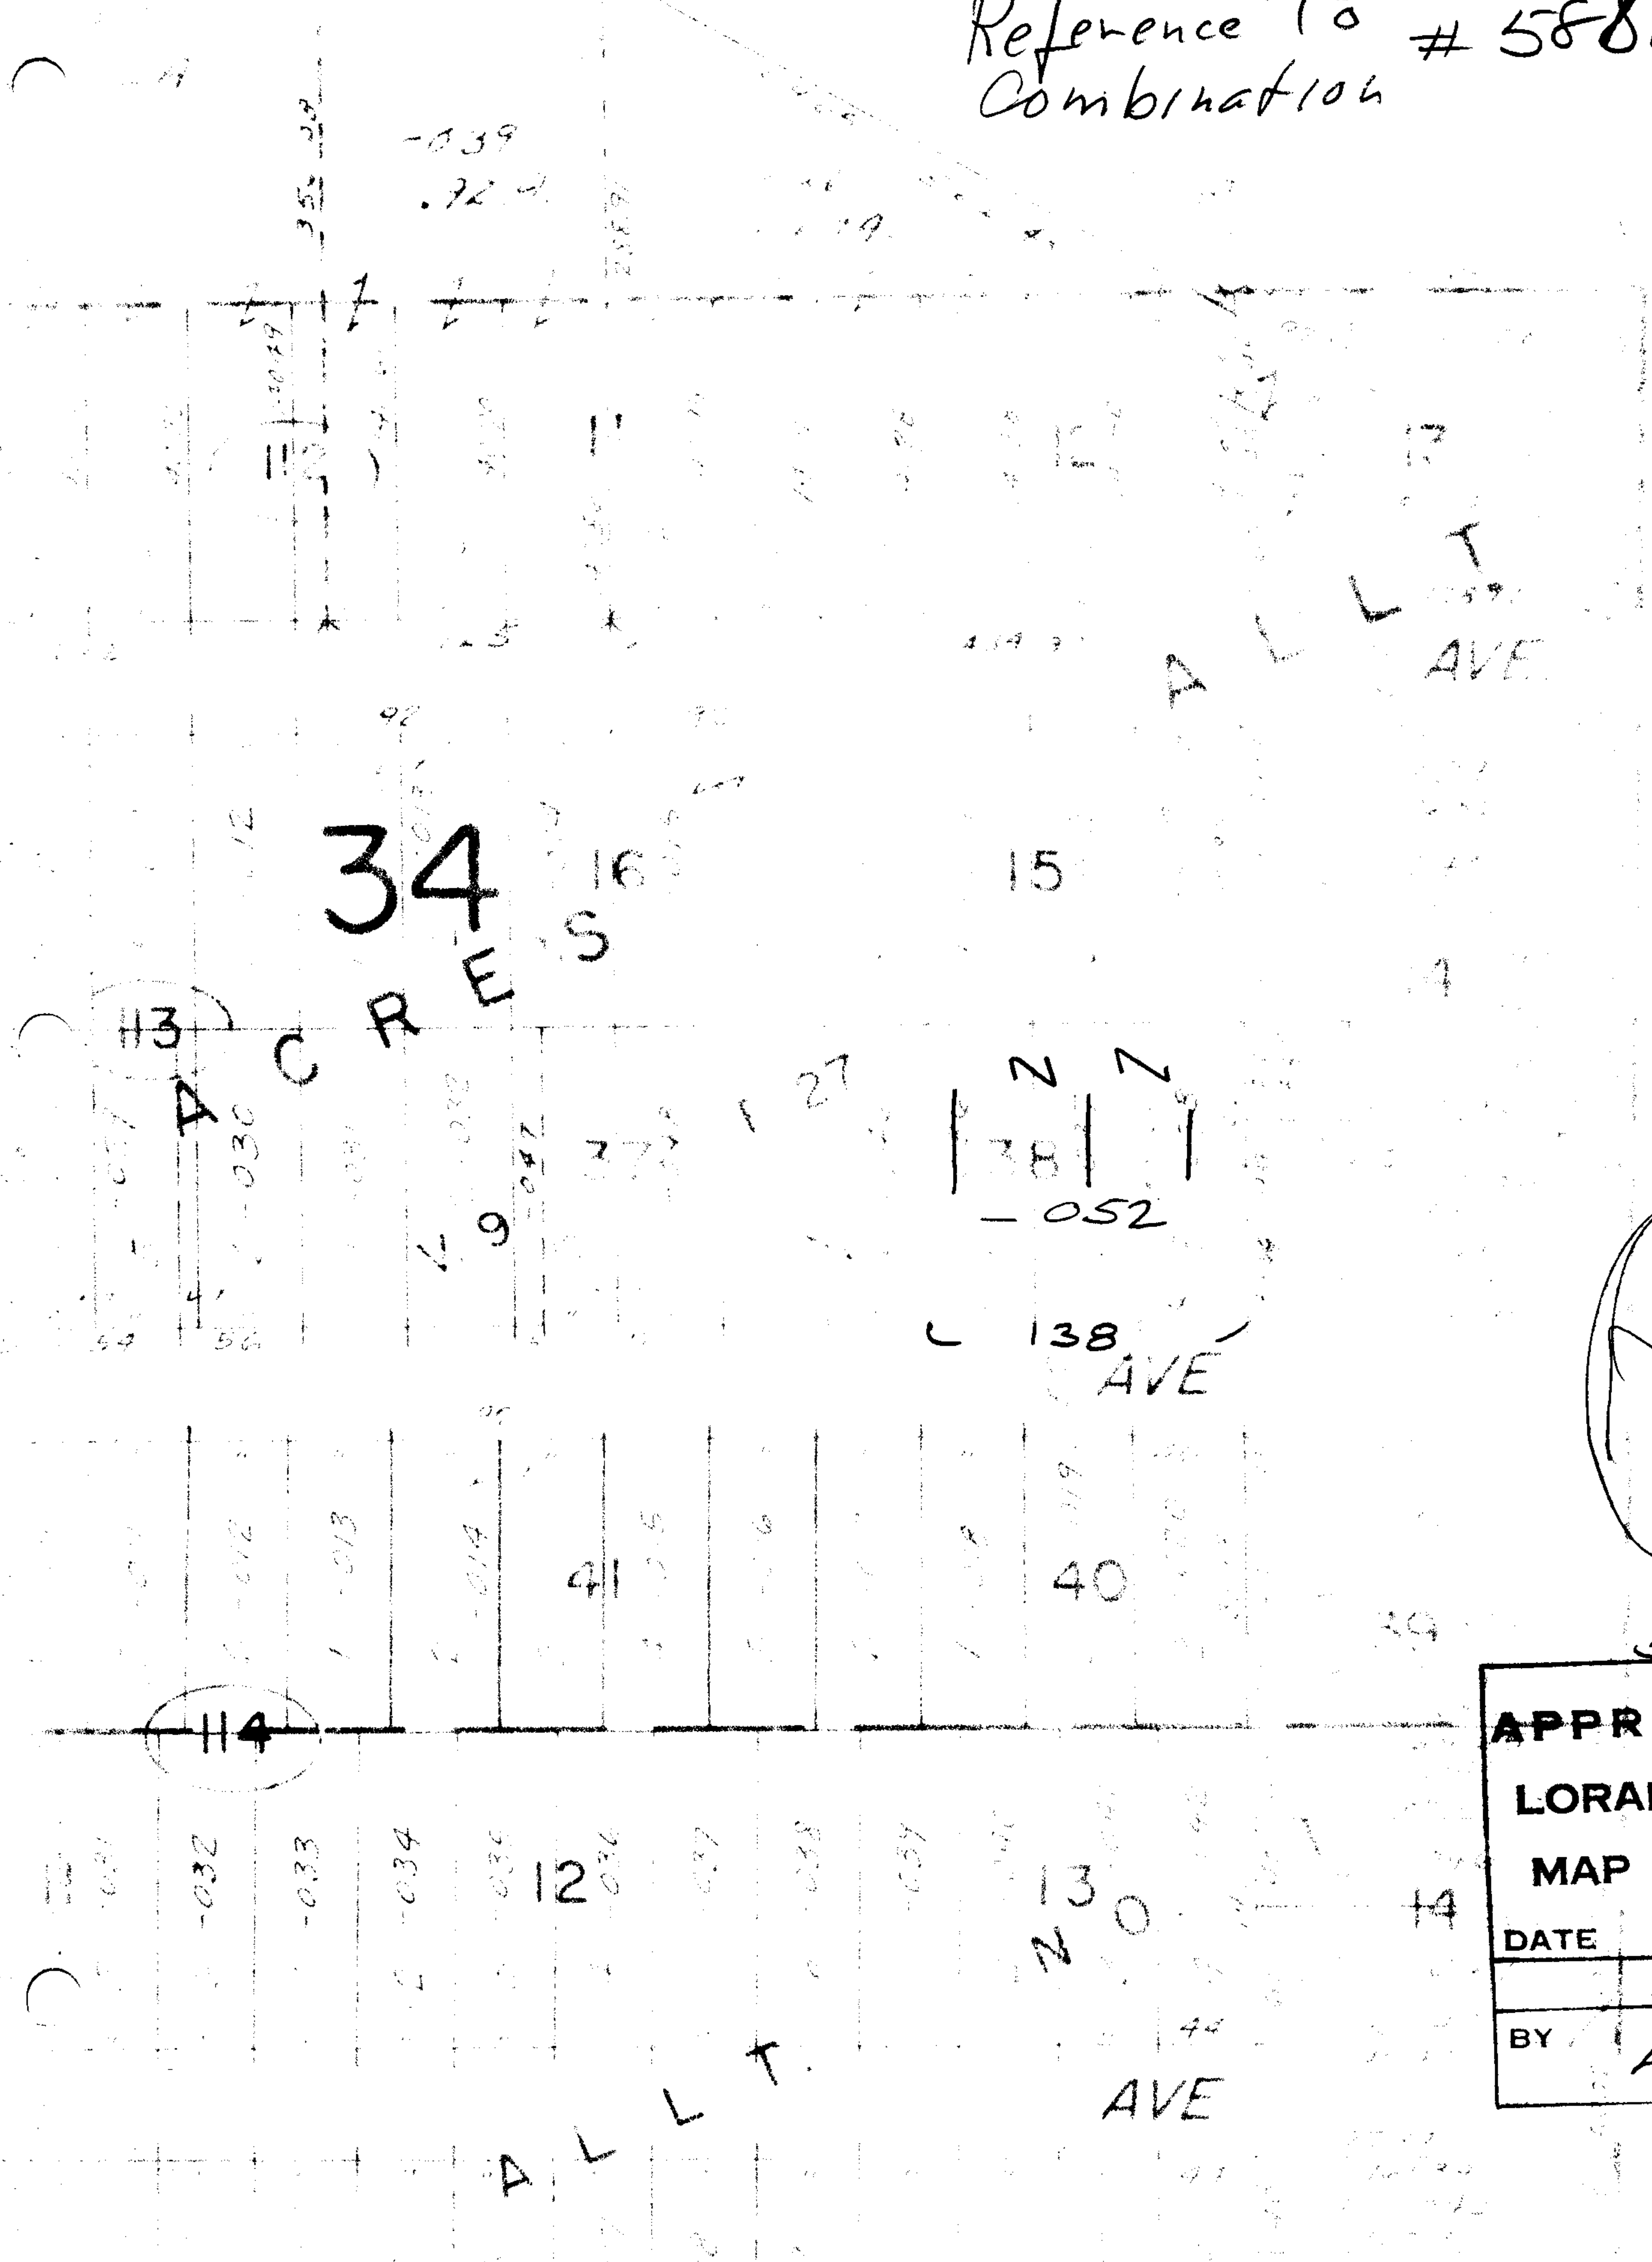

(Signature)

5881

APPROVED	
LORAIN CO.	
MAP DEPT.	
DATE	5-30-72
	6-63
BY	LW Hak