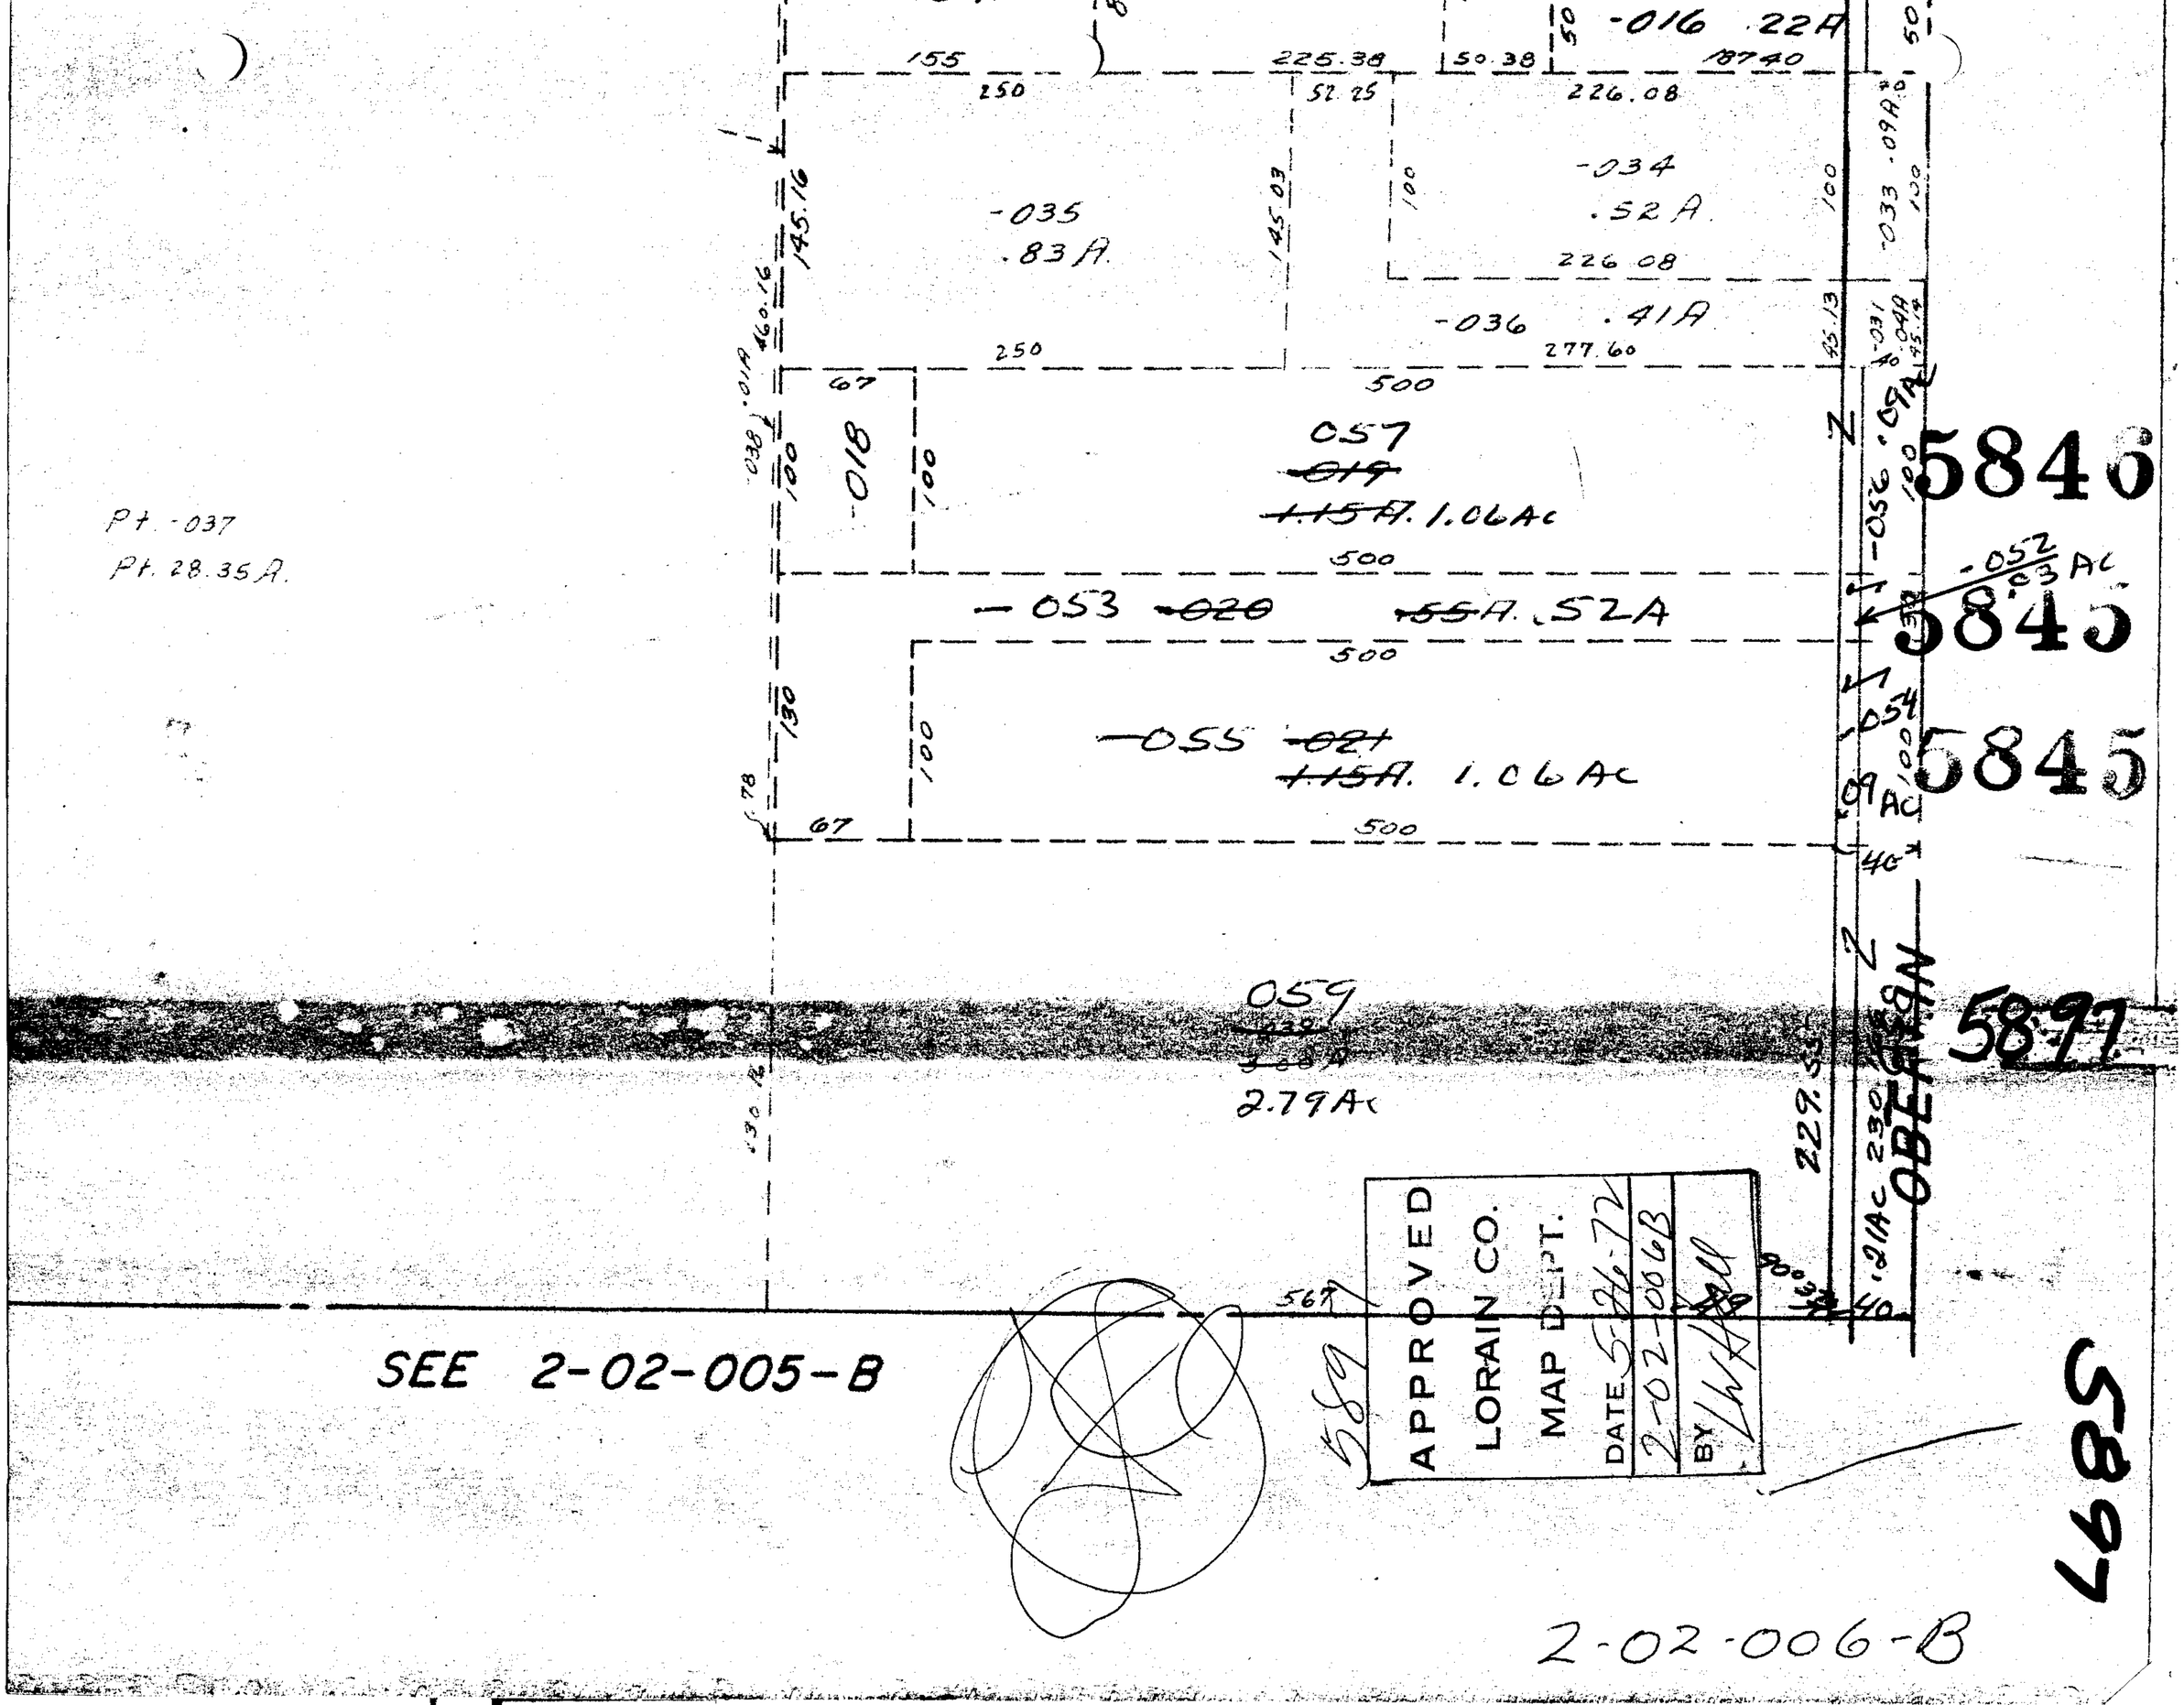

-016 .22A
155
225.38
50.38
187.40
250
52.25
226.08
-035
.83A
145.16
145.03
-034
.52A
226.08
-036 .41A
277.60
250
500
-018
057
~~019~~
~~1.15A~~ 1.06Ac
500
-053 ~~020~~ ~~.55A~~ .52A
500
-055 ~~021~~
~~1.15A~~ 1.06Ac
500
Pt. -037
Pt. 28.35A.
5846
5845
5845
-052 .03Ac
-054 .09Ac
-056 .09Ac
-033 .09A
059
2.79Ac
5897
OBERLIN
229.55
230
.21Ac
567
589
APPROVED
LORAIN CO.
MAP DEPT.
DATE 5-26-72
2-02-006B
BY
SEE 2-02-005-B
5897
2-02-006-B