


5906

SEE 11-00-099-B

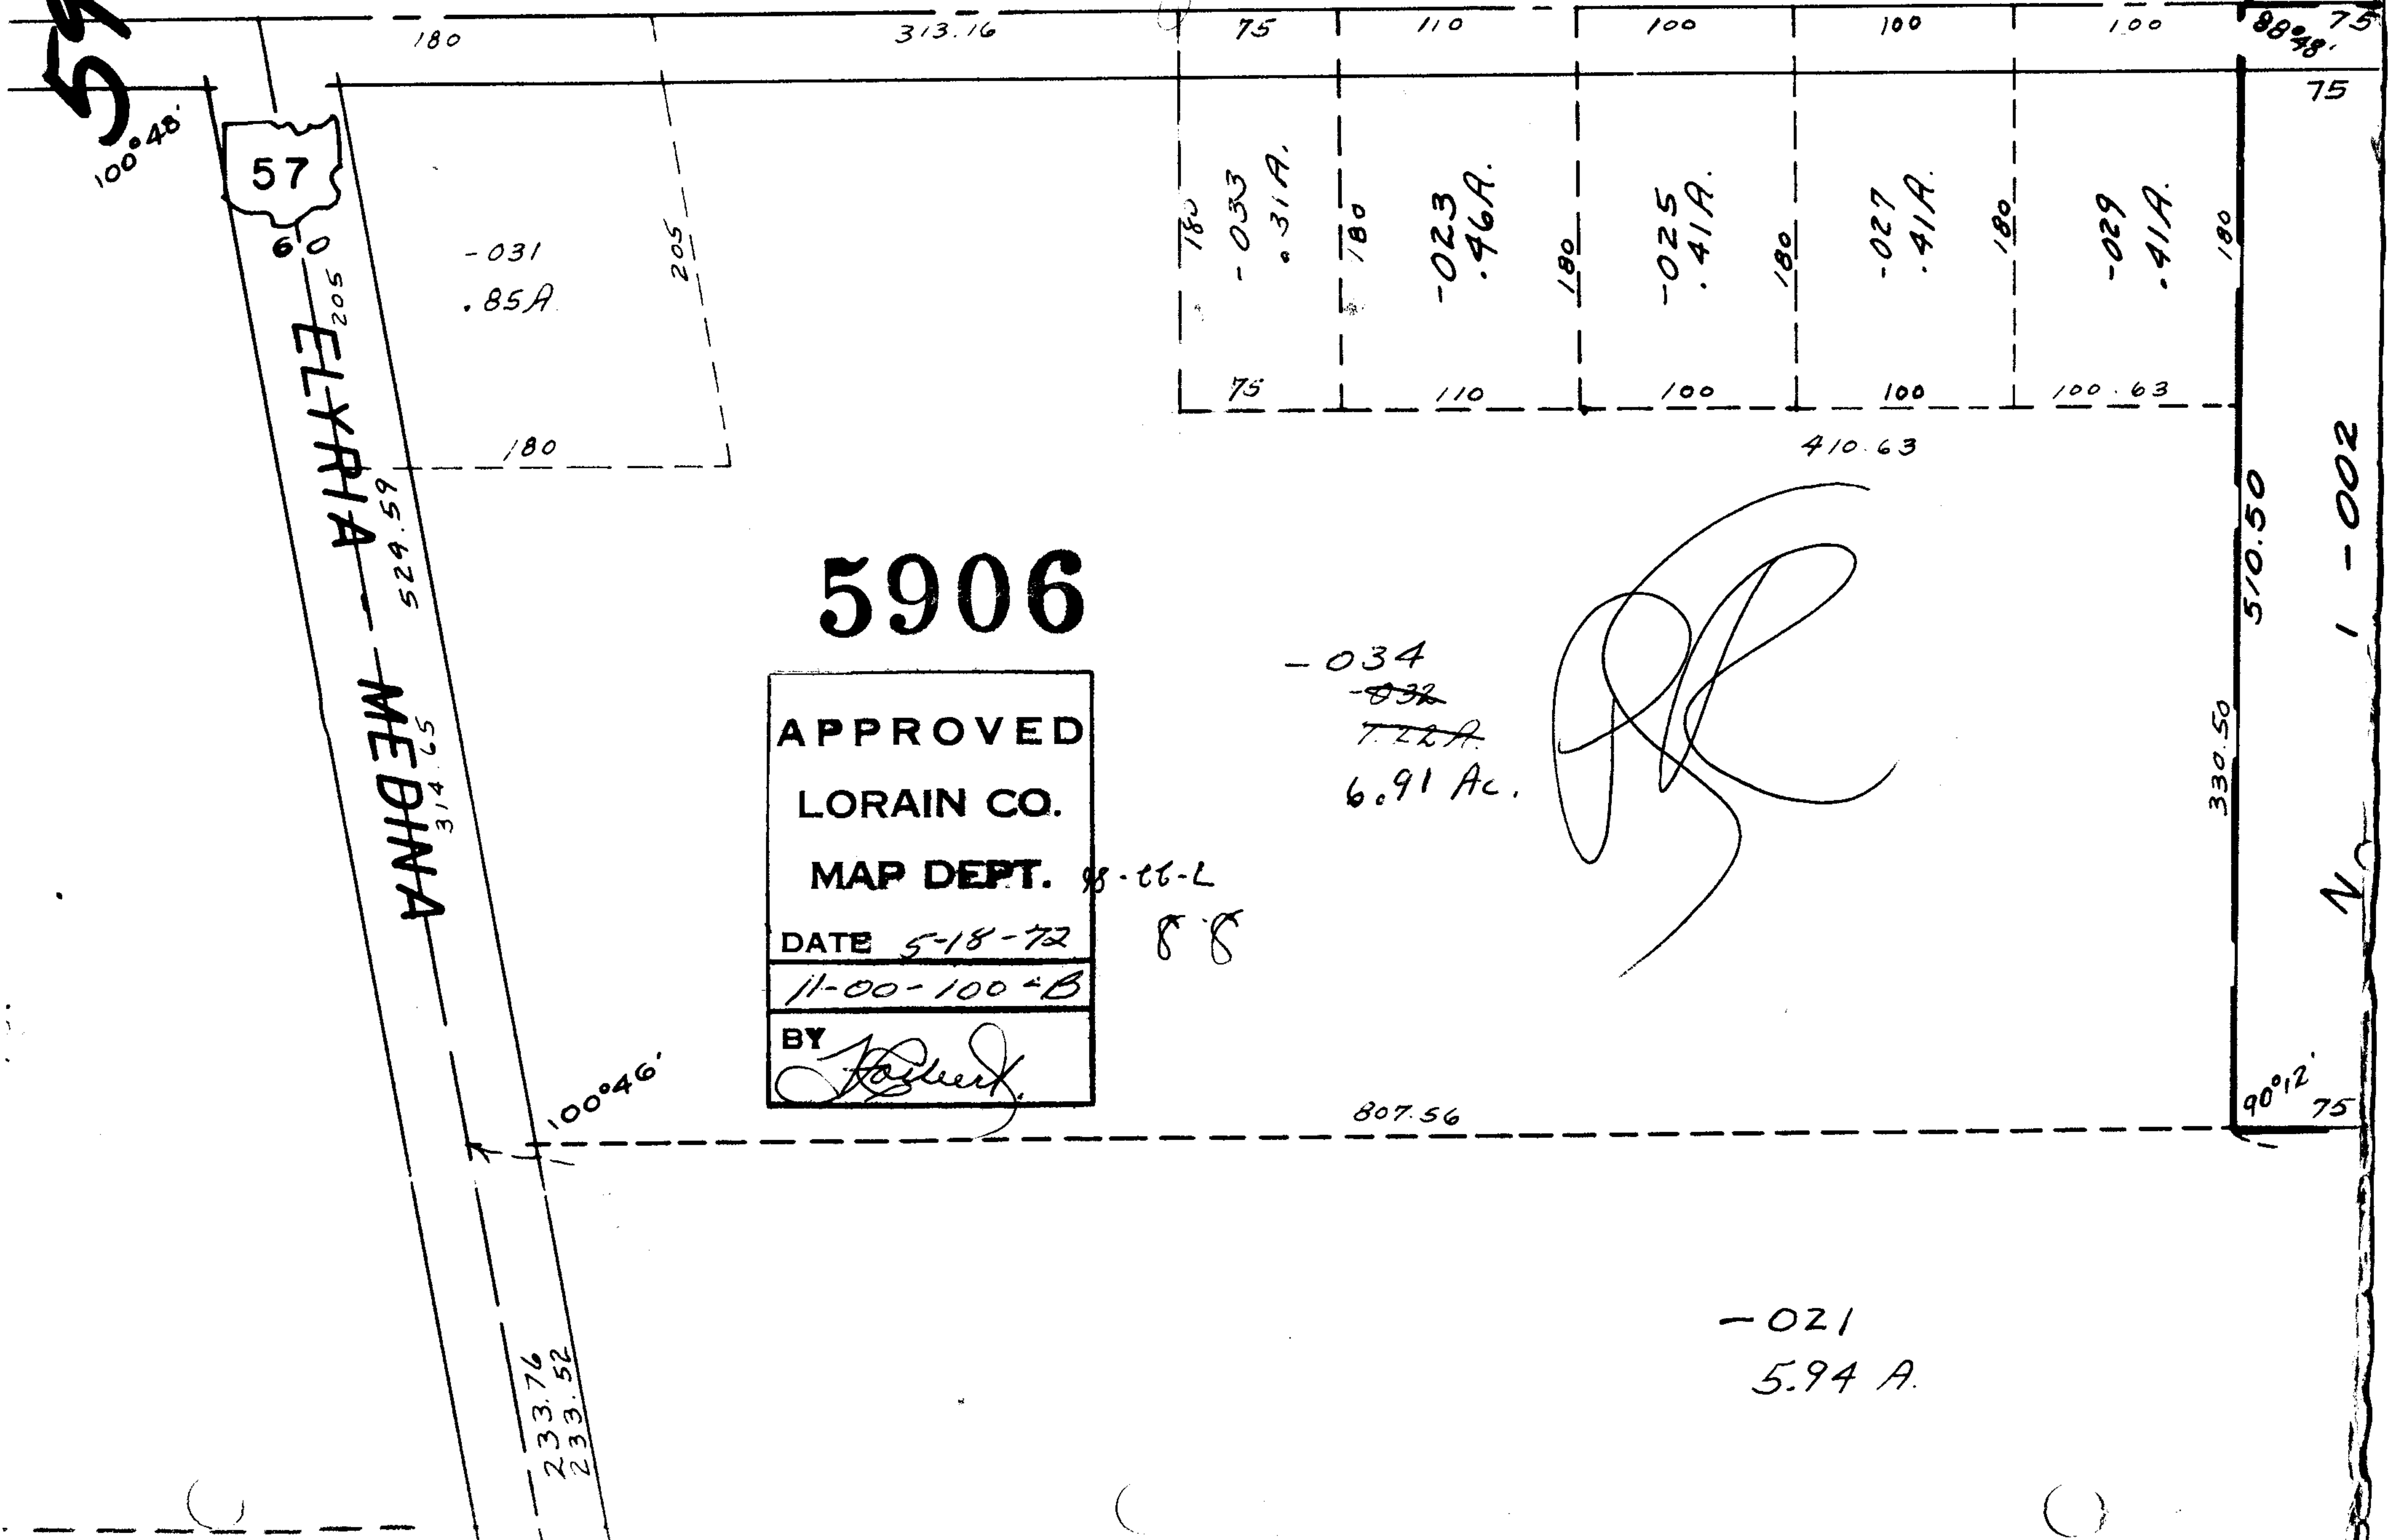

180

313.16

75

110

100

100

100

88°48' 75

75

-031  
.85 A.

205

180

-033  
.31 A.

180

-023  
.46 A.

180

-025  
.41 A.

180

-027  
.41 A.

180

-029  
.41 A.

180

75

110

100

100

100.63

410.63

180

5906

APPROVED  
LORAIN CO.  
MAP DEPT.

DATE 5-18-72

11-00-100-B

BY [Signature]

-034  
~~-032~~  
7.22 A.  
6.91 Ac.

[Signature]

88-66-L

8'8"

807.56

510.50

330.50

No 1-002

90°12' 75

233.76  
233.52

-021  
5.94 A.

57

60  
205

ELXRIA

529.59

MEDINA  
314.65

100°46'

100°48'