


5910

675
25
39975-413-917AC

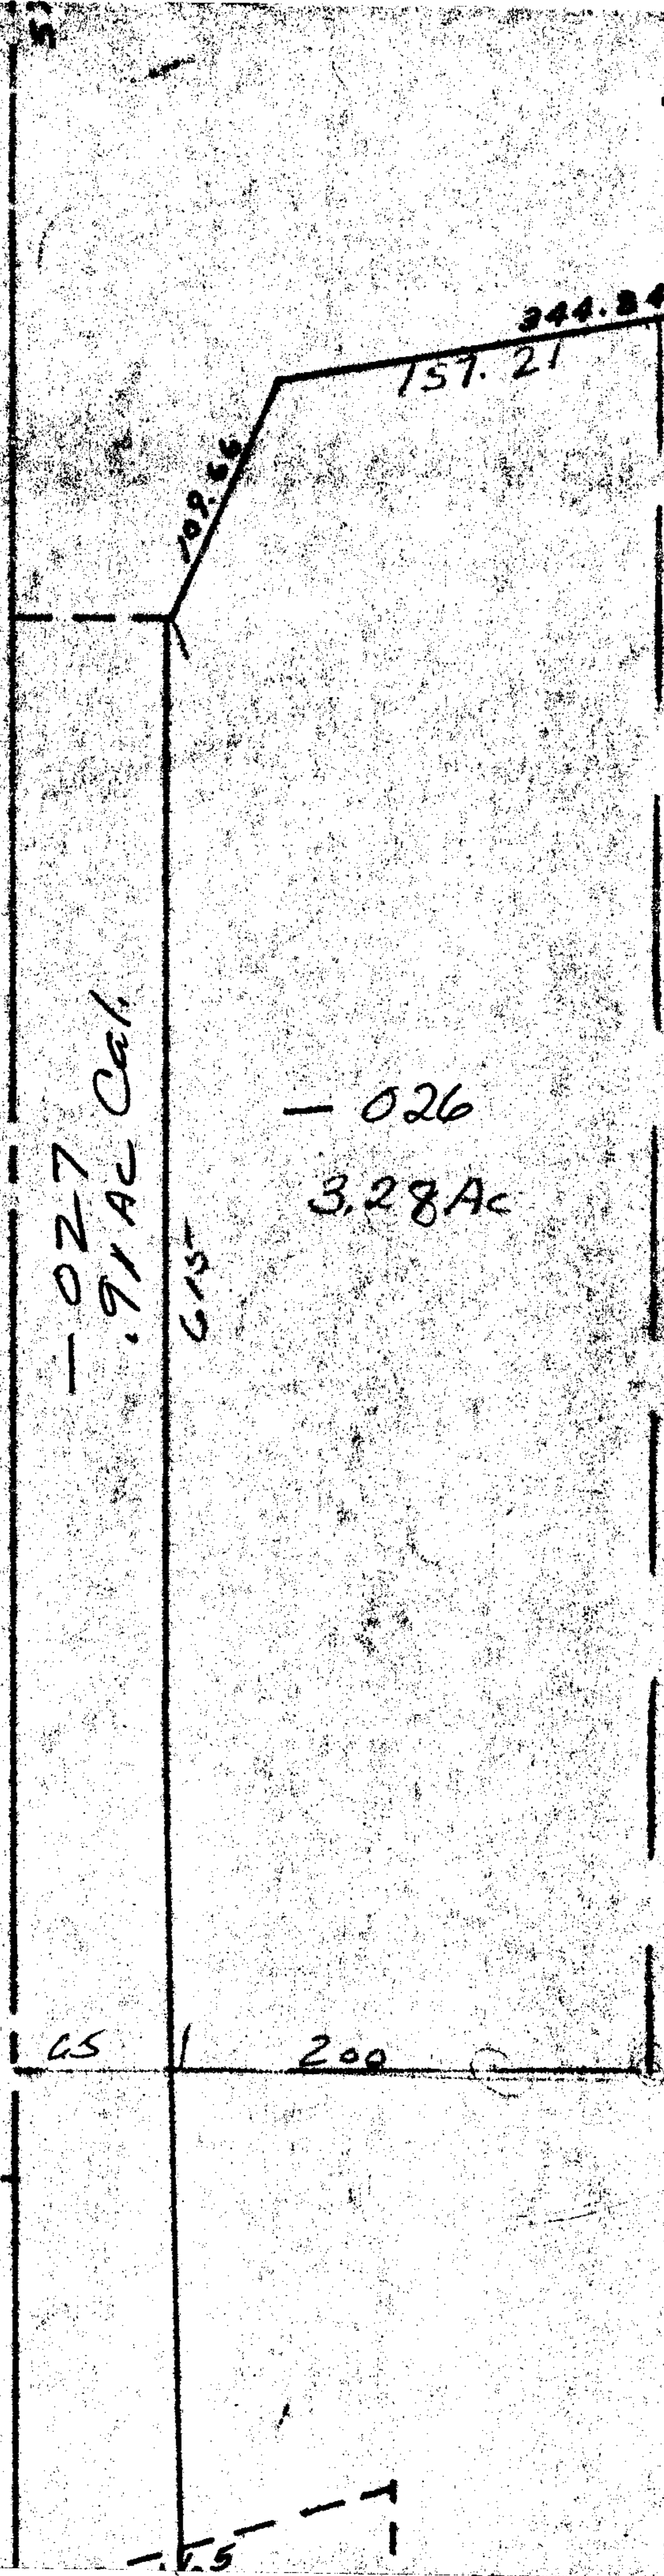

See Also
1-00-028A

PT 0.25
~~PT 0.19~~
~~PT 77.11 AC~~
~~PT 73.83 AC~~
7282

See
Also
1-00-026B

1-00-026A

7-21-80
SS

5910

APPROV
LORAIN
MAP DEPT.
DATE 5-19-72
1-00-026A
BY 026B
033A
L. W. Hall

SEE 1-00-027-B