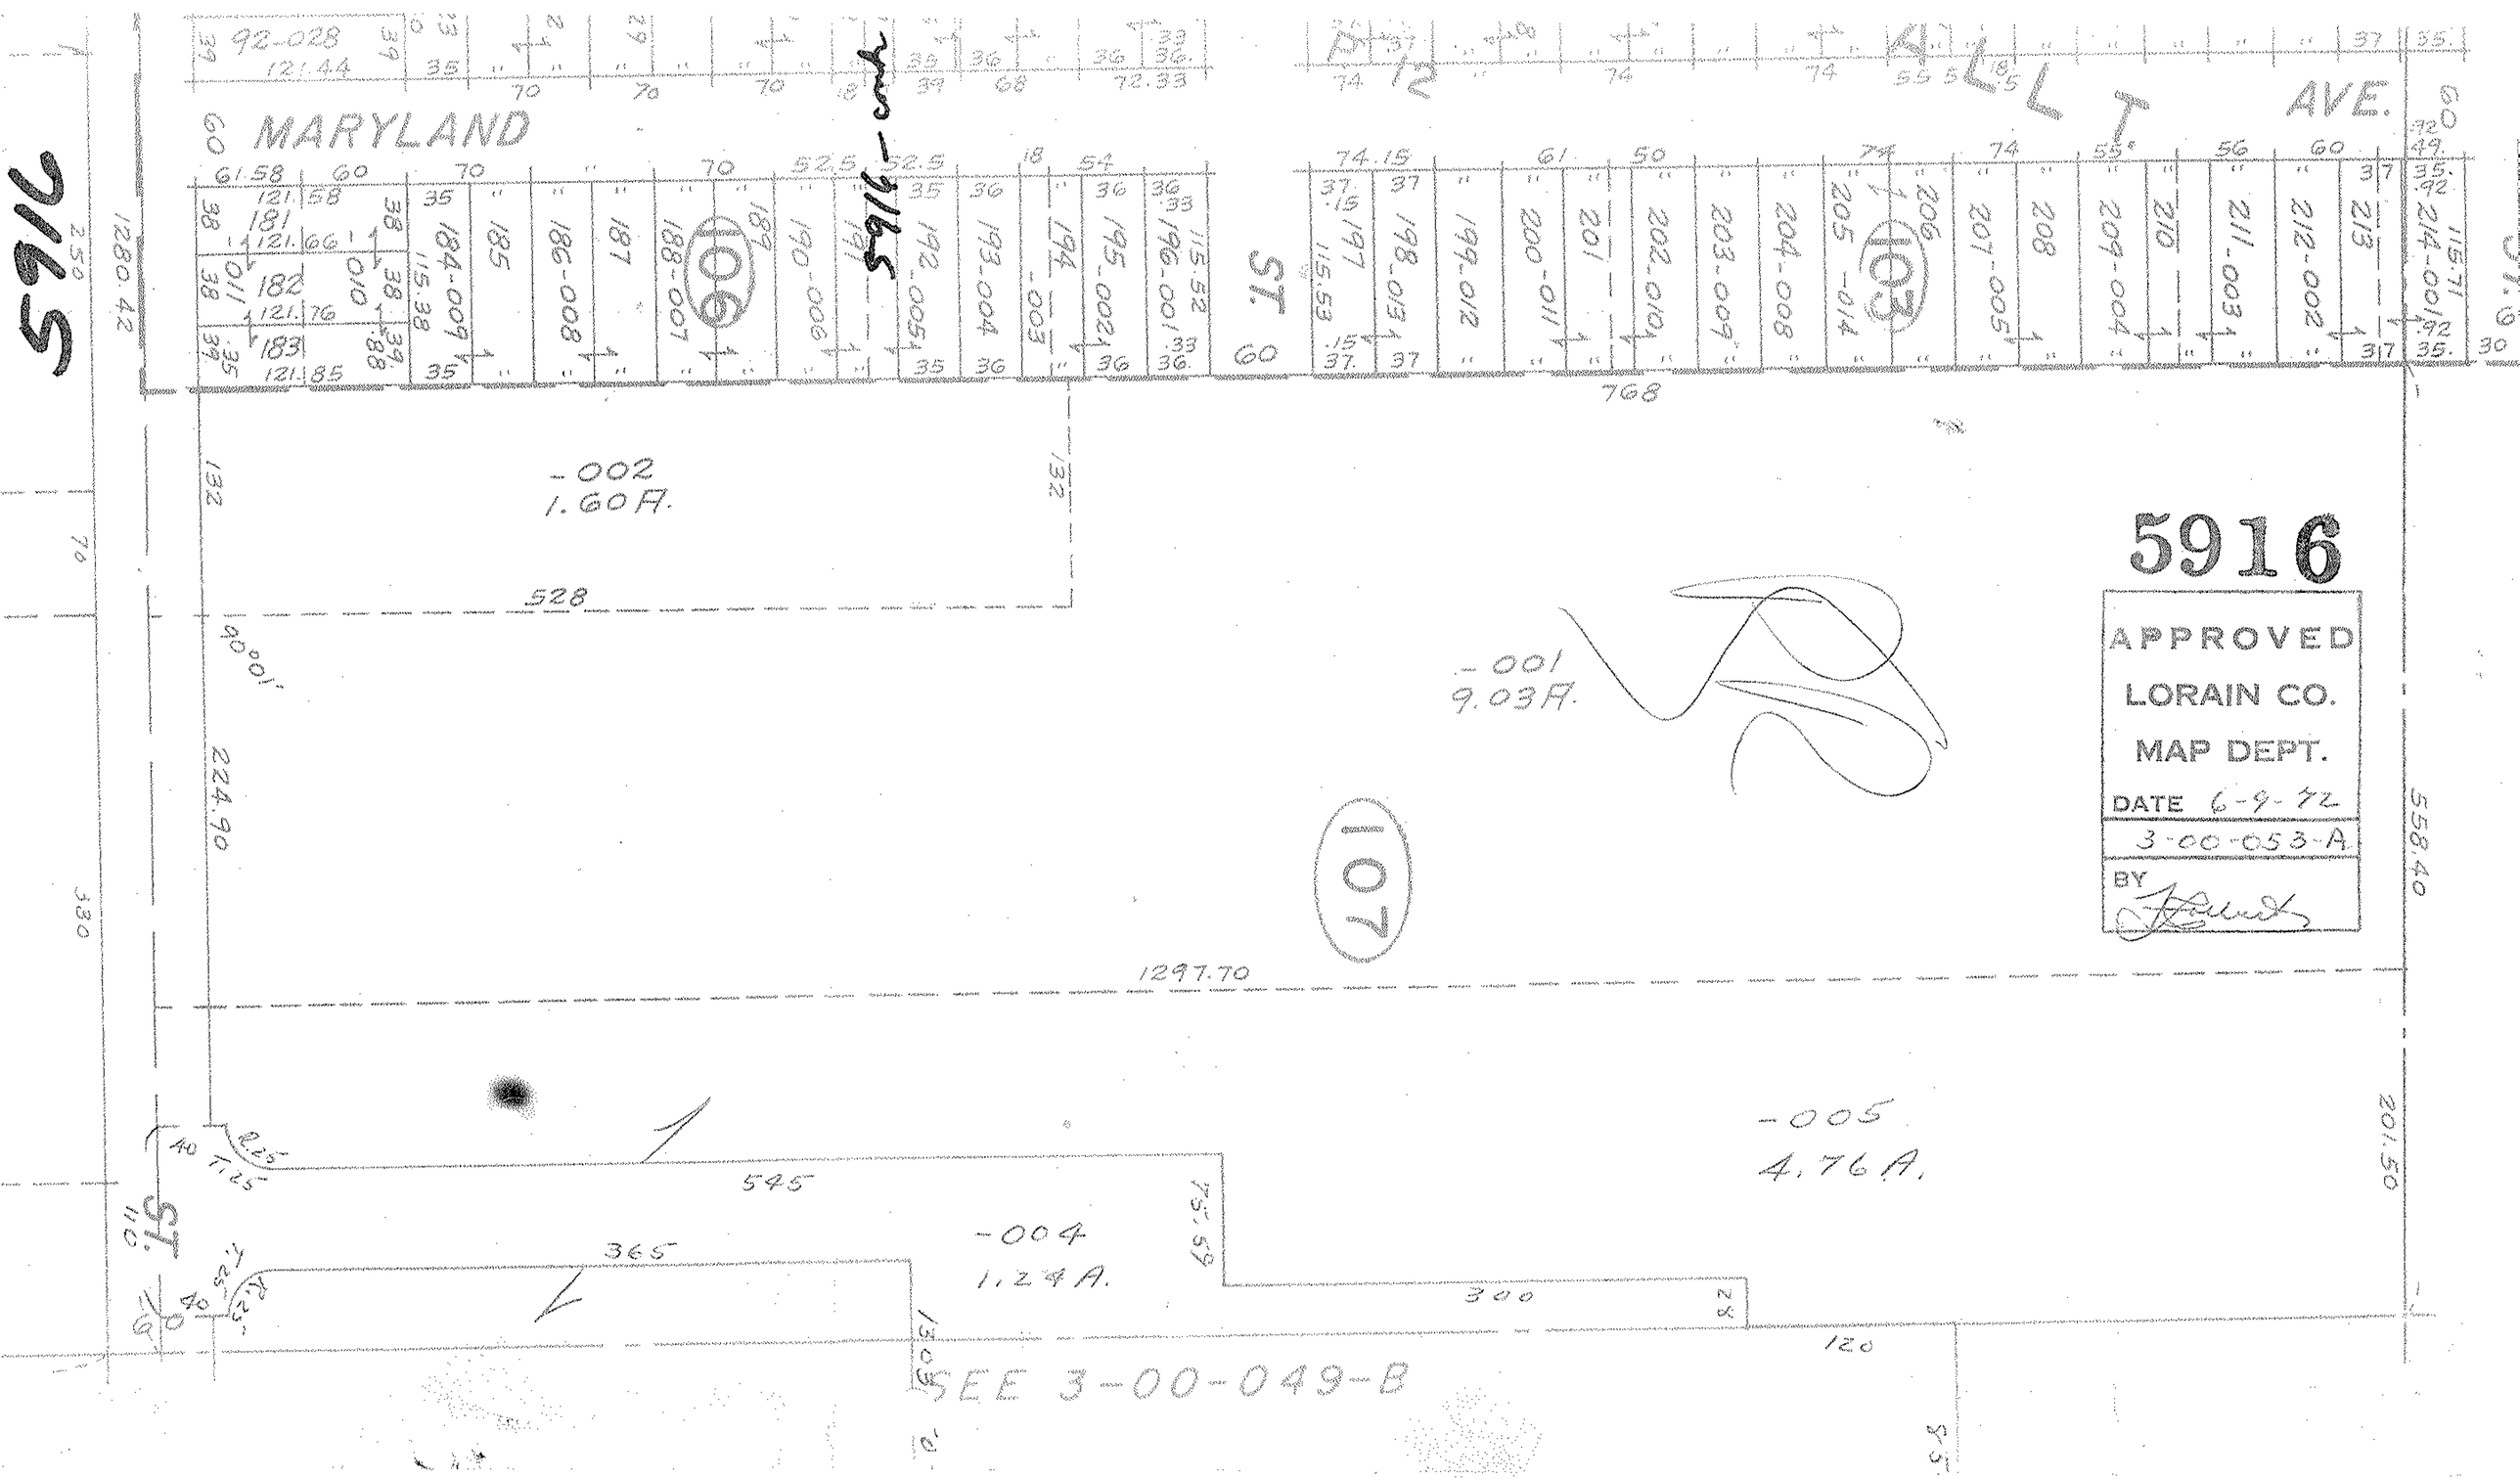

5916
MARYLAND
ALLT. AVE.
ST.
106
103
107
-002
1.60 A.
-001
9.03 A.
-005
4.76 A.
-004
1.24 A.
1297.70
1280.42
558.40
201.50
224.90
528
768
545
365
300
120
SEE 3-00-049-B
APPROVED
LORAIN CO.
MAP DEPT.
DATE 6-9-72
3-00-053-A
BY