


N 18° 54' W
343.50

5923

105

APPROVED
LORAIN CO.
MAP DEPT.
DATE 7/25/72
BY *R. Helling*

7-21-86 L.L.

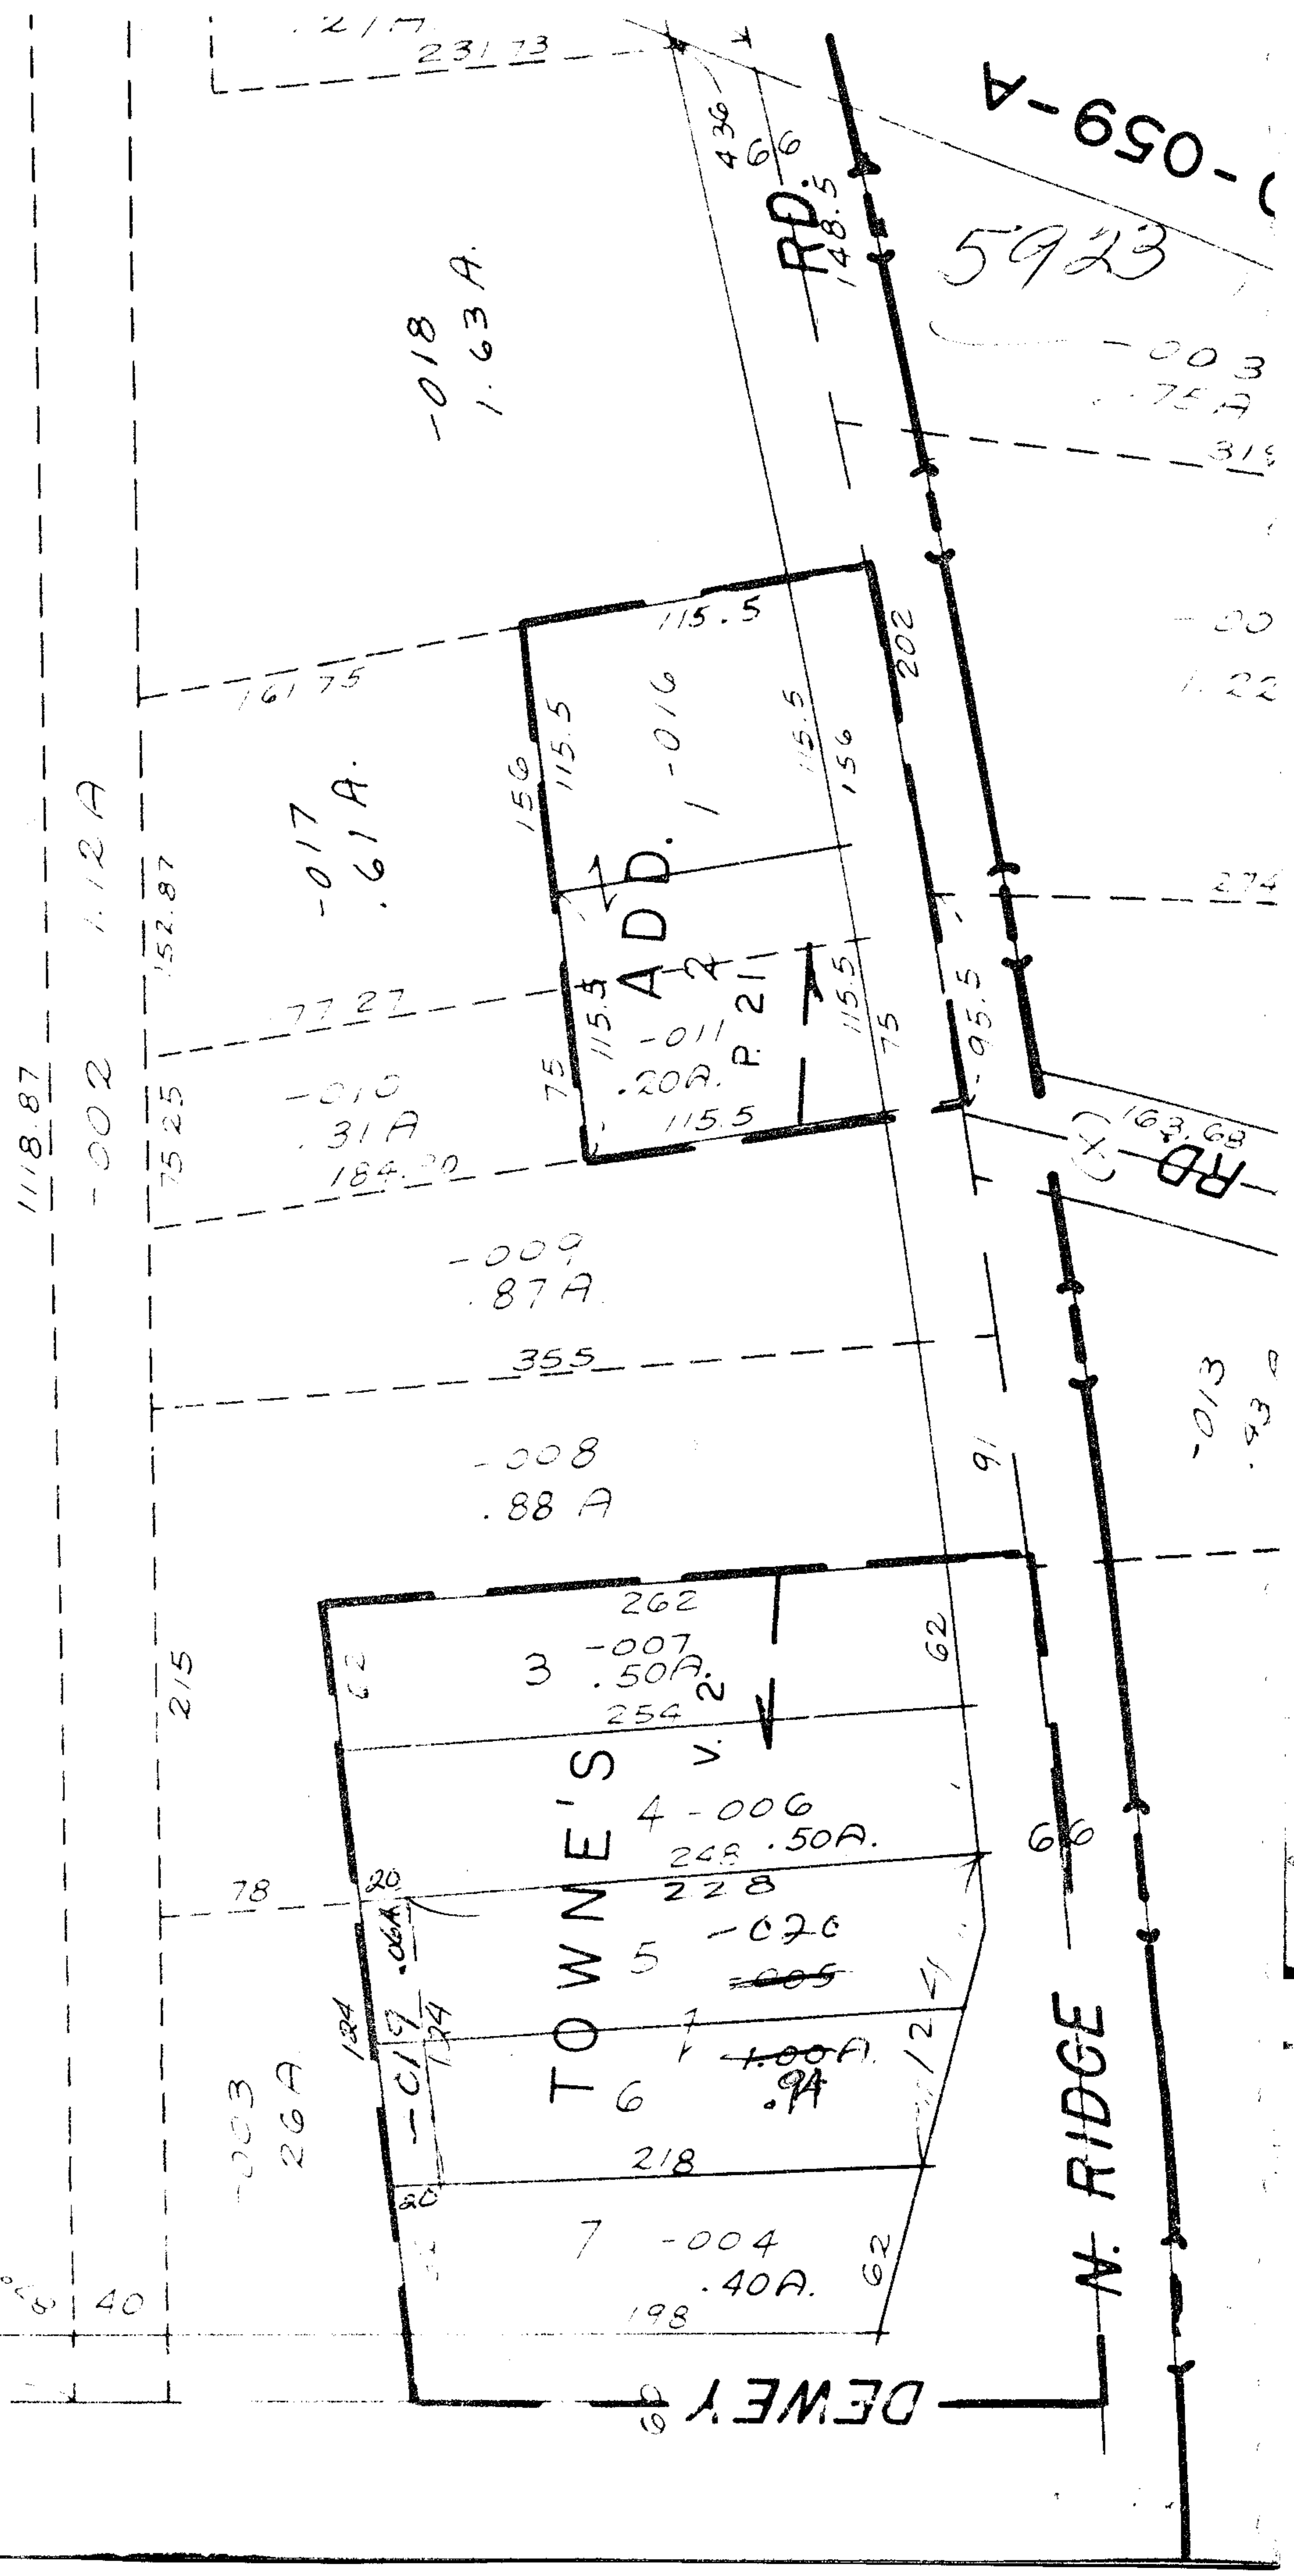

5923

5923

N. RIDGE

DEWEY