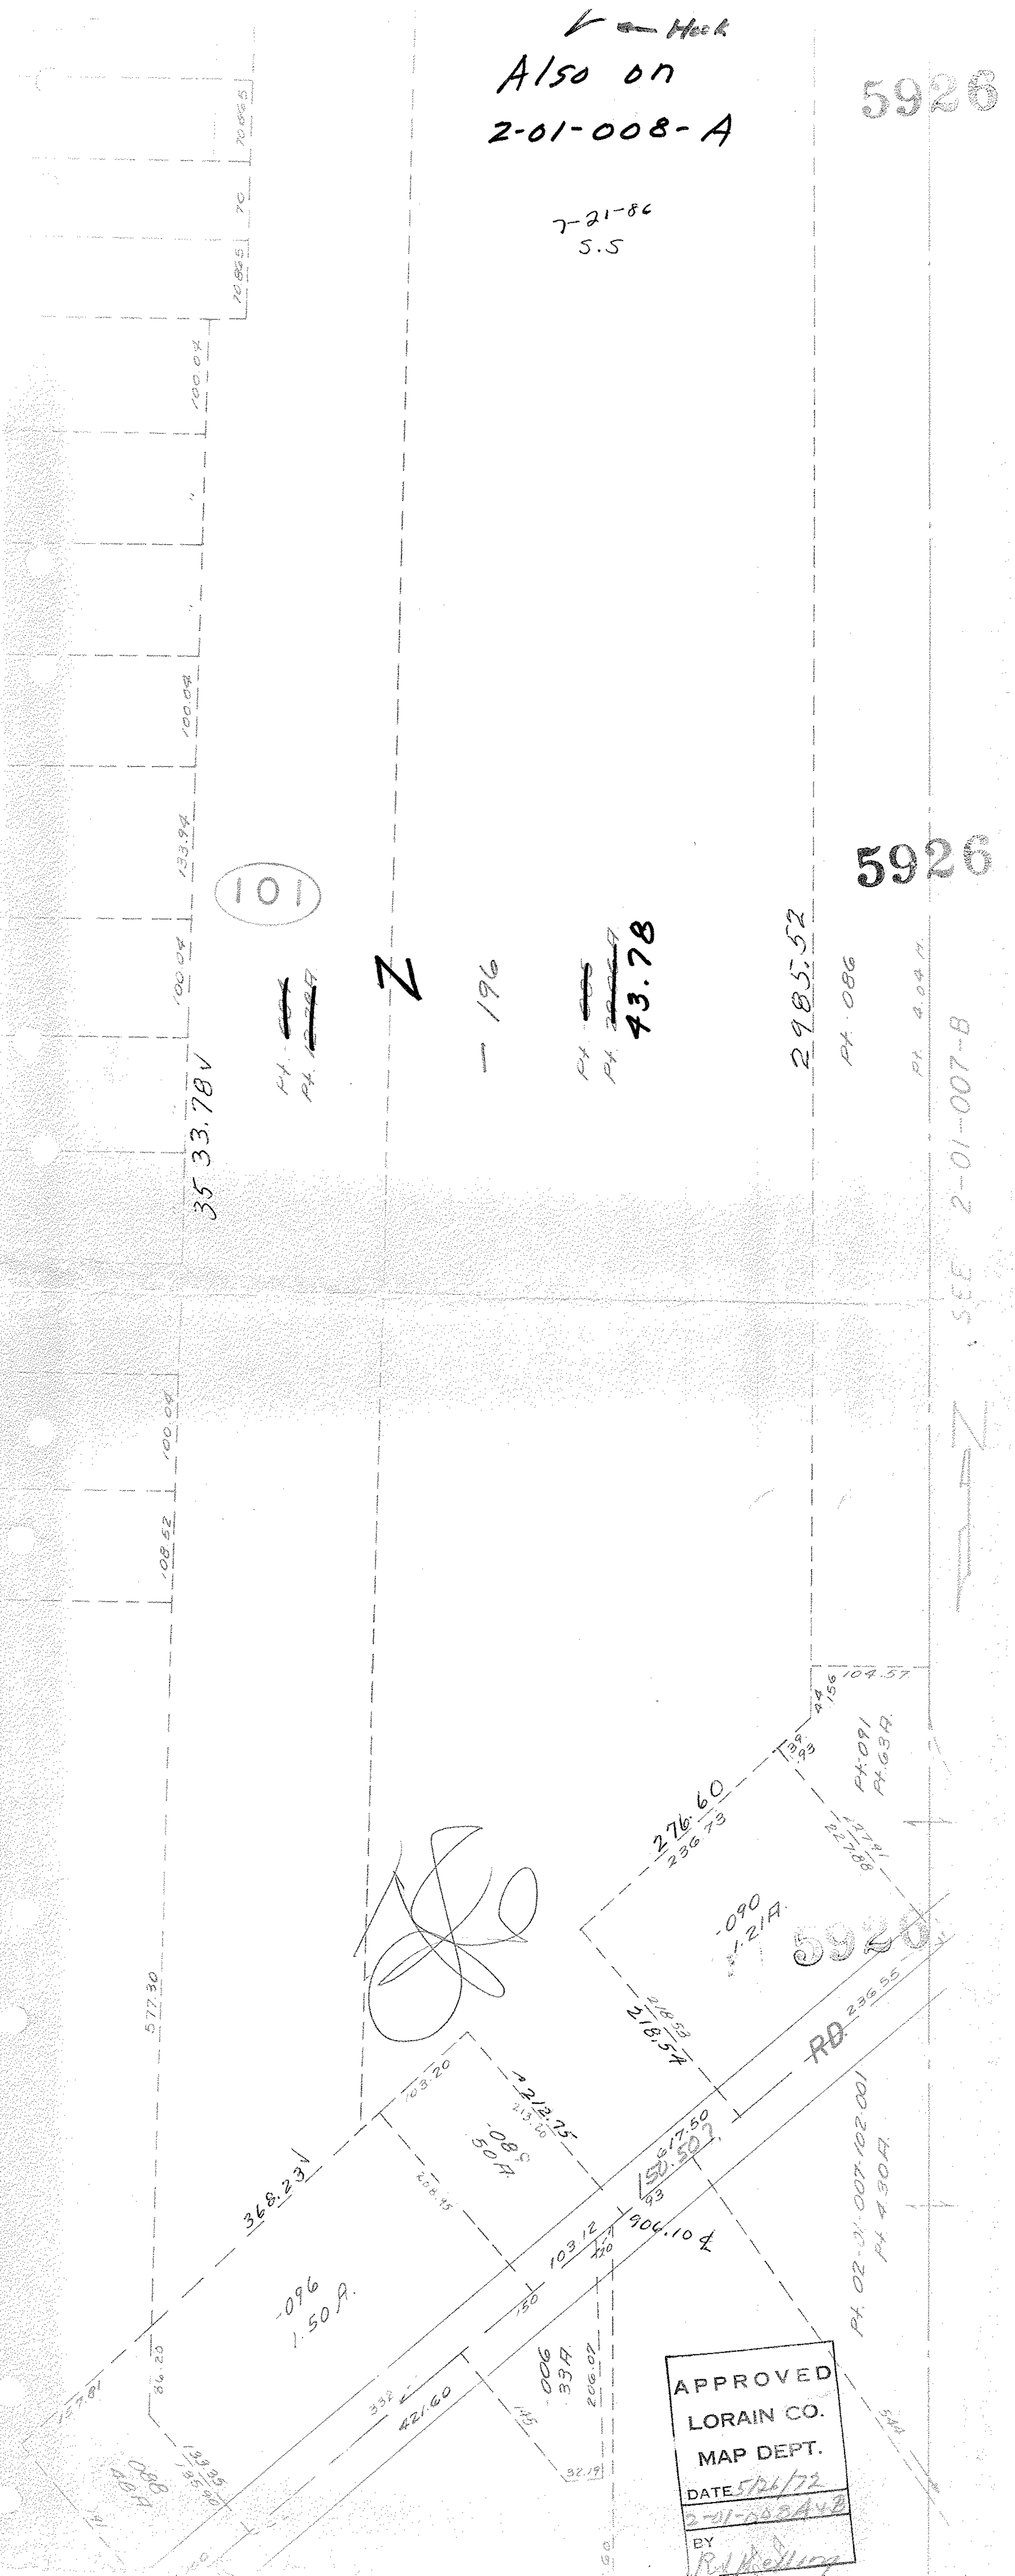

Hook
Also on
2-01-008-A
7-21-86
S.S
5926
5926
101
Z
-196
43.78
2985.52
Pt. 086
Pt. 4.04 A.
SEE 2-01-007-B
35 33.78
100.04
133.94
108.52
577.30
104.57
276.60
236.73
-090
1.21A.
218.53
218.54
RD.
236.55
212.75
-089
50A.
368.23
-096
1.50A.
906.10
103.12
421.60
-006
33A.
206.07
Pt. 091
Pt. 63A.
Pt. 02-01-007-102.001
Pt. 4.30A.
APPROVED
LORAIN CO.
MAP DEPT.
DATE 5/26/72
2-01-008A&B
BY