


CTORY

EAGLE

LANE

LANE

5935

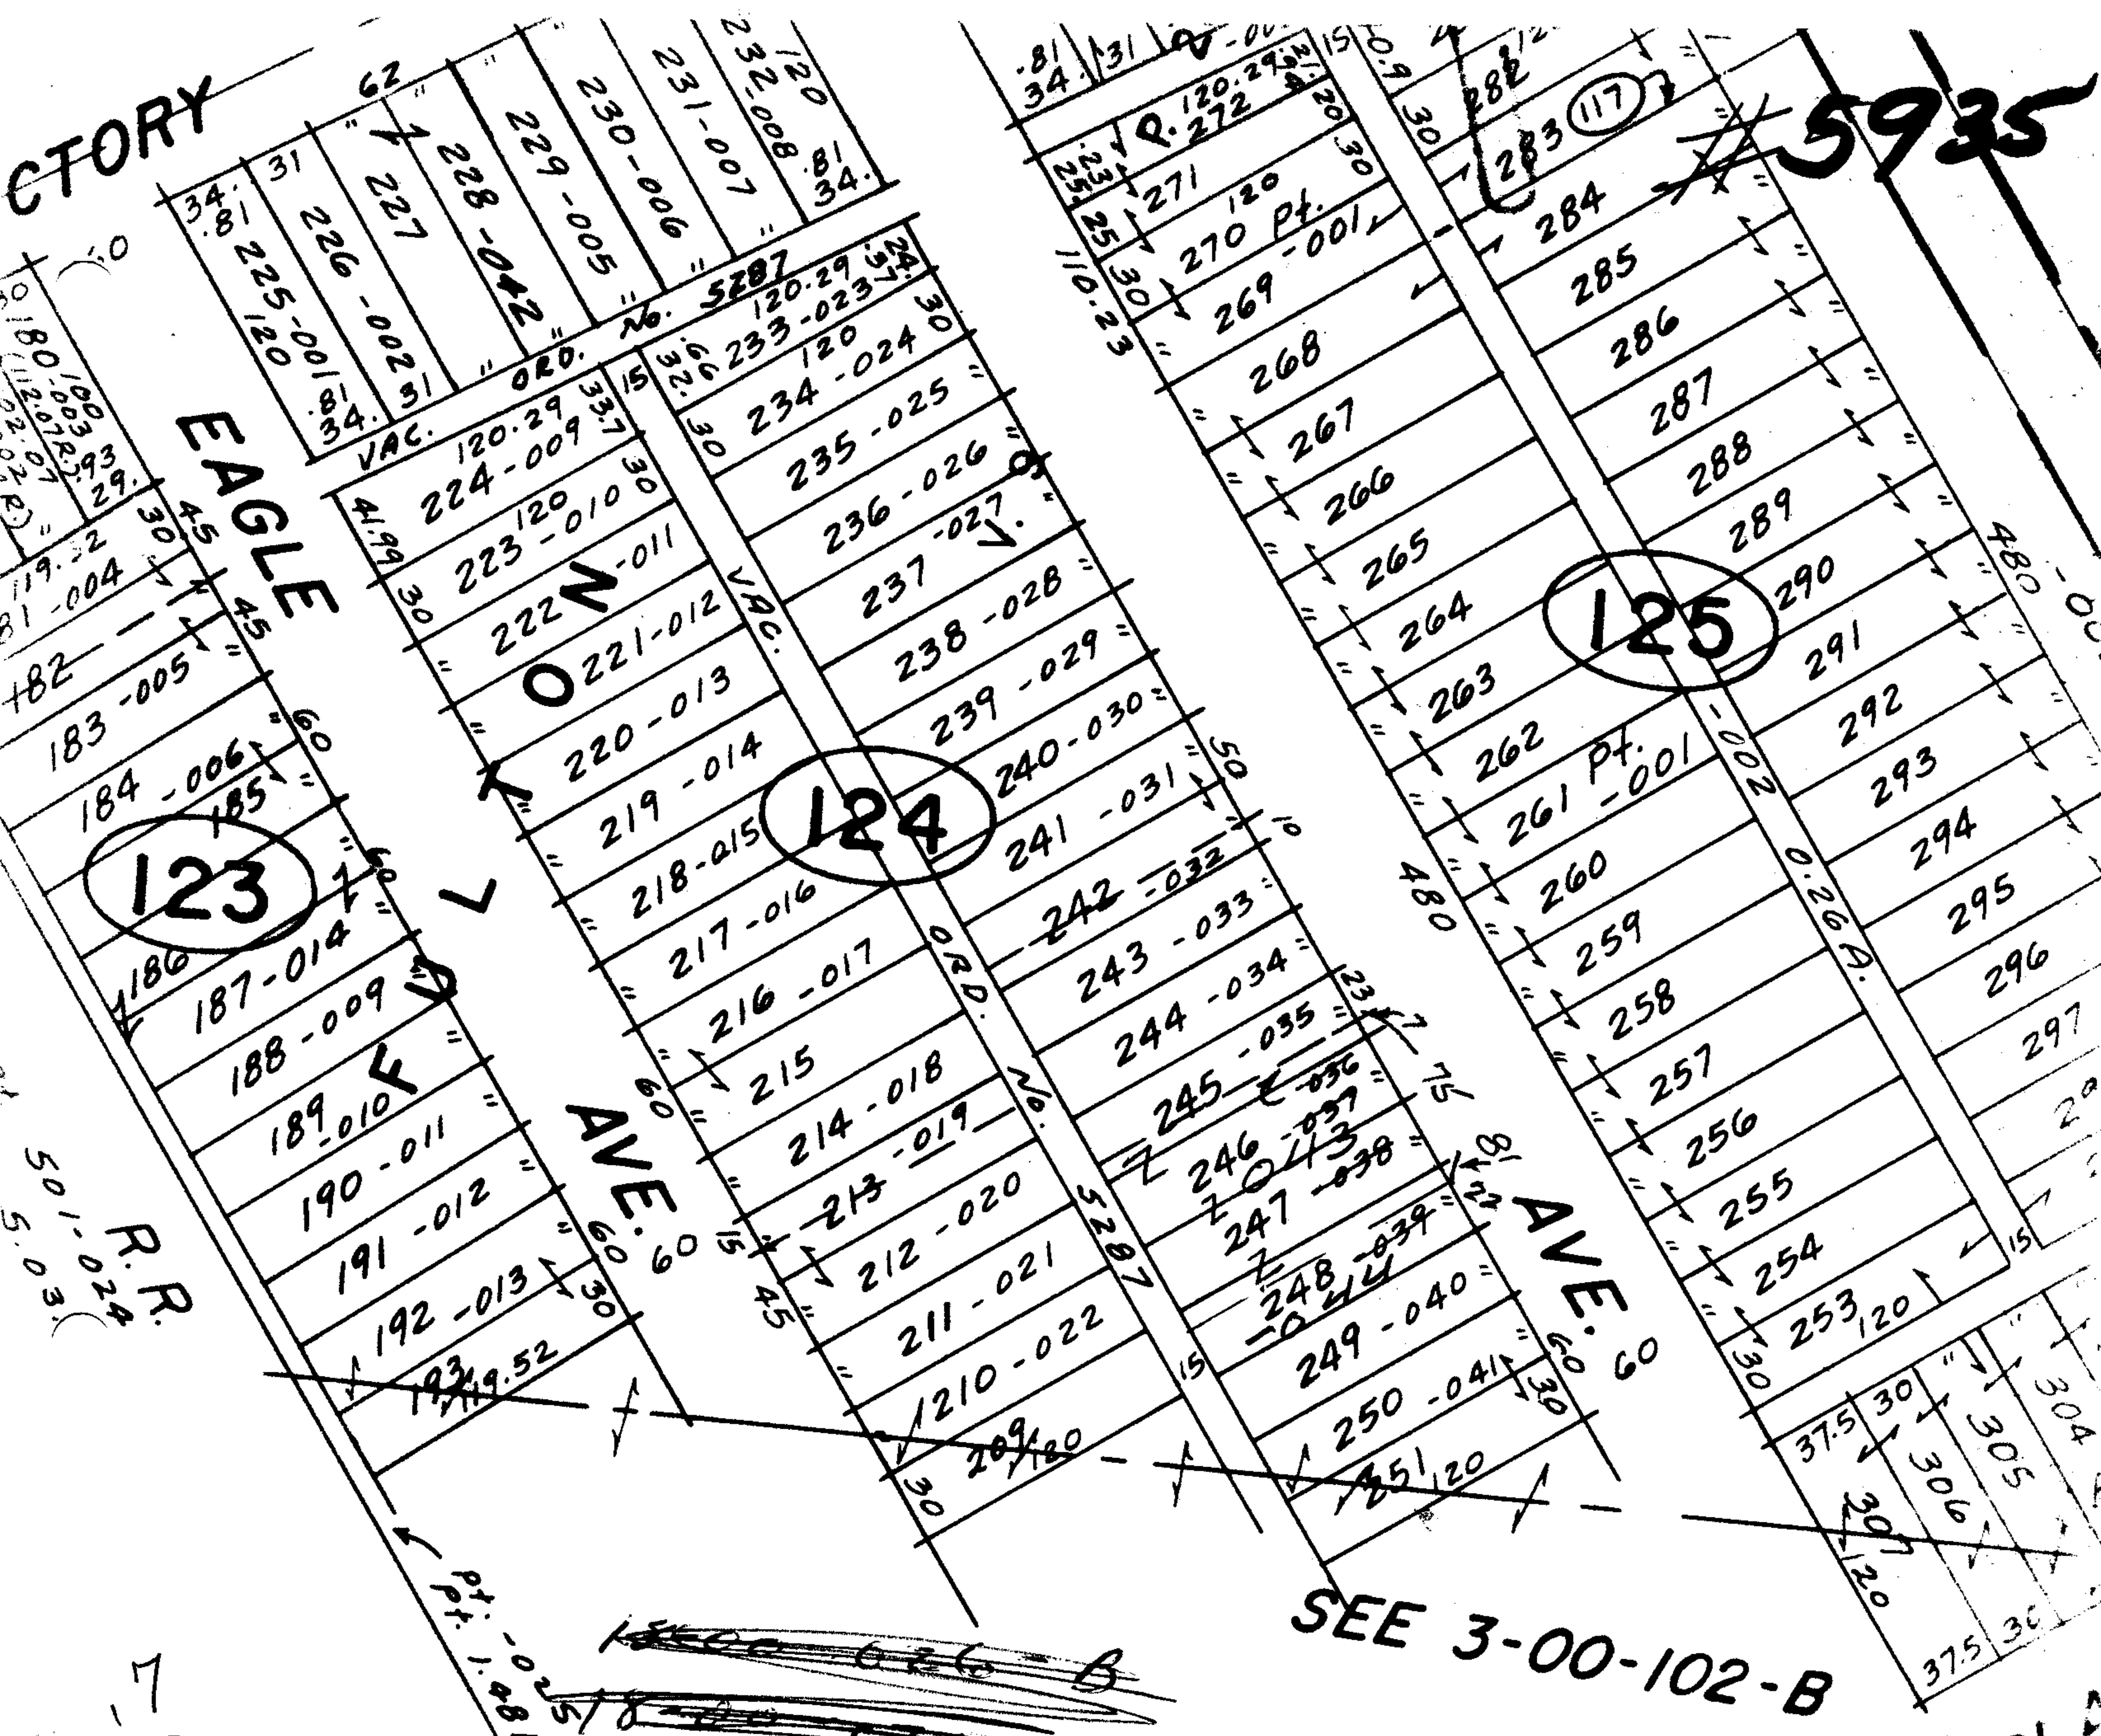

123

124

125

SEE 3-00-102-B

PLA

$$\begin{array}{r} 17 \\ 30 \\ 30 \\ \hline 151 \\ 82 \end{array}$$

7- 245
 30 246
 30 247
 8 248

 75



5935
 APPROVED
 LORAIN CO.
 MAP DEPT.
 DATE 6-5-72
 3-00-097B
 Lw Hall

7-2186
 5.5

EFFIELD TWP.

3-00-097 B

= 100'